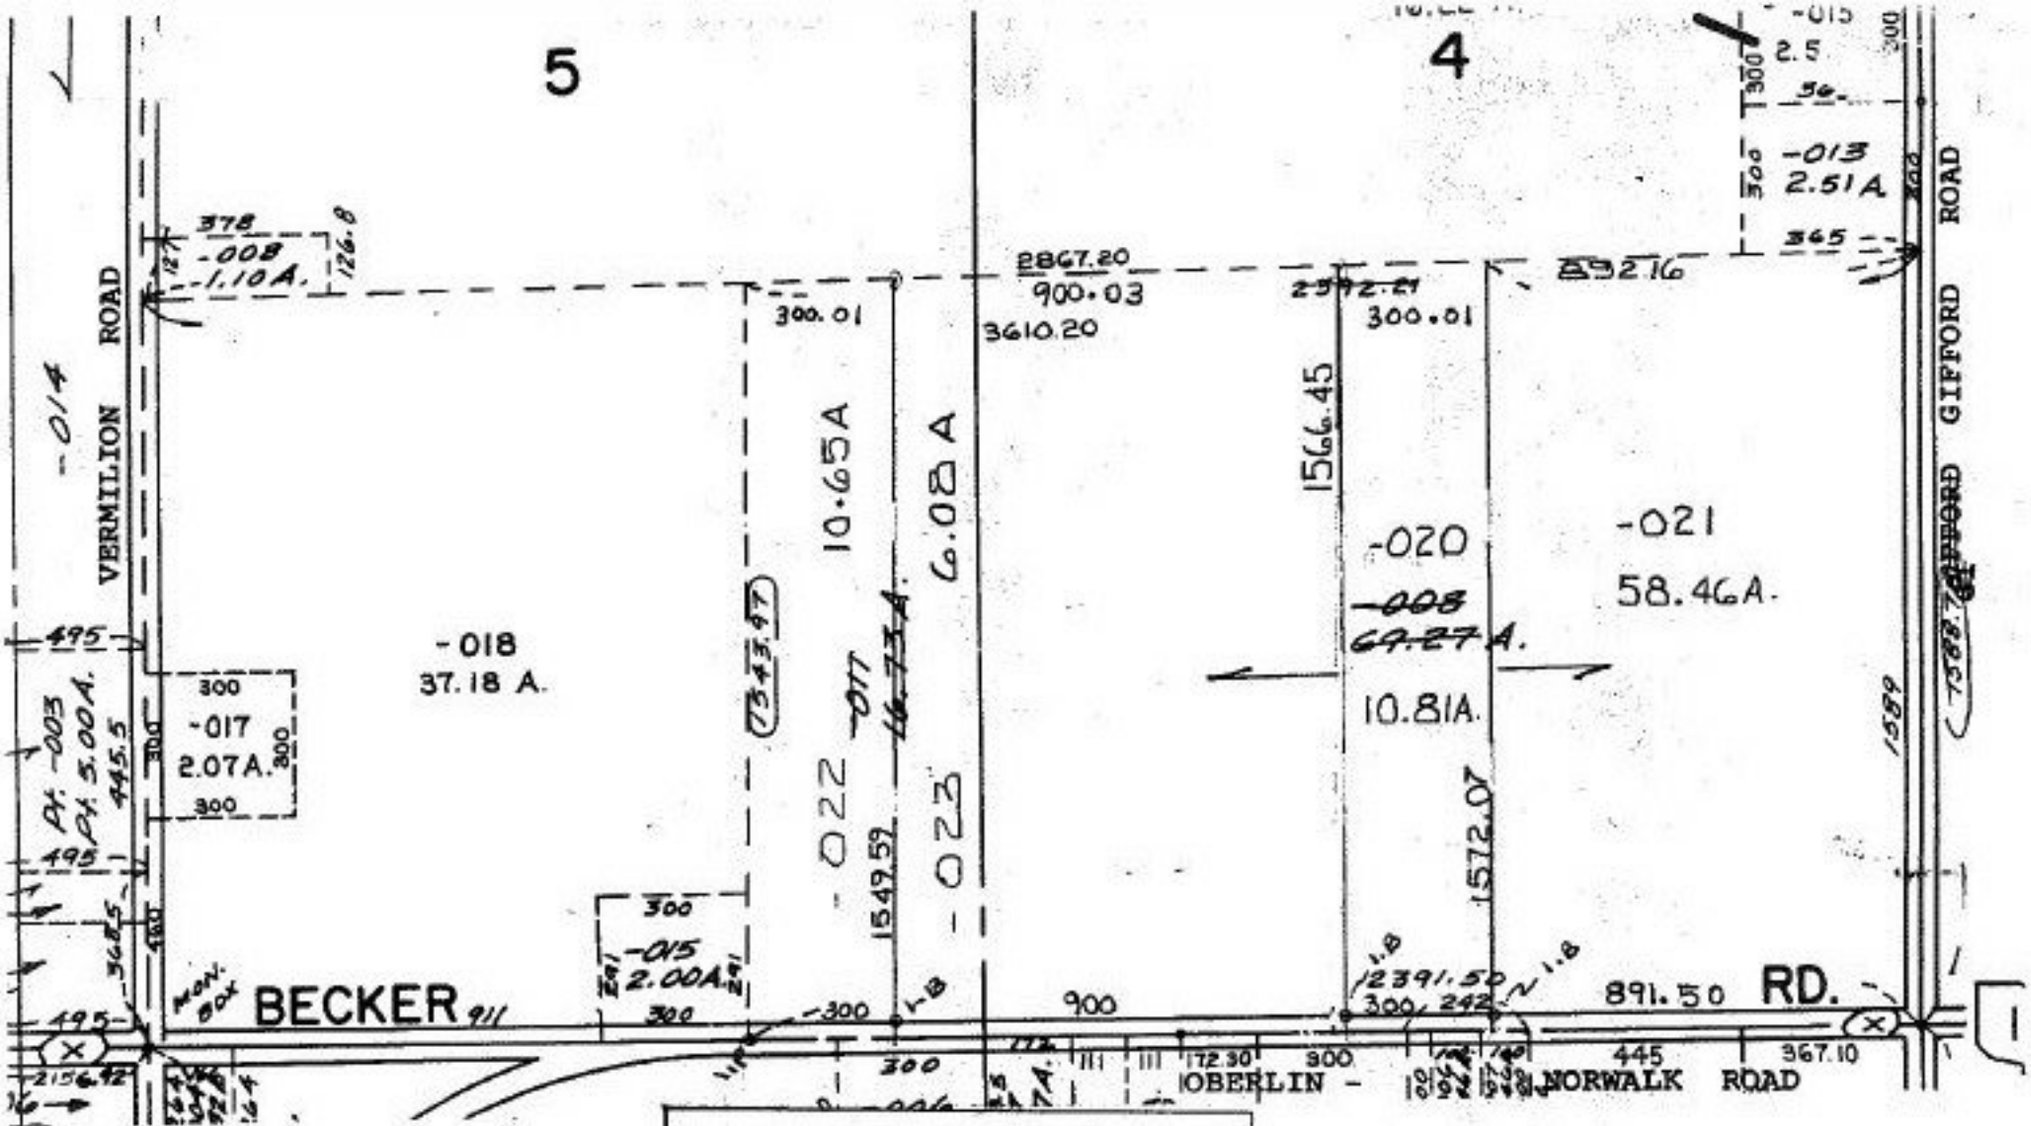

21411

APPROVED LORAIN CO. MAP DEPT
ATE 7-13-95
AGE 8-G
CAROLYN FRANCIS
21411

P.P.NO. 08-12-004-000-
08-12-005-000-
PRIOR INST: DV. 1381/130
CLOSURE: 10.81ac 1:INF.
10.65ac. 1:INF.
SURVEYED BY: EARL H. HUNTER
REG. SURVEYOR

21411