21418

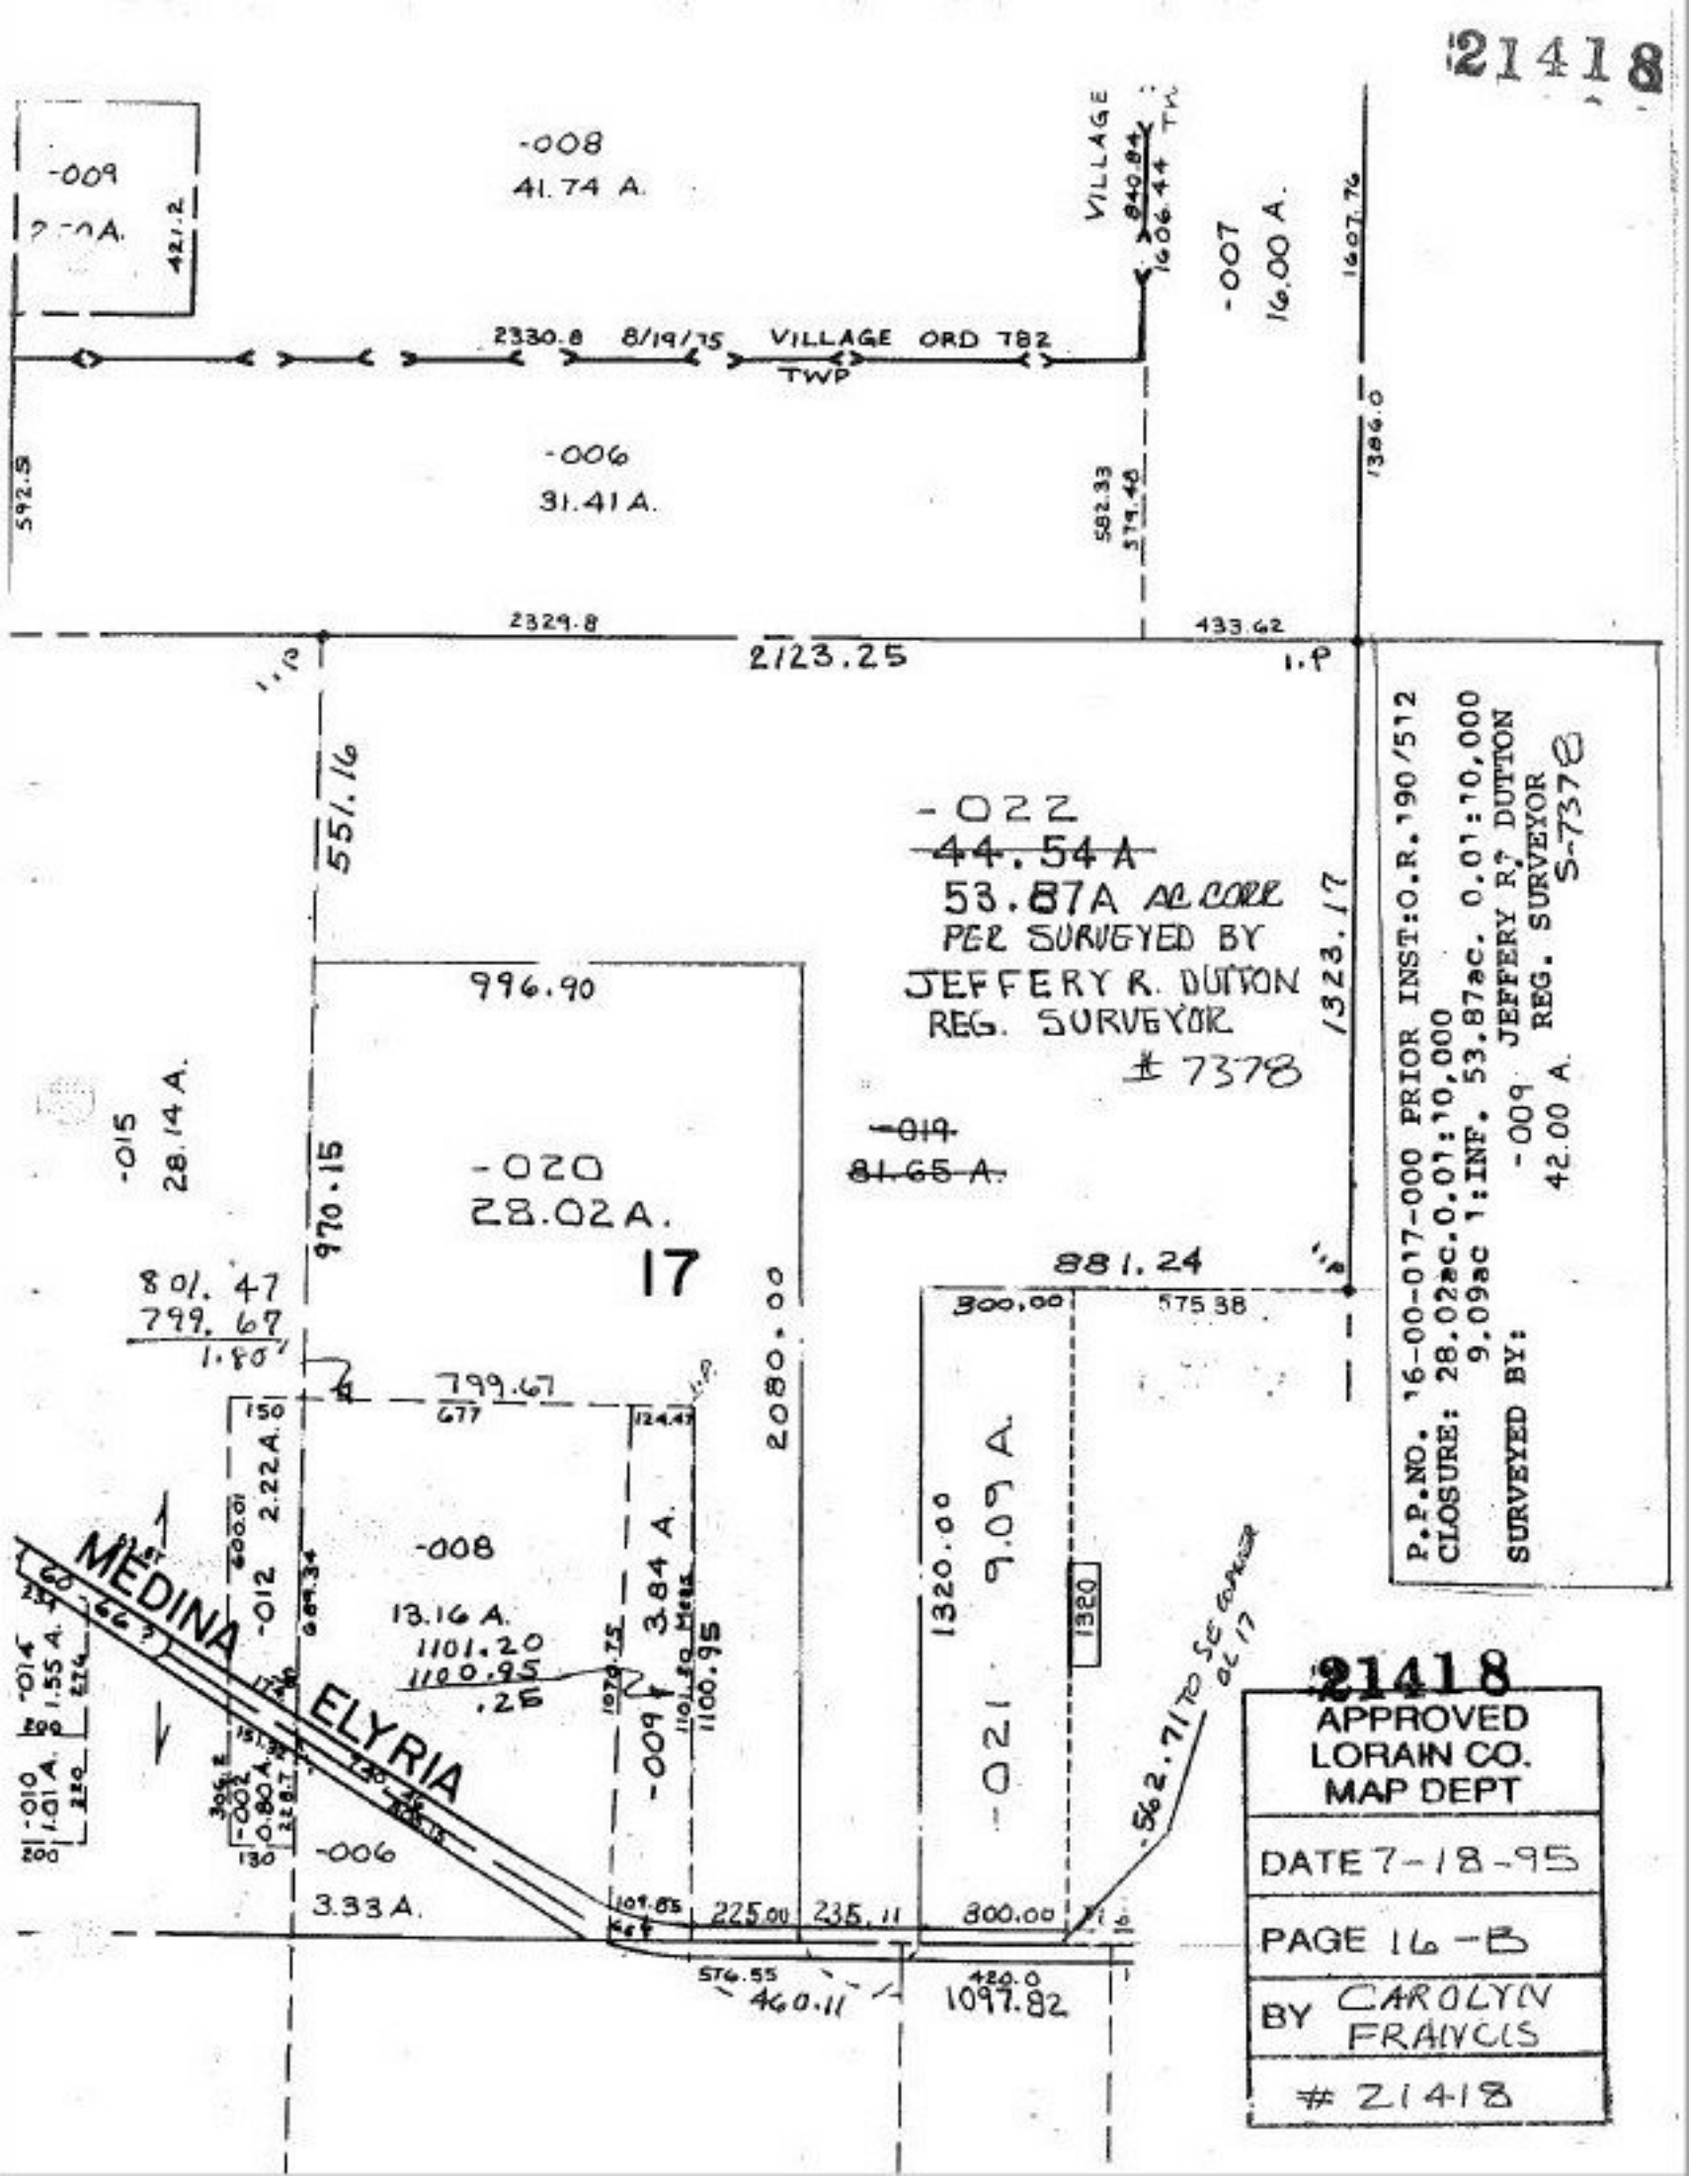

21418

APPROVED
LORAIN CO.
MAP DEPT

DATE 7-18-95

PAGE 16-B

BY CAROLYN FRANCIS

21418