21422

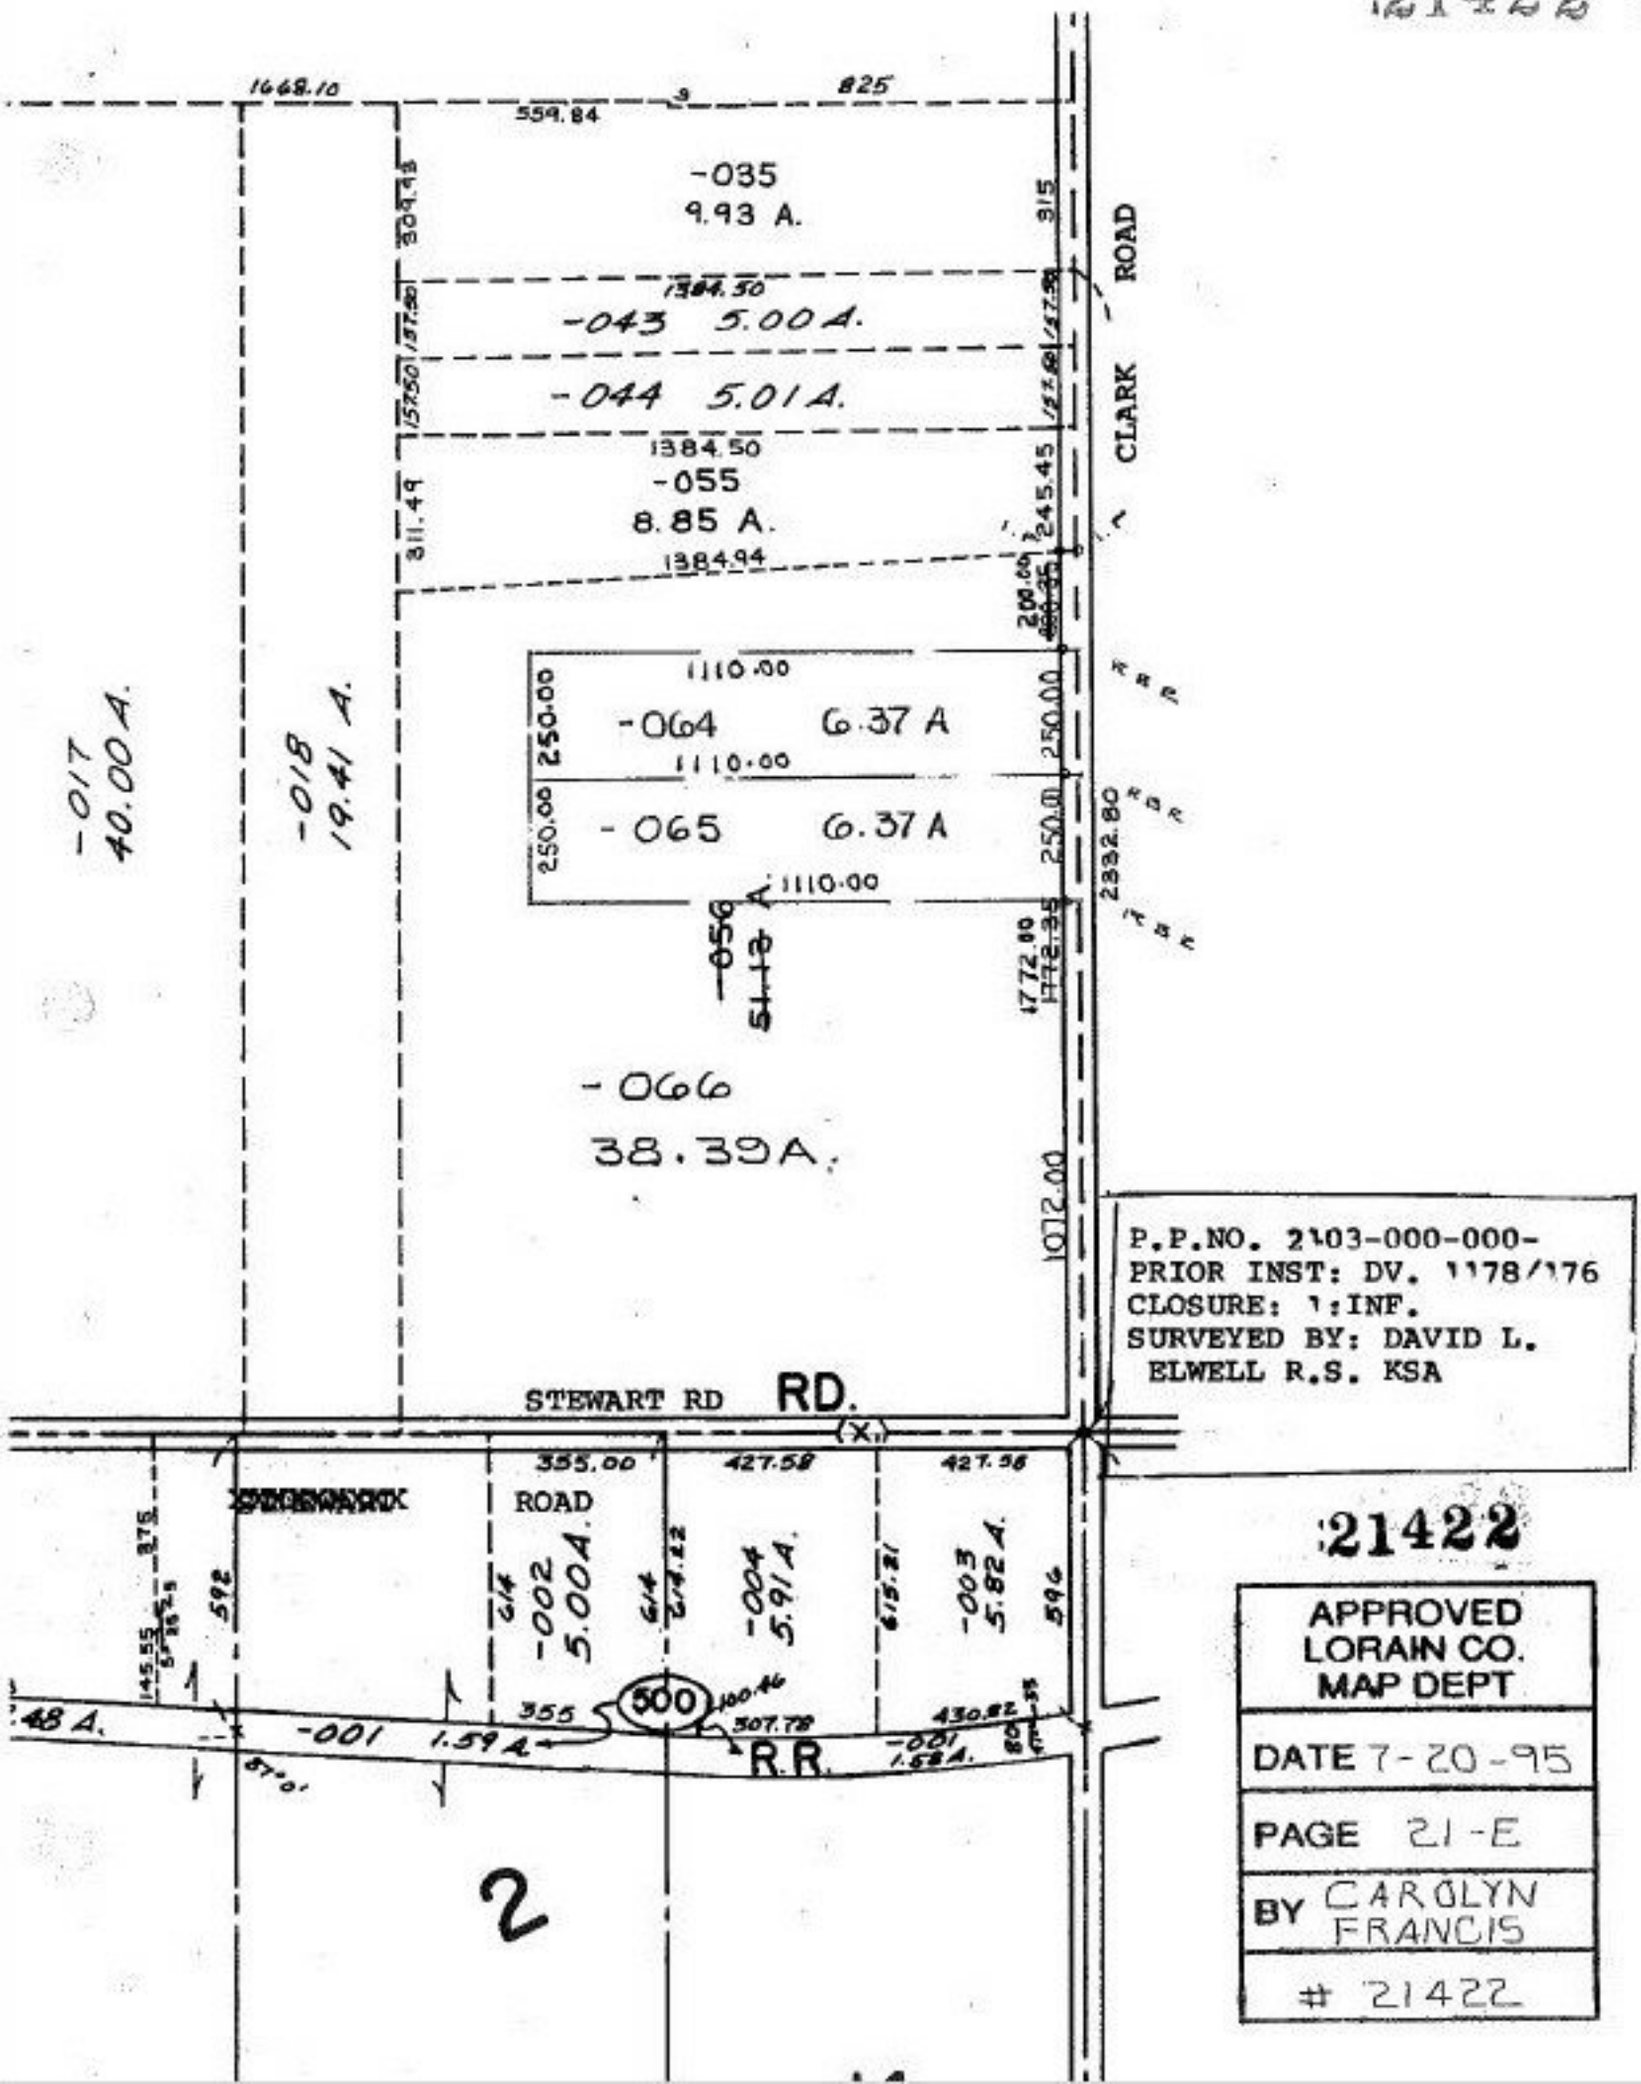

P.P.NO. 2103-000-000-
PRIOR INST: DV. 1178/176
CLOSURE: 1:INF.
SURVEYED BY: DAVID L.
ELWELL R.S. KSA

21422

APPROVED LORAIN CO. MAP DEPT
DATE 7-20-95
PAGE 21-E
BY CAROLYN FRANCIS
21422