#21423-A

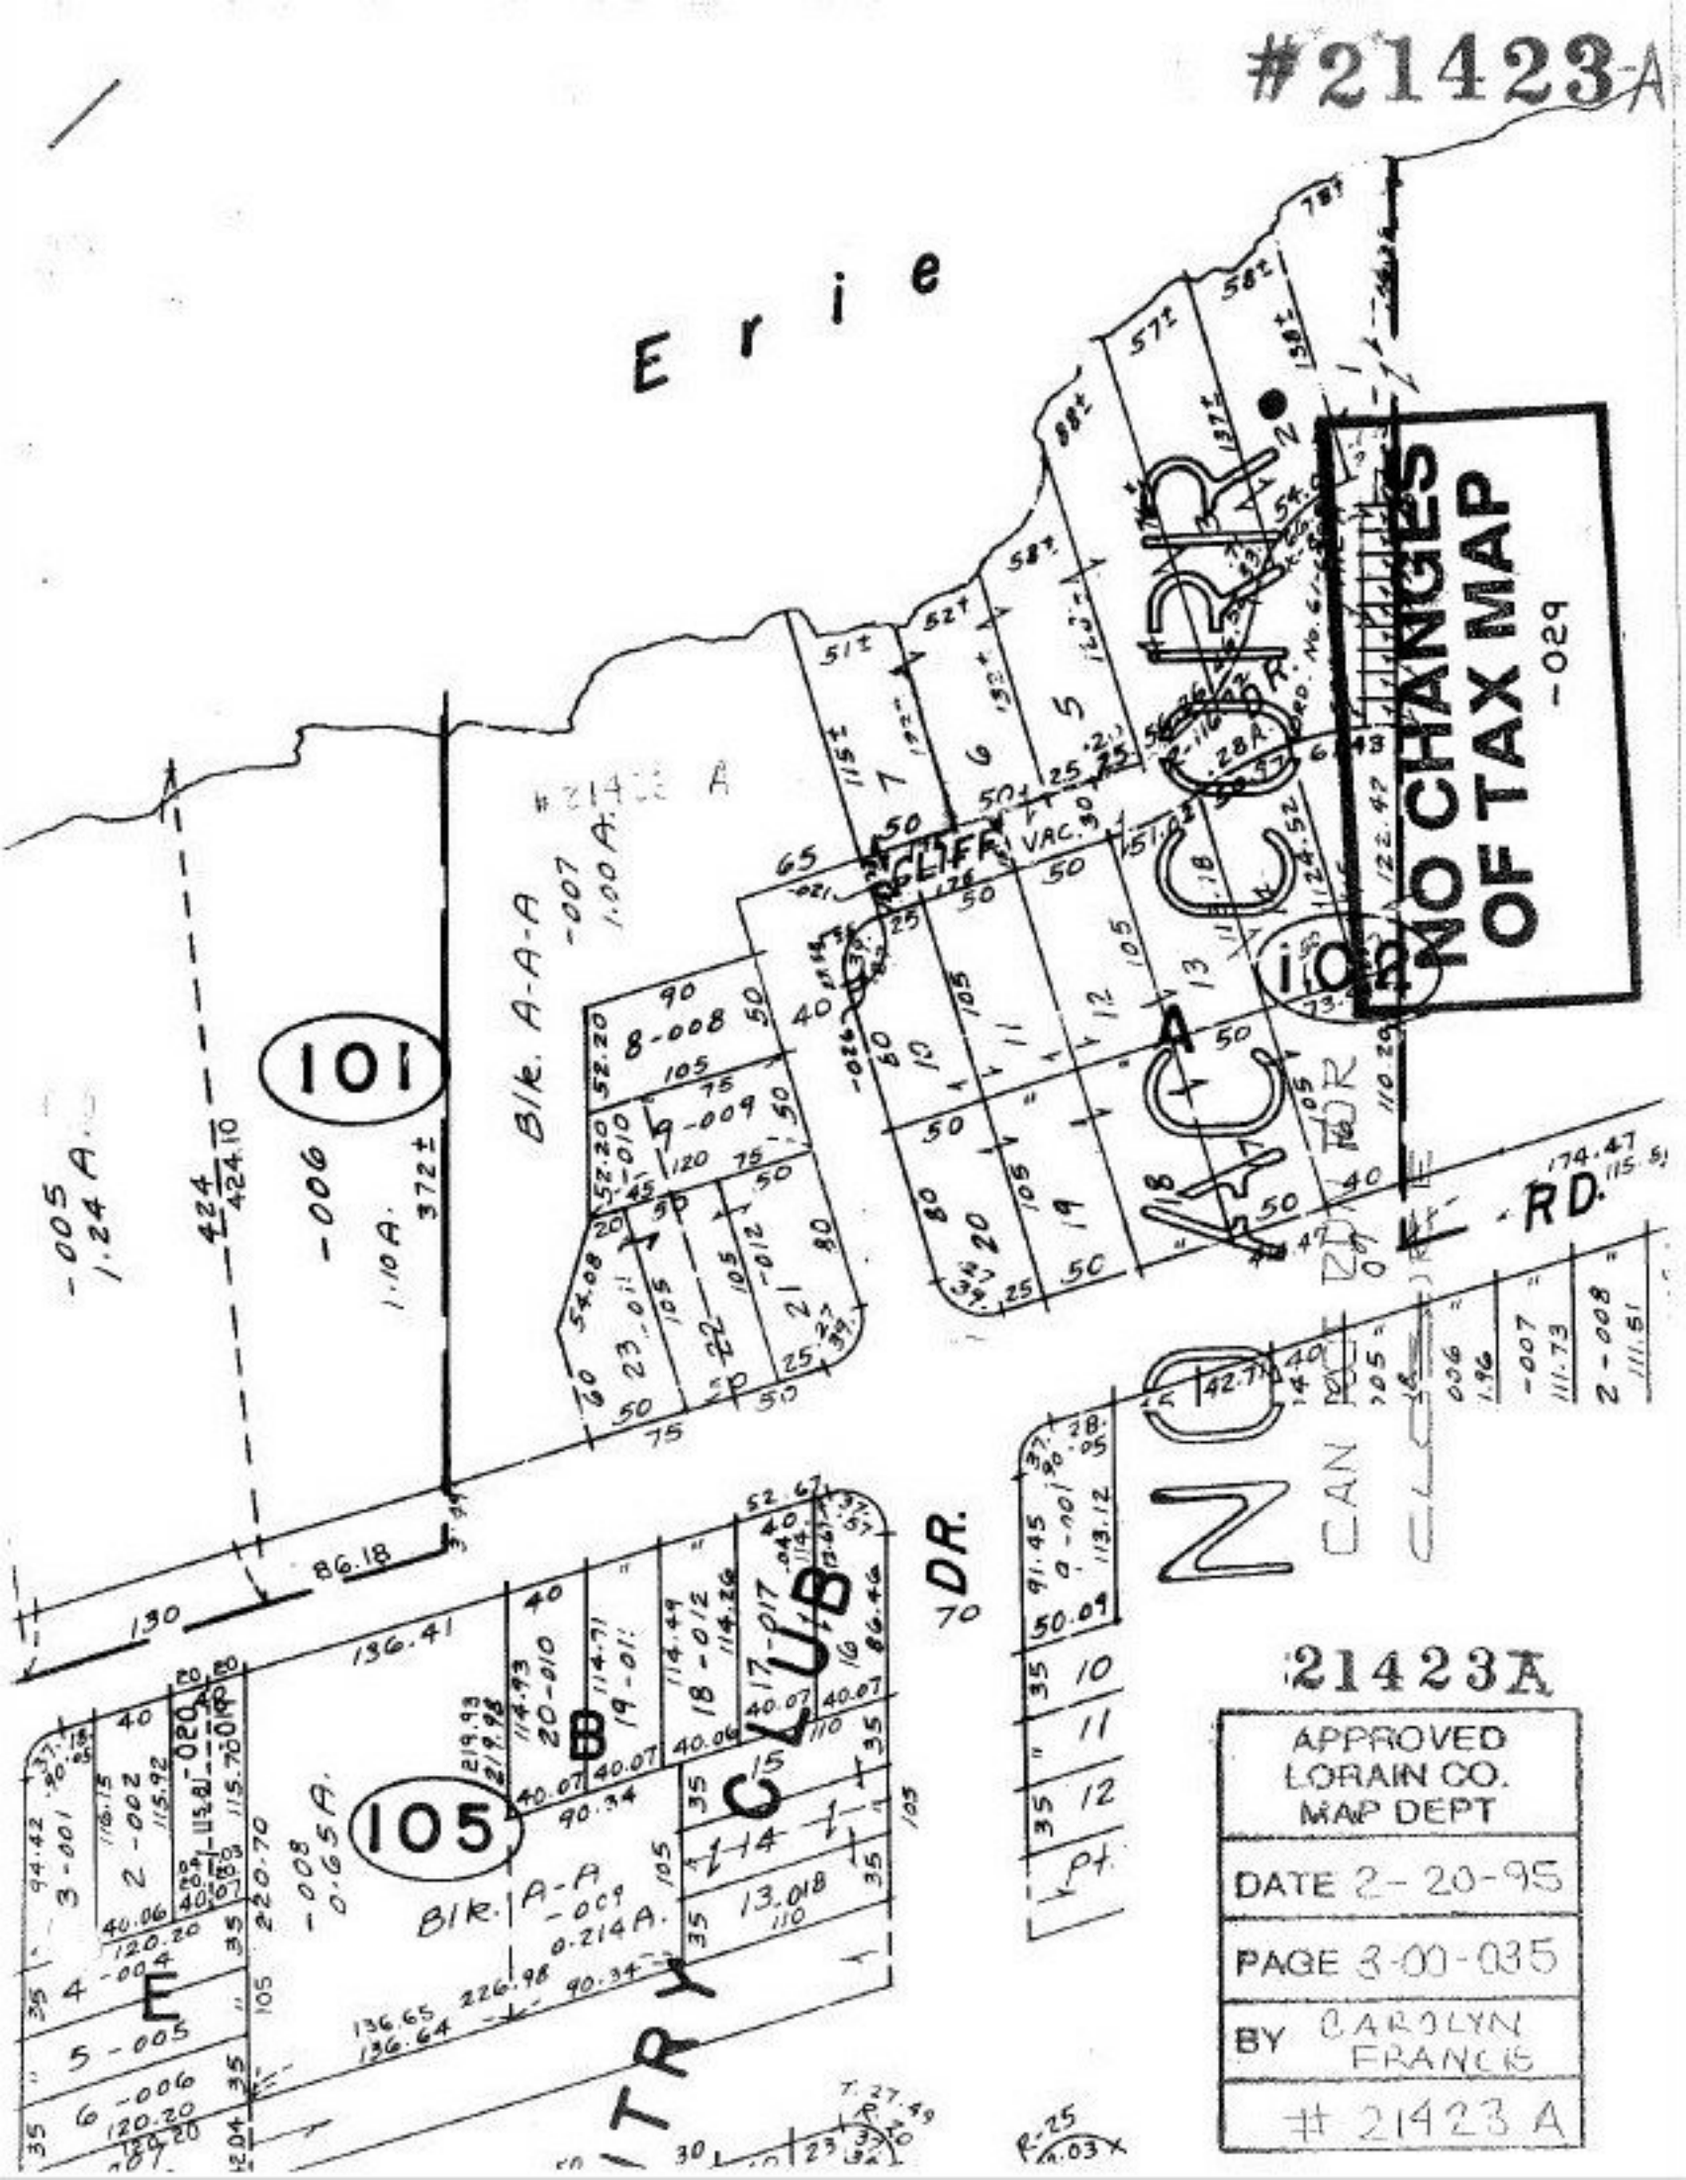

21423A

APPROVED LORAIN CO. MAP DEPT
DATE 2-20-95
PAGE 3-00-035
BY CAROLYN FRANCIS
21423 A