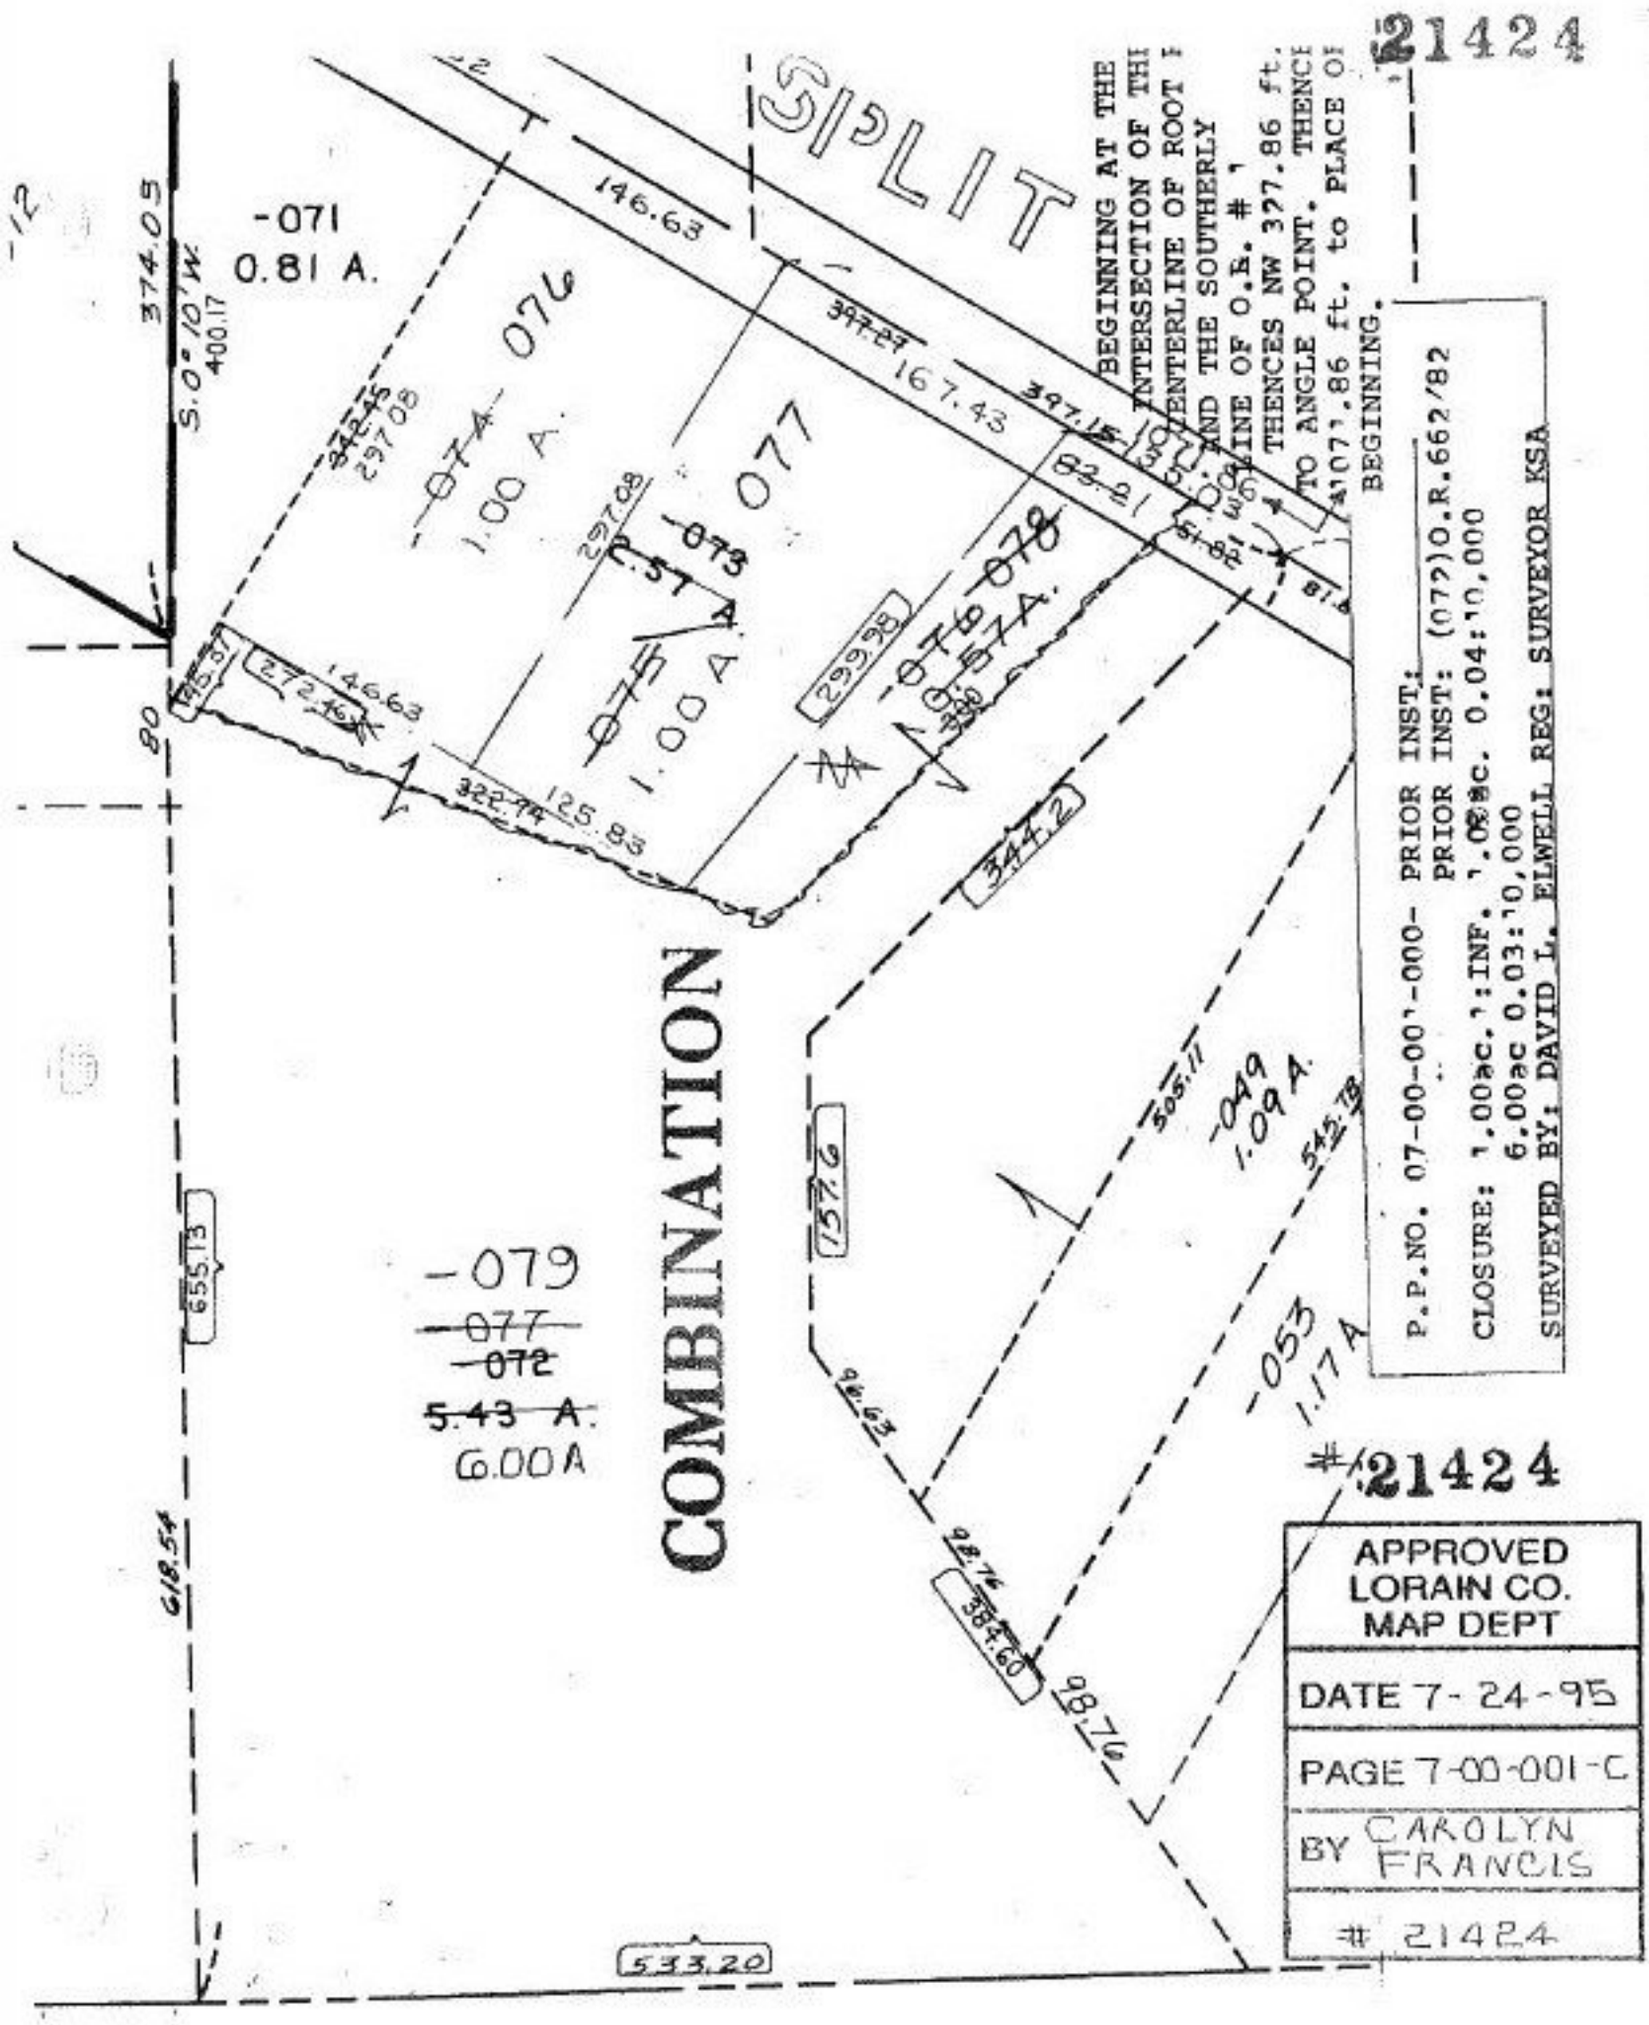
21424
SPLIT
COMBINATION
-071
0.81 A.
374.05
S.0°10'W.
400.17
146.63
397.27
167.43
397.15
83.21
-074 076
1.00 A.
-073
2.57 A.
-075
1.00 A.
-076 078
0.57 A.
297.08
299.98
272.46
322.74
125.83
344.2
157.6
505.11
-049
1.09 A.
545.78
-053
1.17 A
-079
-077
-072
5.43 A.
6.00 A
655.13
618.54
96.63
98.76
384.60
533.20
BEGINNING AT THE INTERSECTION OF THE CENTERLINE OF ROOT AND THE SOUTHERLY LINE OF O.R. # 1 THENCES NW 327.86 ft. TO ANGLE POINT. THENCE 1071.86 ft. to PLACE OF BEGINNING.
P.P.NO. 07-00-001-000- PRIOR INST:
PRIOR INST: (072)O.R.662/82
CLOSURE: 1.00ac.1:INF. 1.00ac. 0.04:10,000
6.00ac 0.03:10,000
SURVEYED BY: DAVID L. ELWELL REG: SURVEYOR KSA
#21424
APPROVED
LORAIN CO.
MAP DEPT
DATE 7-24-95
PAGE 7-00-001-C
BY CAROLYN FRANCIS
21424