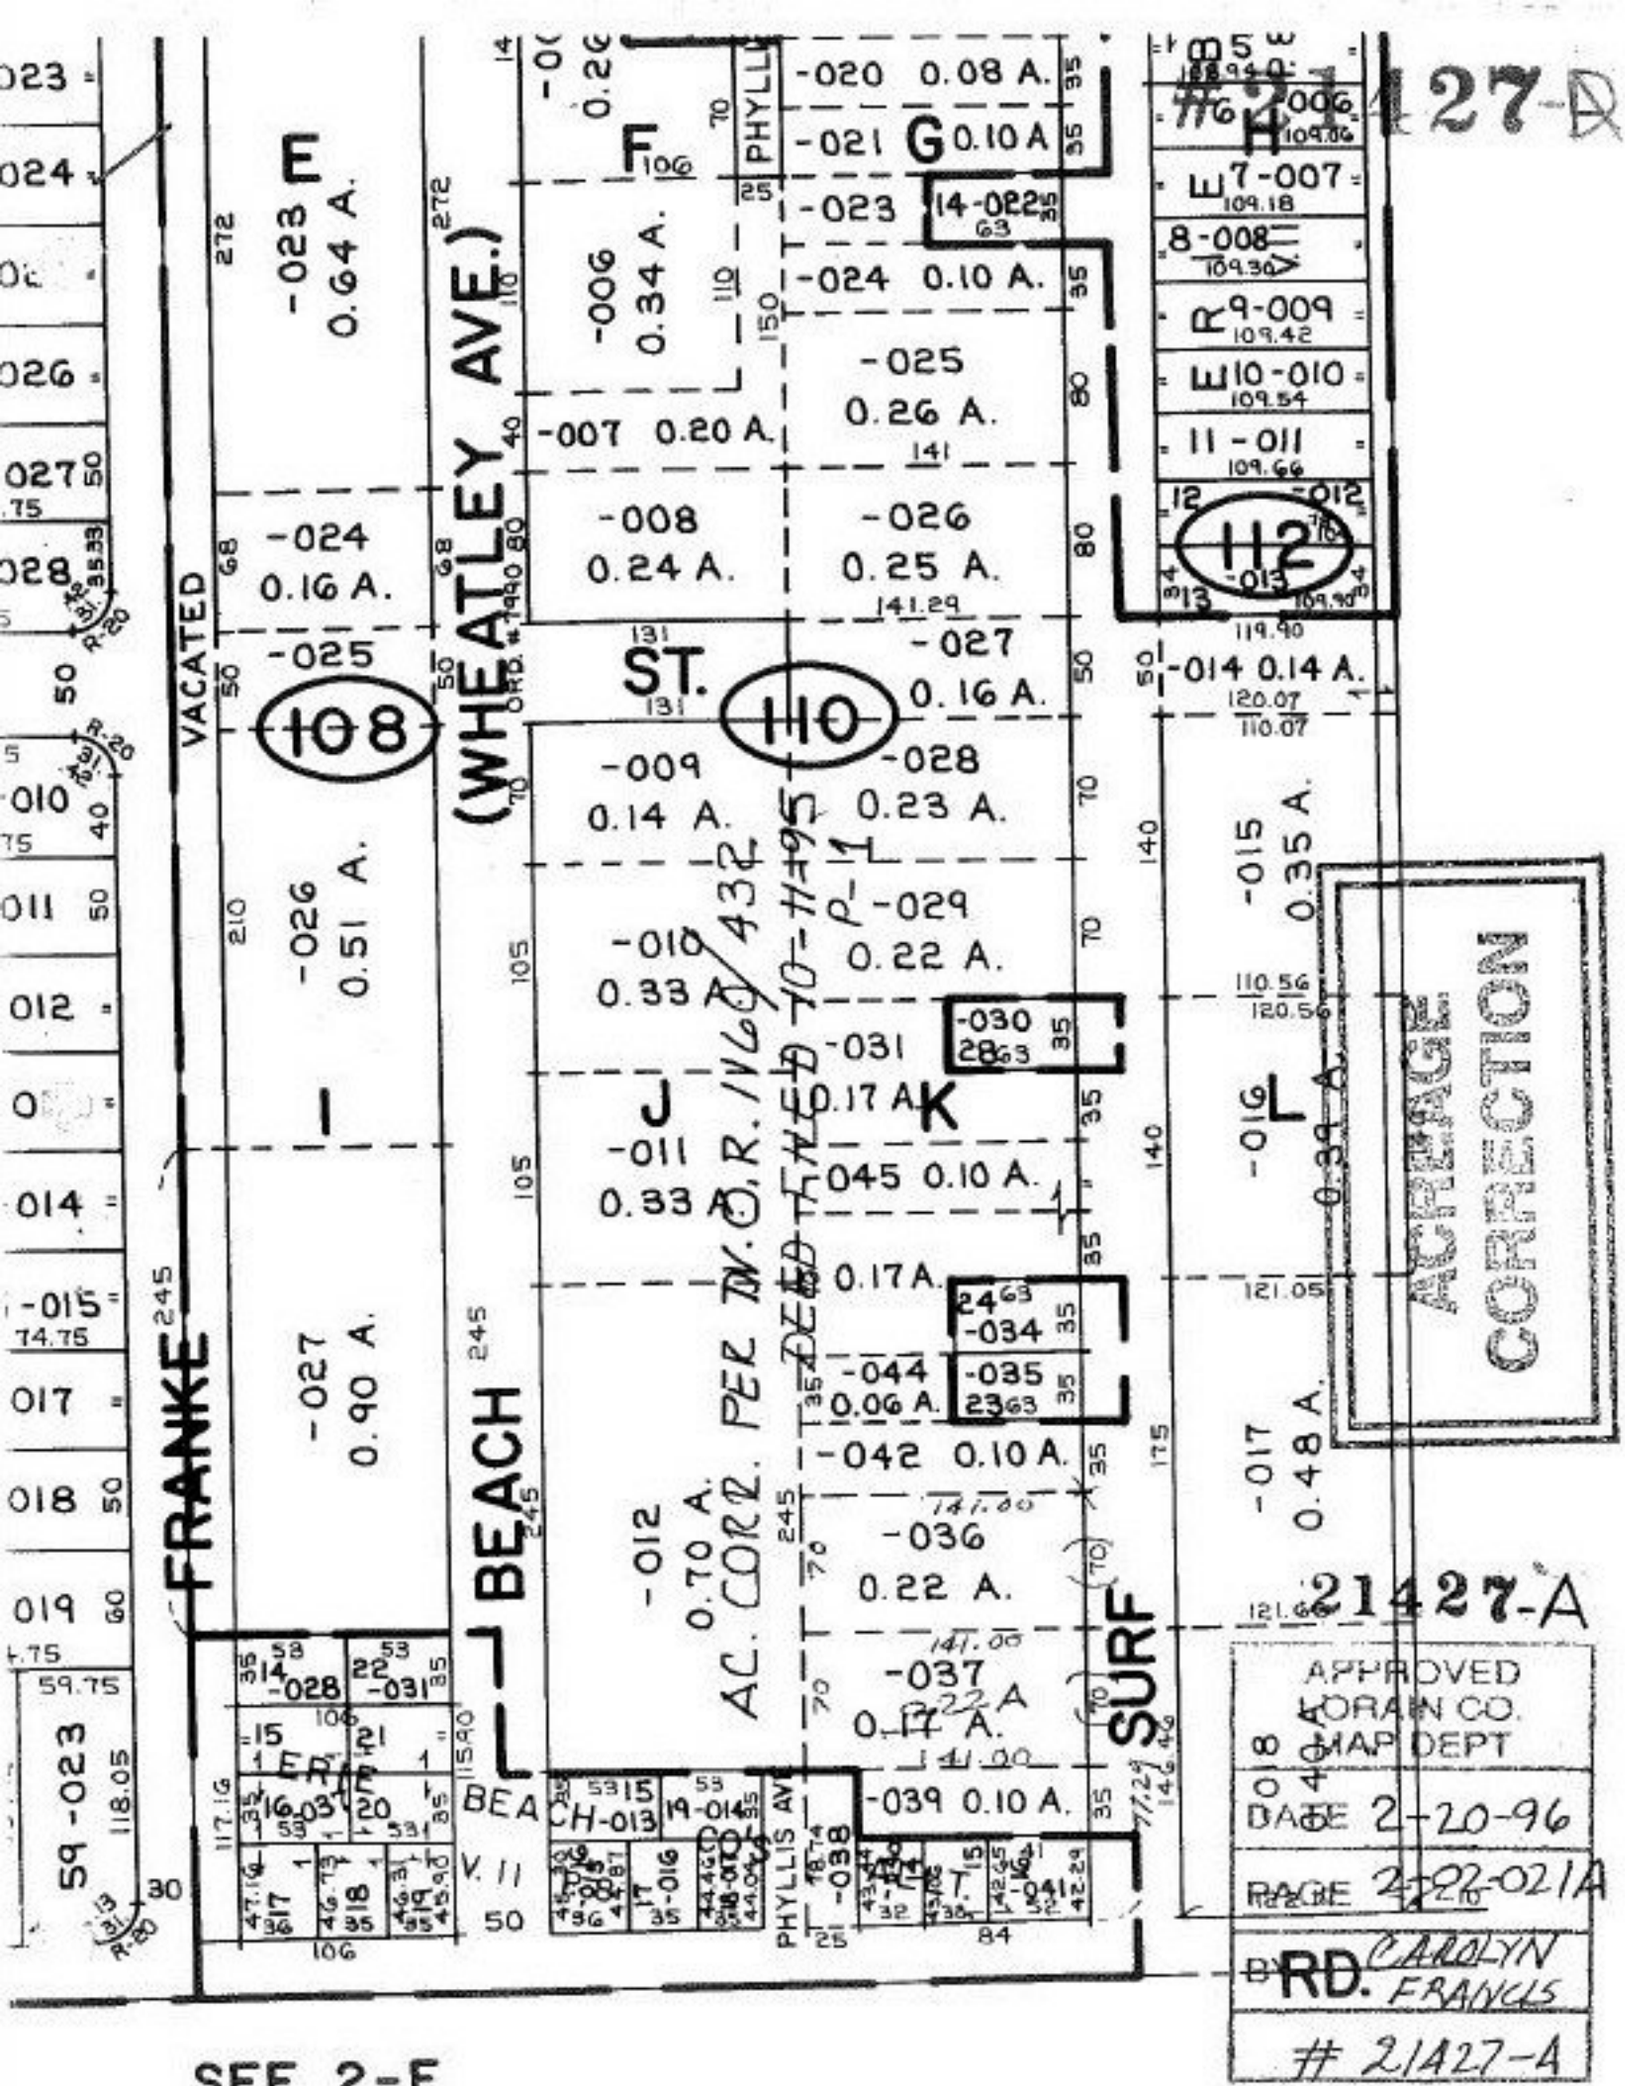
#21427-A
FRANKE
BEACH
SURF
VACATED
(WHEATLEY AVE.)
ST.
108
110
112
PHYLLIS AVE
-023 E 0.64 A.
-024 0.16 A.
-025
-026 0.51 A.
-027 0.90 A.
-006 0.34 A.
-007 0.20 A.
-008 0.24 A.
-009 0.14 A.
-010 0.33 A.
-011 0.33 A.
-012 0.70 A.
-020 0.08 A.
-021 G 0.10 A
-023
-024 0.10 A.
-025 0.26 A.
-026 0.25 A.
-027 0.16 A.
-028 0.23 A.
-029 0.22 A.
-030
-031 0.17 A K
045 0.10 A.
0.17 A.
-034
-035
-044 0.06 A.
-042 0.10 A.
-036 0.22 A.
-037 0.17 A.
-039 0.10 A.
-014 0.14 A.
-015 0.35 A.
-016 0.39 A.
-017 0.48 A.
E 7-007
8-008
R 9-009
E 10-010
11-011
-012
-013
14-022
-038
-041
AC. CORR. PER M.O.R. 1160/432 DEED TIED TO 11-11-95 P-11
ACREAGE CORRECTION
APPROVED LORAIN CO. MAP DEPT
DATE 2-20-96
PAGE 2-22-02A
BY RD. CAROLYN FRANCIS
21427-A
SEE 2-F