21438

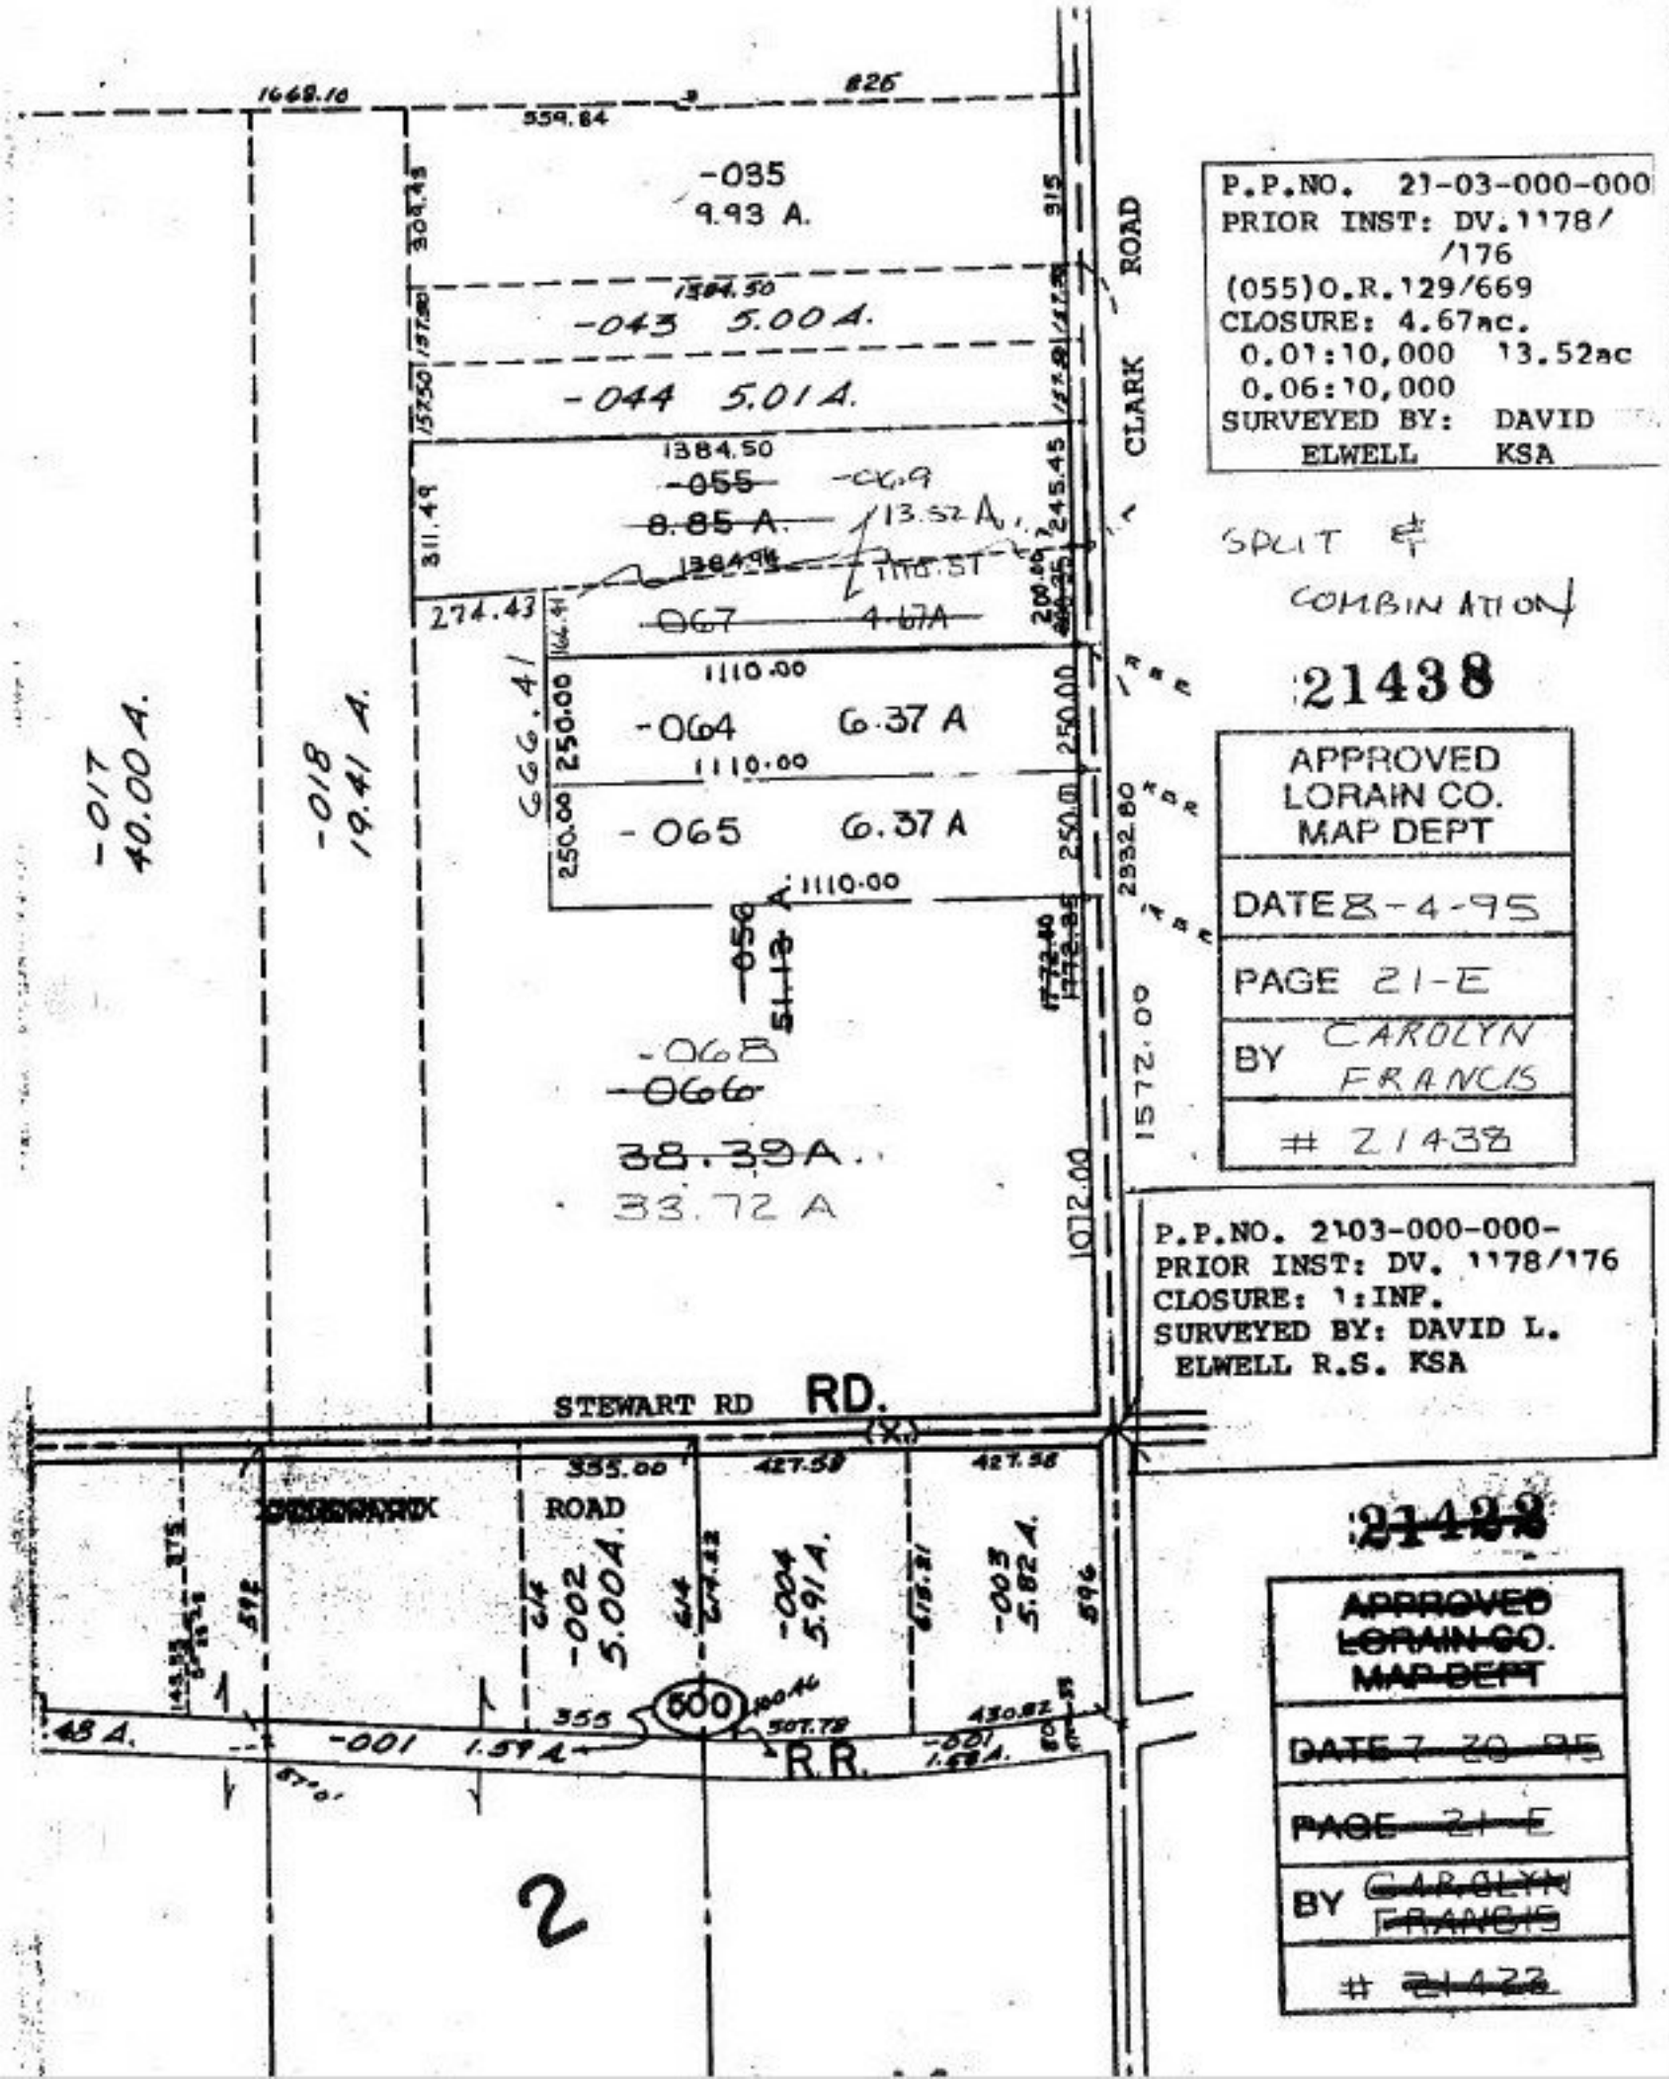

P.P.NO. 21-03-000-000
PRIOR INST: DV.1178/
/176
(055)O.R.129/669
CLOSURE: 4.67ac.
0.01:10,000 13.52ac
0.06:10,000
SURVEYED BY: DAVID
ELWELL KSA

SPLIT & COMBINATION

21438

APPROVED
LORAIN CO.
MAP DEPT

DATE 8-4-95

PAGE 21-E

BY CAROLYN
FRANCIS

21438

P.P.NO. 2103-000-000-
PRIOR INST: DV. 1178/176
CLOSURE: 1:INF.
SURVEYED BY: DAVID L.
ELWELL R.S. KSA

~~21438~~

~~APPROVED
LORAIN CO.
MAP DEPT~~

~~DATE 7-20-95~~

~~PAGE 21-E~~

BY ~~CAROLYN
FRANCIS~~

~~21438~~