21439

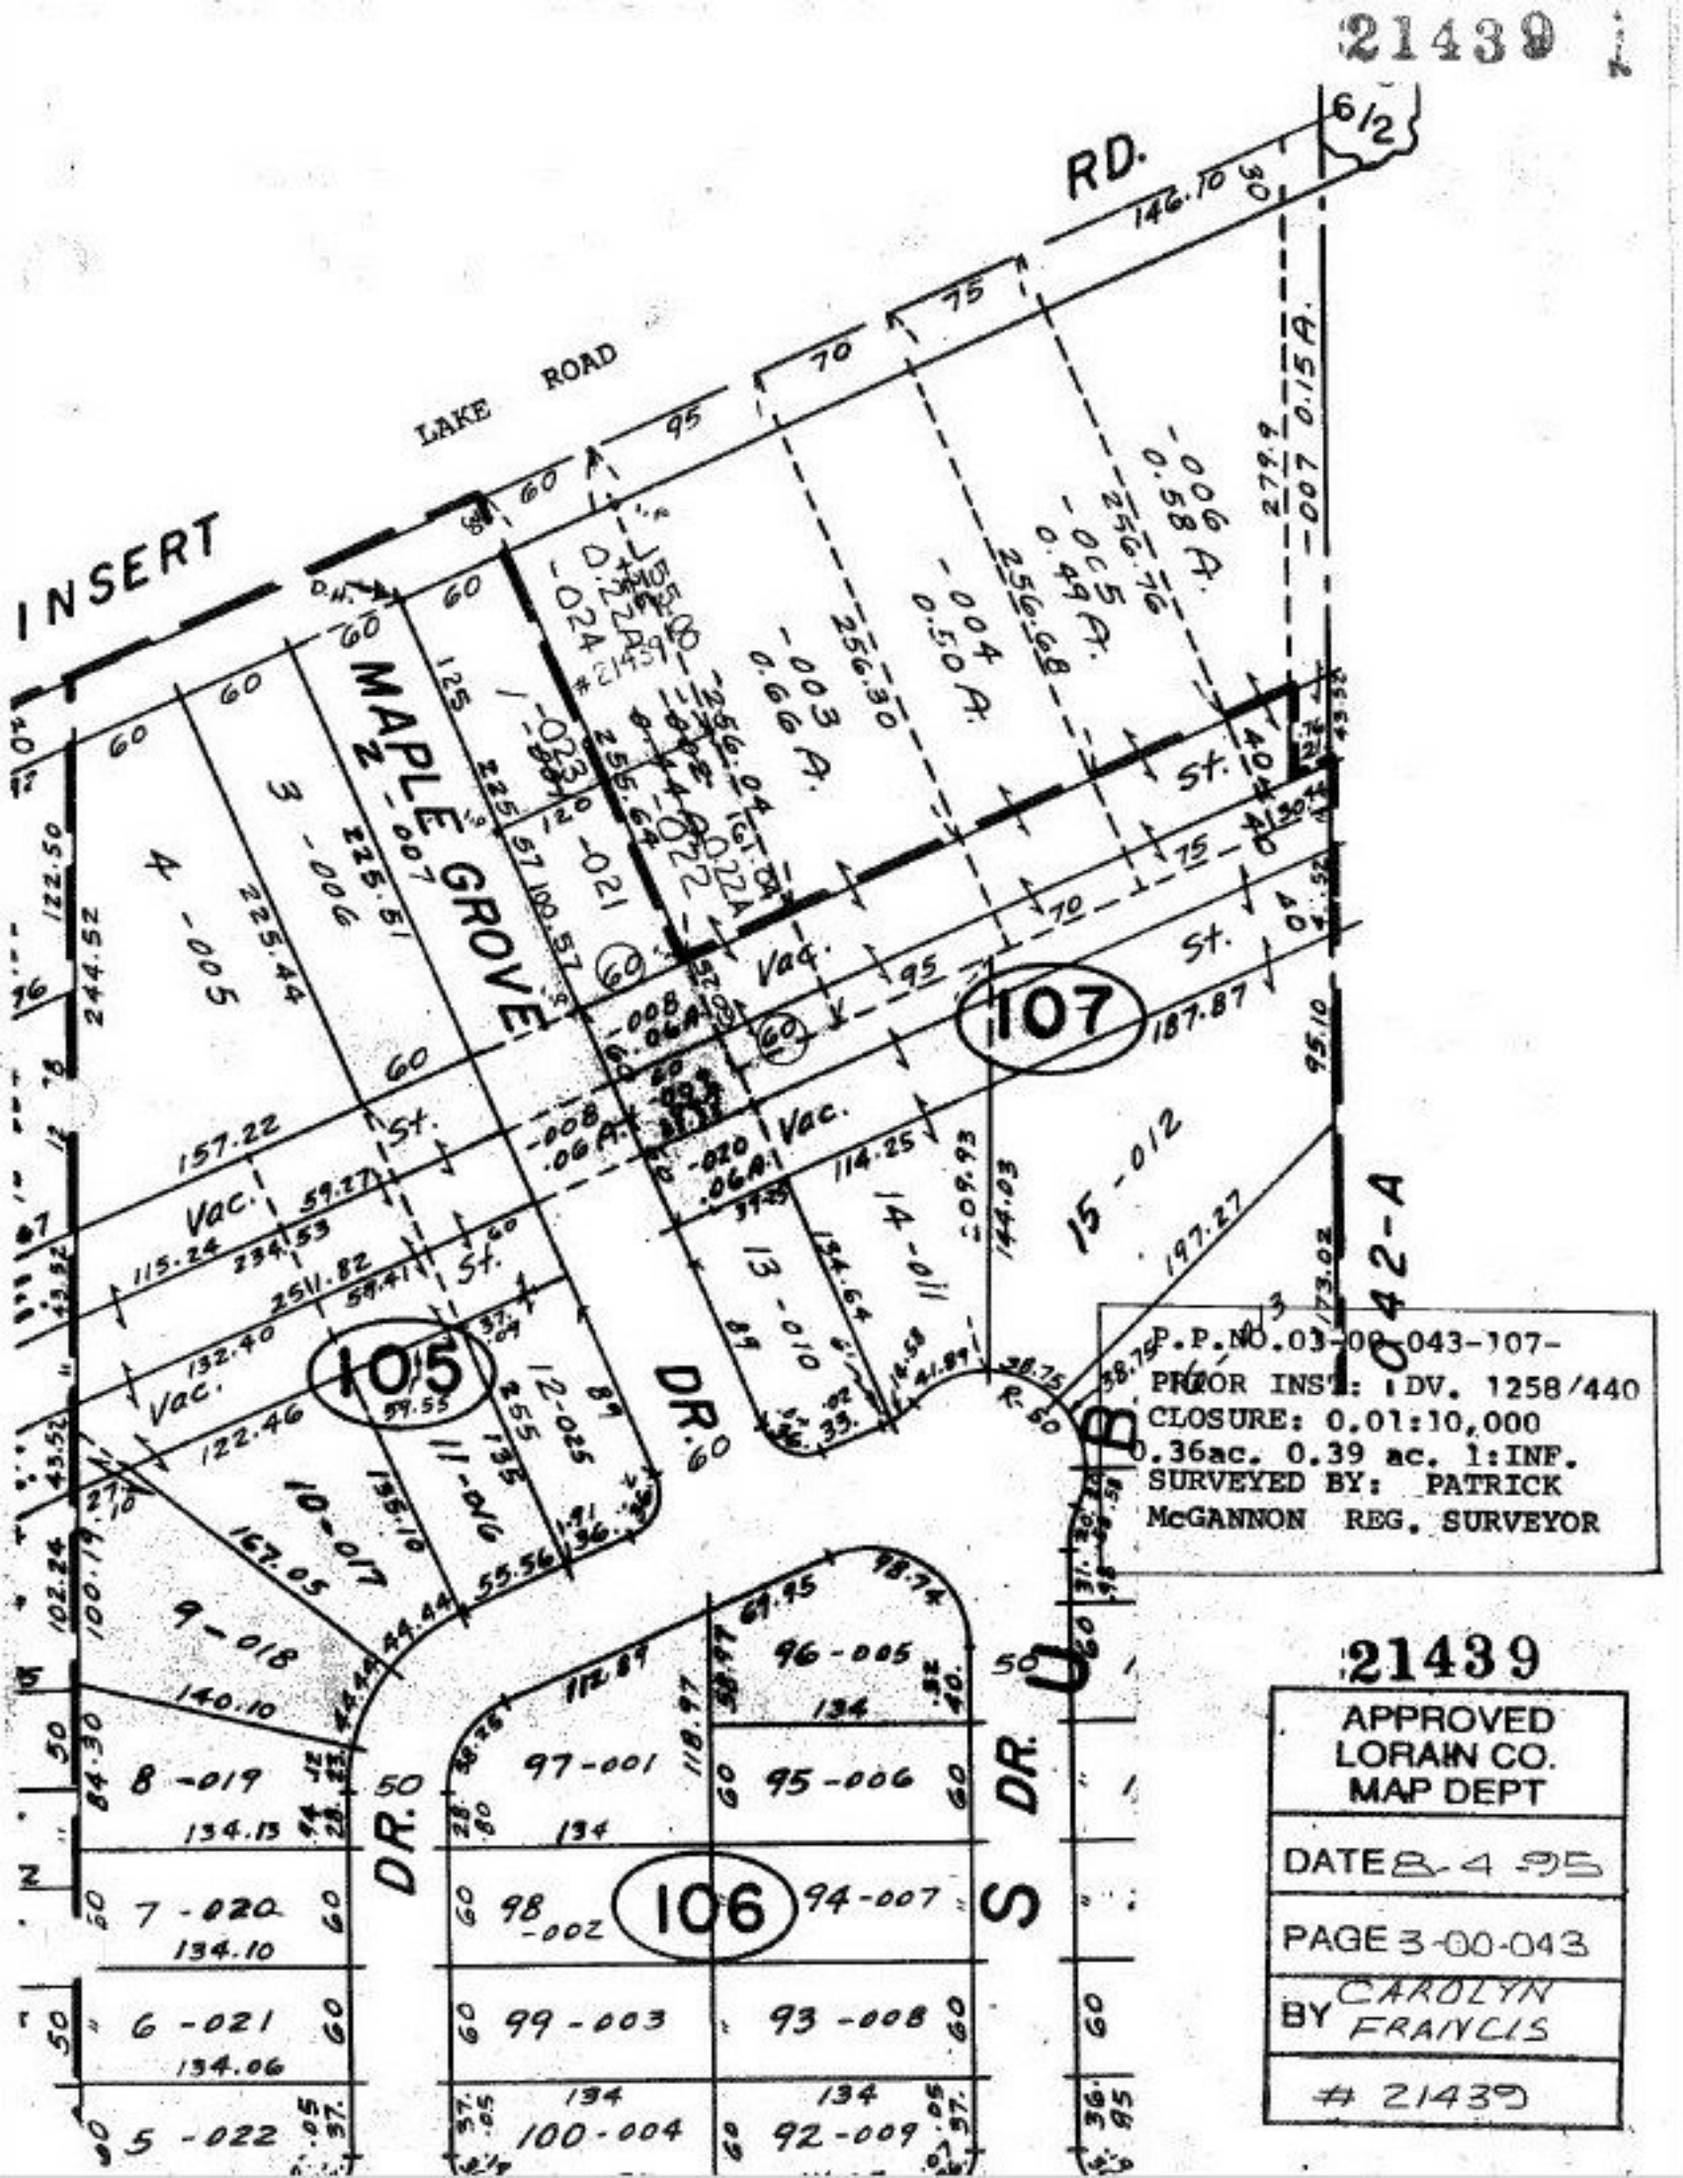

P.P.NO.03-00-043-107-
PRIOR INST: DV. 1258/440
CLOSURE: 0.01:10,000
0.36ac. 0.39 ac. 1:INF.
SURVEYED BY: PATRICK
McGANNON REG. SURVEYOR

21439

APPROVED LORAIN CO. MAP DEPT
DATE 8-4-95
PAGE 3-00-043
BY CAROLYN FRANCIS
21439