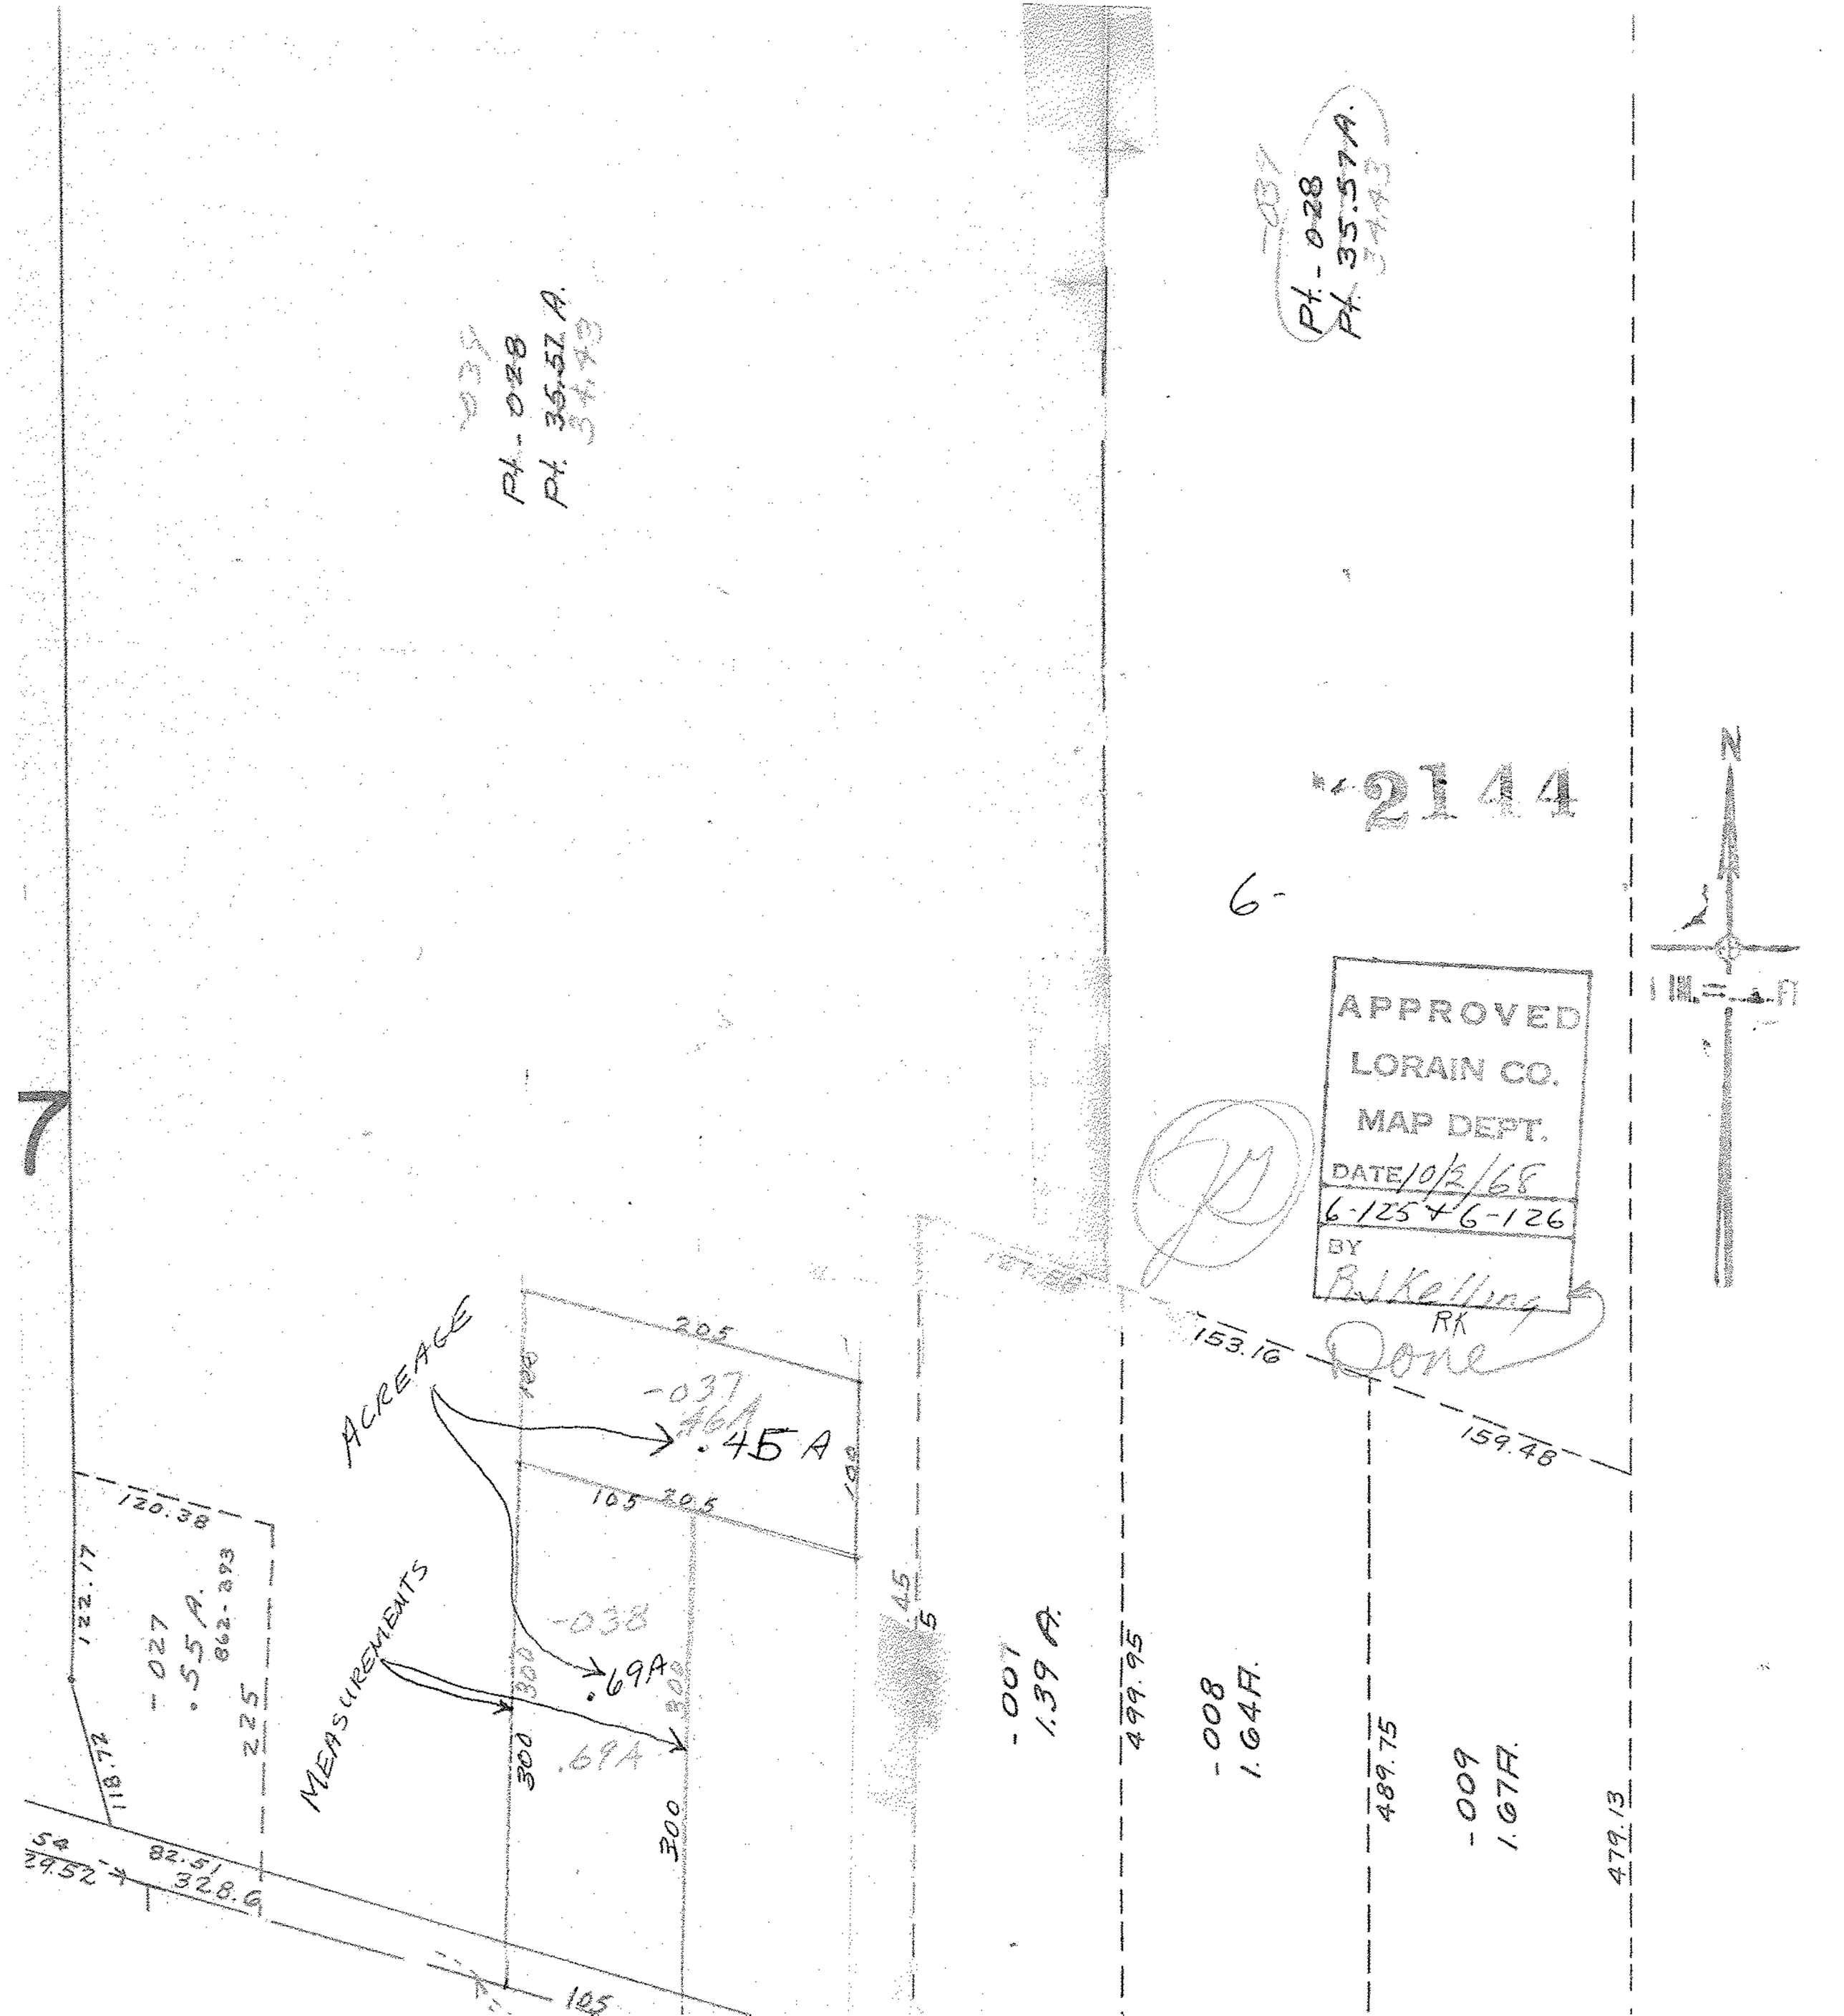

7
Pt. - 028
Pt. 35.57 A.
34.43
-037
Pt. - 028
Pt. 35.57 A.
34.43
2144
6-
APPROVED
LORAIN CO.
MAP DEPT.
DATE 10/2/68
6-125 + 6-126
BY
B.J. Kelling
RK
Done
N
ACREAGE
MEASUREMENTS
-037
.46A
.45 A
-038
.69A
.69A
-027
.55 A.
862-393
-007
1.39 A.
-008
1.64A.
-009
1.67A.
153.16
159.48
499.95
489.75
479.13
120.38
122.17
118.72
82.51
328.6
105
205
300
225