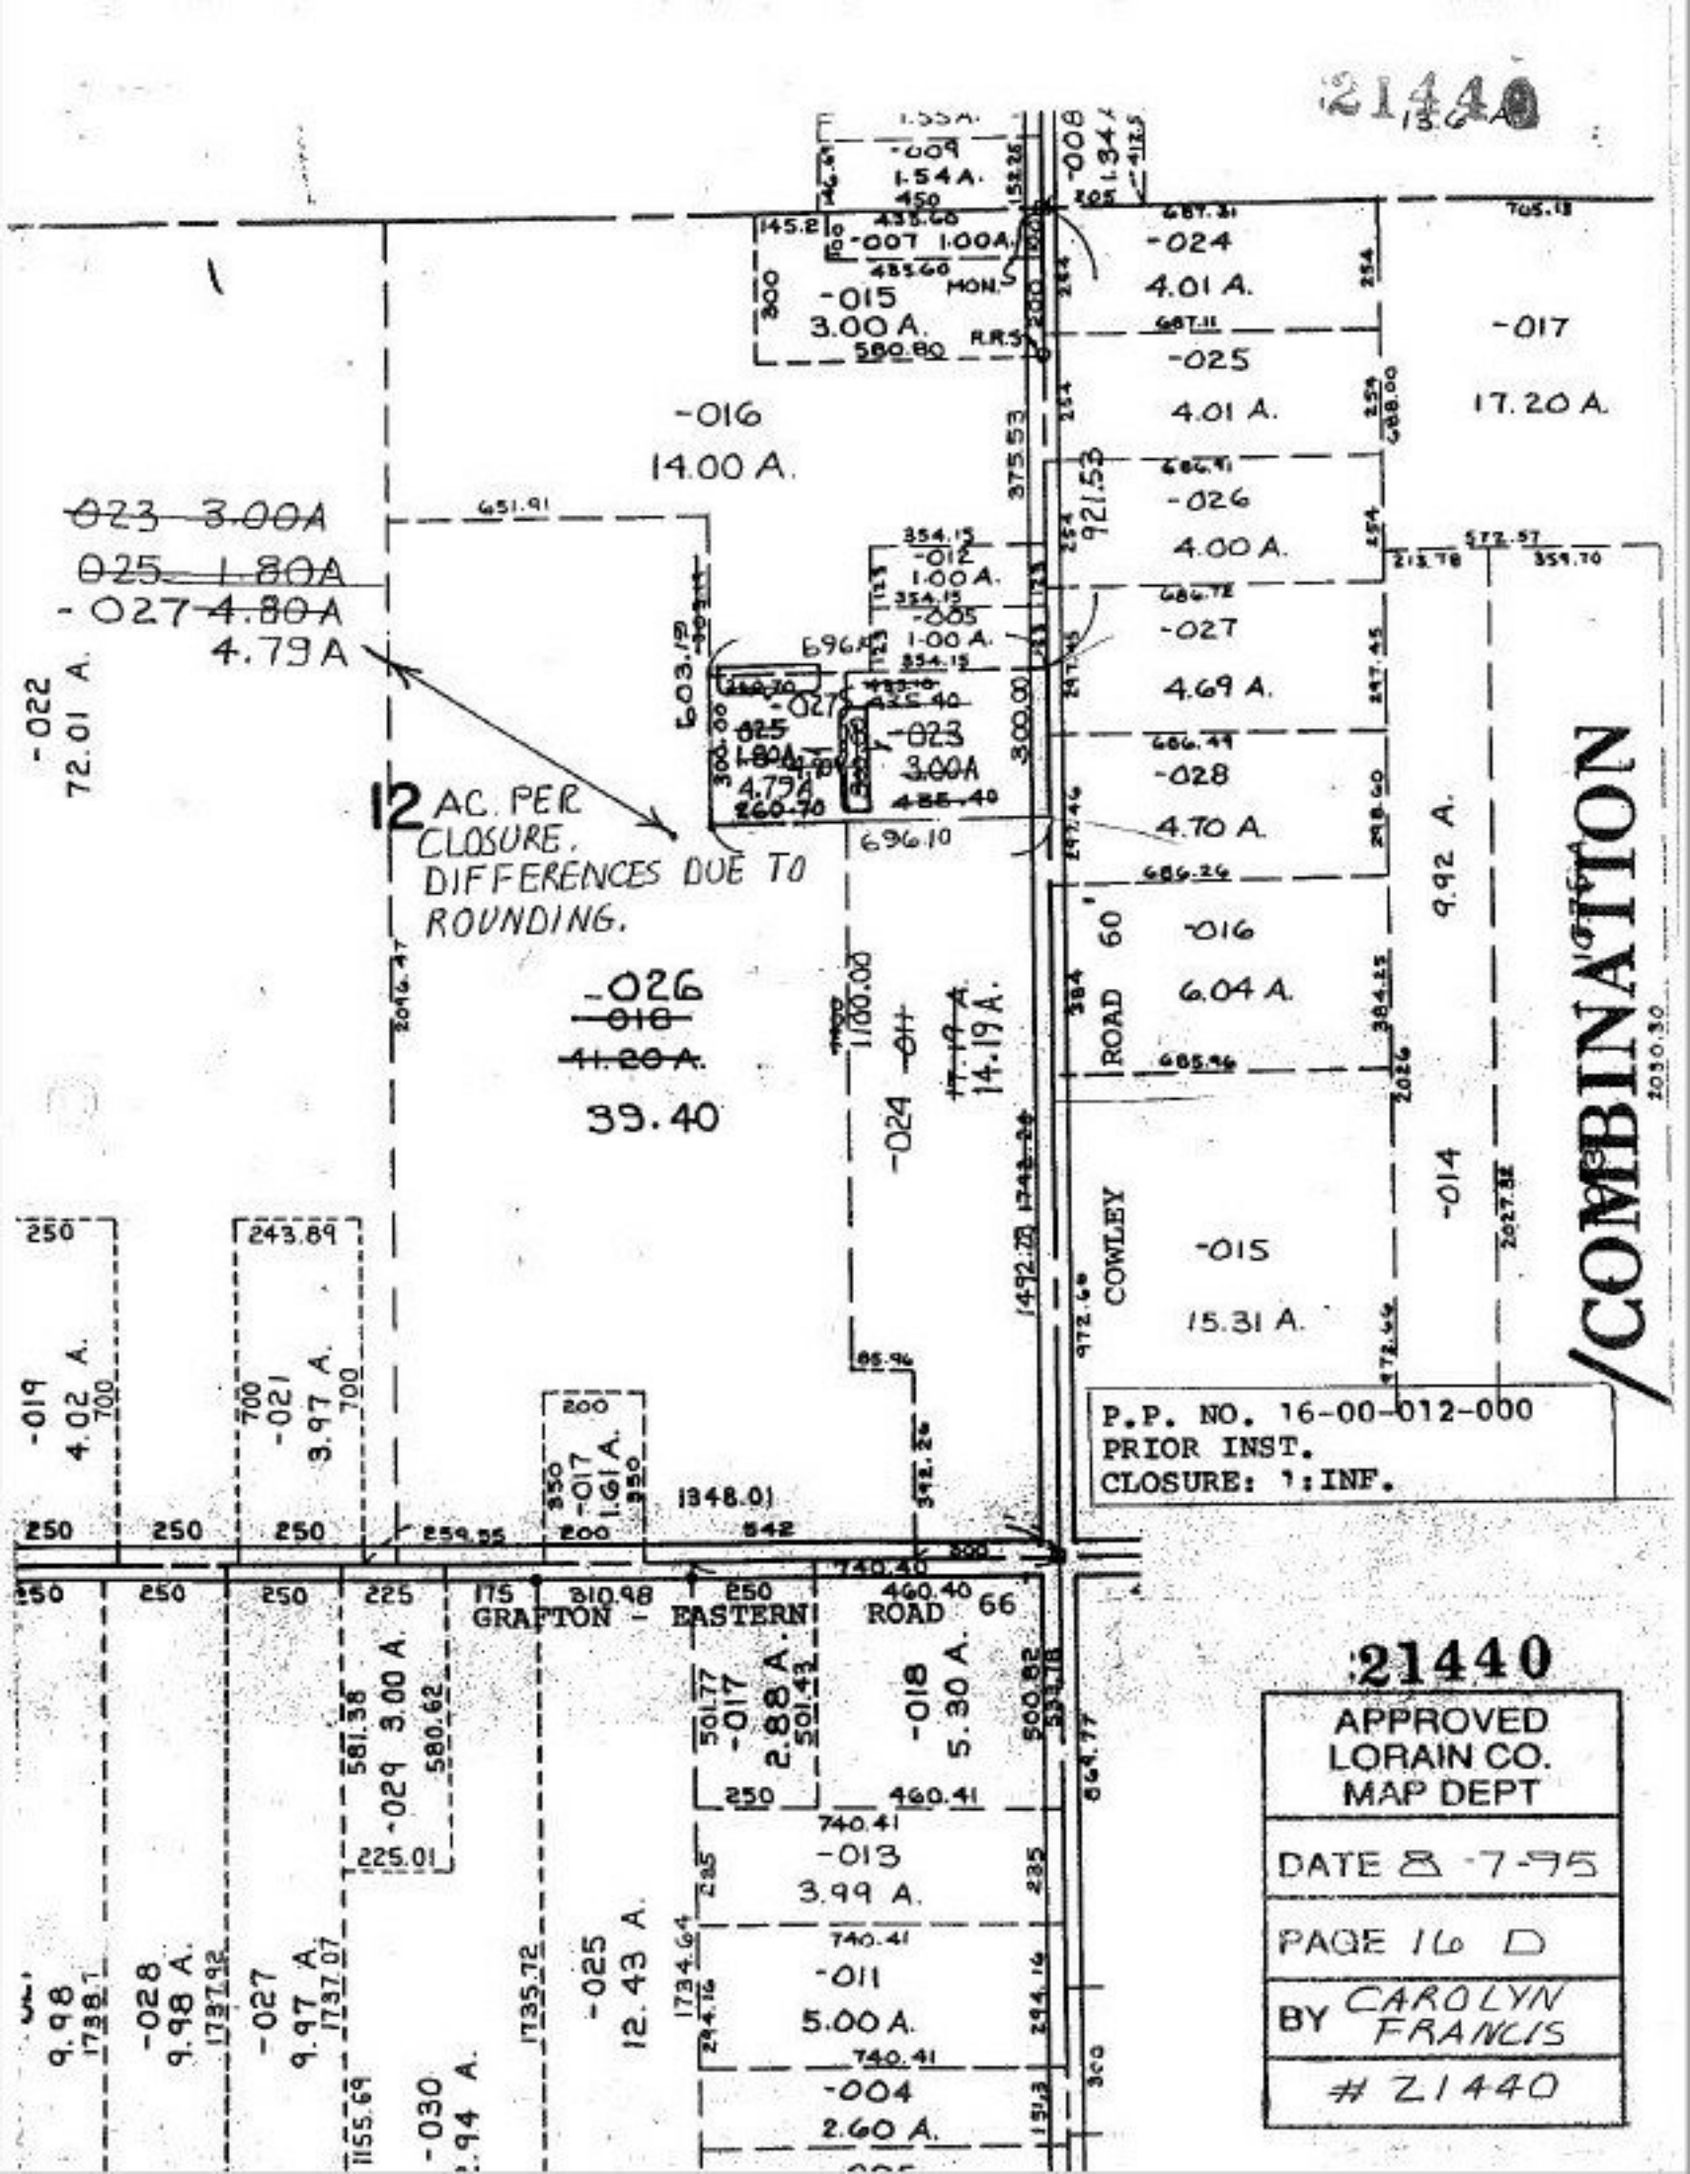
21440
-009 1.54 A.
-008 1.34 A.
-007 1.00 A.
-024 4.01 A.
-015 3.00 A.
-017 17.20 A.
-025 4.01 A.
-016 14.00 A.
-026 4.00 A.
-012 1.00 A.
-005 1.00 A.
-027 4.69 A.
-023 3.00 A.
-028 4.70 A.
-022 72.01 A.
12 AC. PER CLOSURE. DIFFERENCES DUE TO ROUNDING.
-026 -010 41.20 A. 39.40
-024 -011 17.19 A. 14.19 A.
-016 6.04 A.
9.92 A.
-014
-015 15.31 A.
COWLEY ROAD 60'
/COMBINATION
-019 4.02 A.
-021 3.97 A.
-017 1.61 A.
-029 3.00 A.
-017 2.88 A.
-018 5.30 A.
-013 3.99 A.
-011 5.00 A.
-004 2.60 A.
-028 9.98 A.
-027 9.97 A.
-030
-025 12.43 A.
GRAFTON - EASTERN ROAD 66
P.P. NO. 16-00-012-000
PRIOR INST.
CLOSURE: 1:INF.
21440
APPROVED LORAIN CO. MAP DEPT
DATE 8-7-95
PAGE 16 D
BY CAROLYN FRANCIS
21440