21440

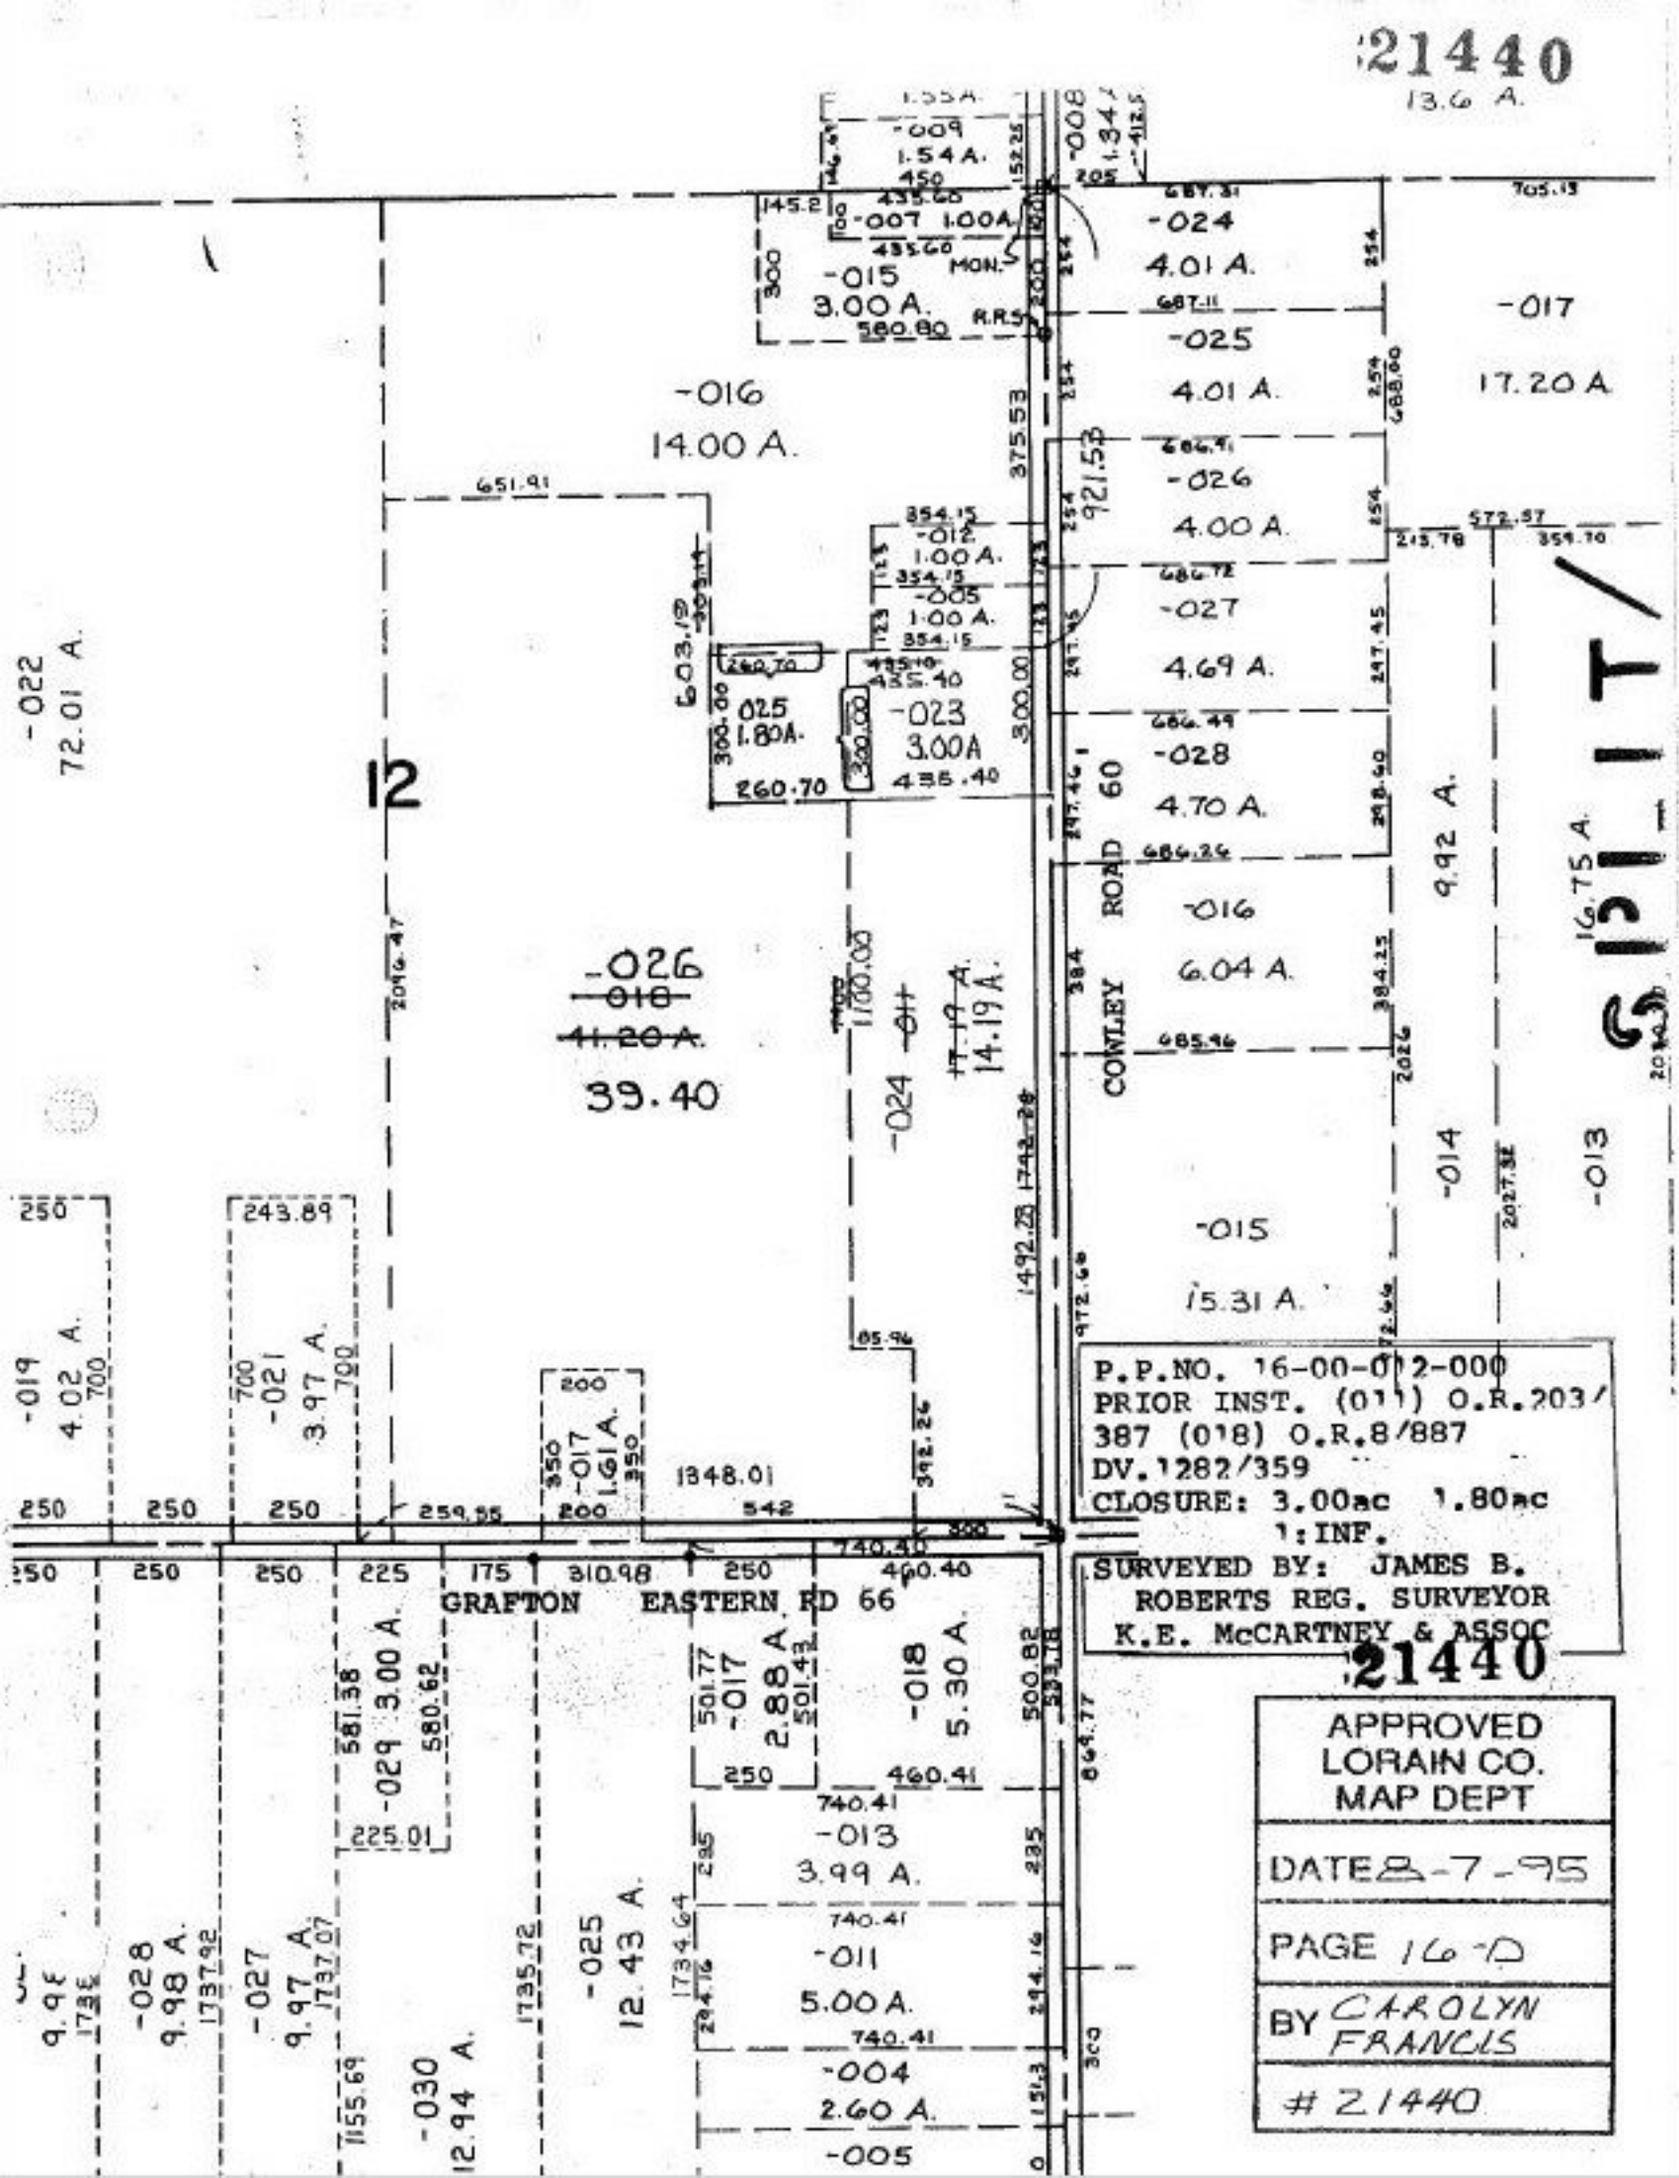

P.P.NO. 16-00-012-000
PRIOR INST. (011) O.R.203/387 (018) O.R.8/887
DV.1282/359
CLOSURE: 3.00ac 1.80ac
1:INF.
SURVEYED BY: JAMES B. ROBERTS REG. SURVEYOR
K.E. McCARTNEY & ASSOC

21440

APPROVED
LORAIN CO.
MAP DEPT

DATE 8-7-95

PAGE 16-D

BY CAROLYN FRANCIS

21440