21441

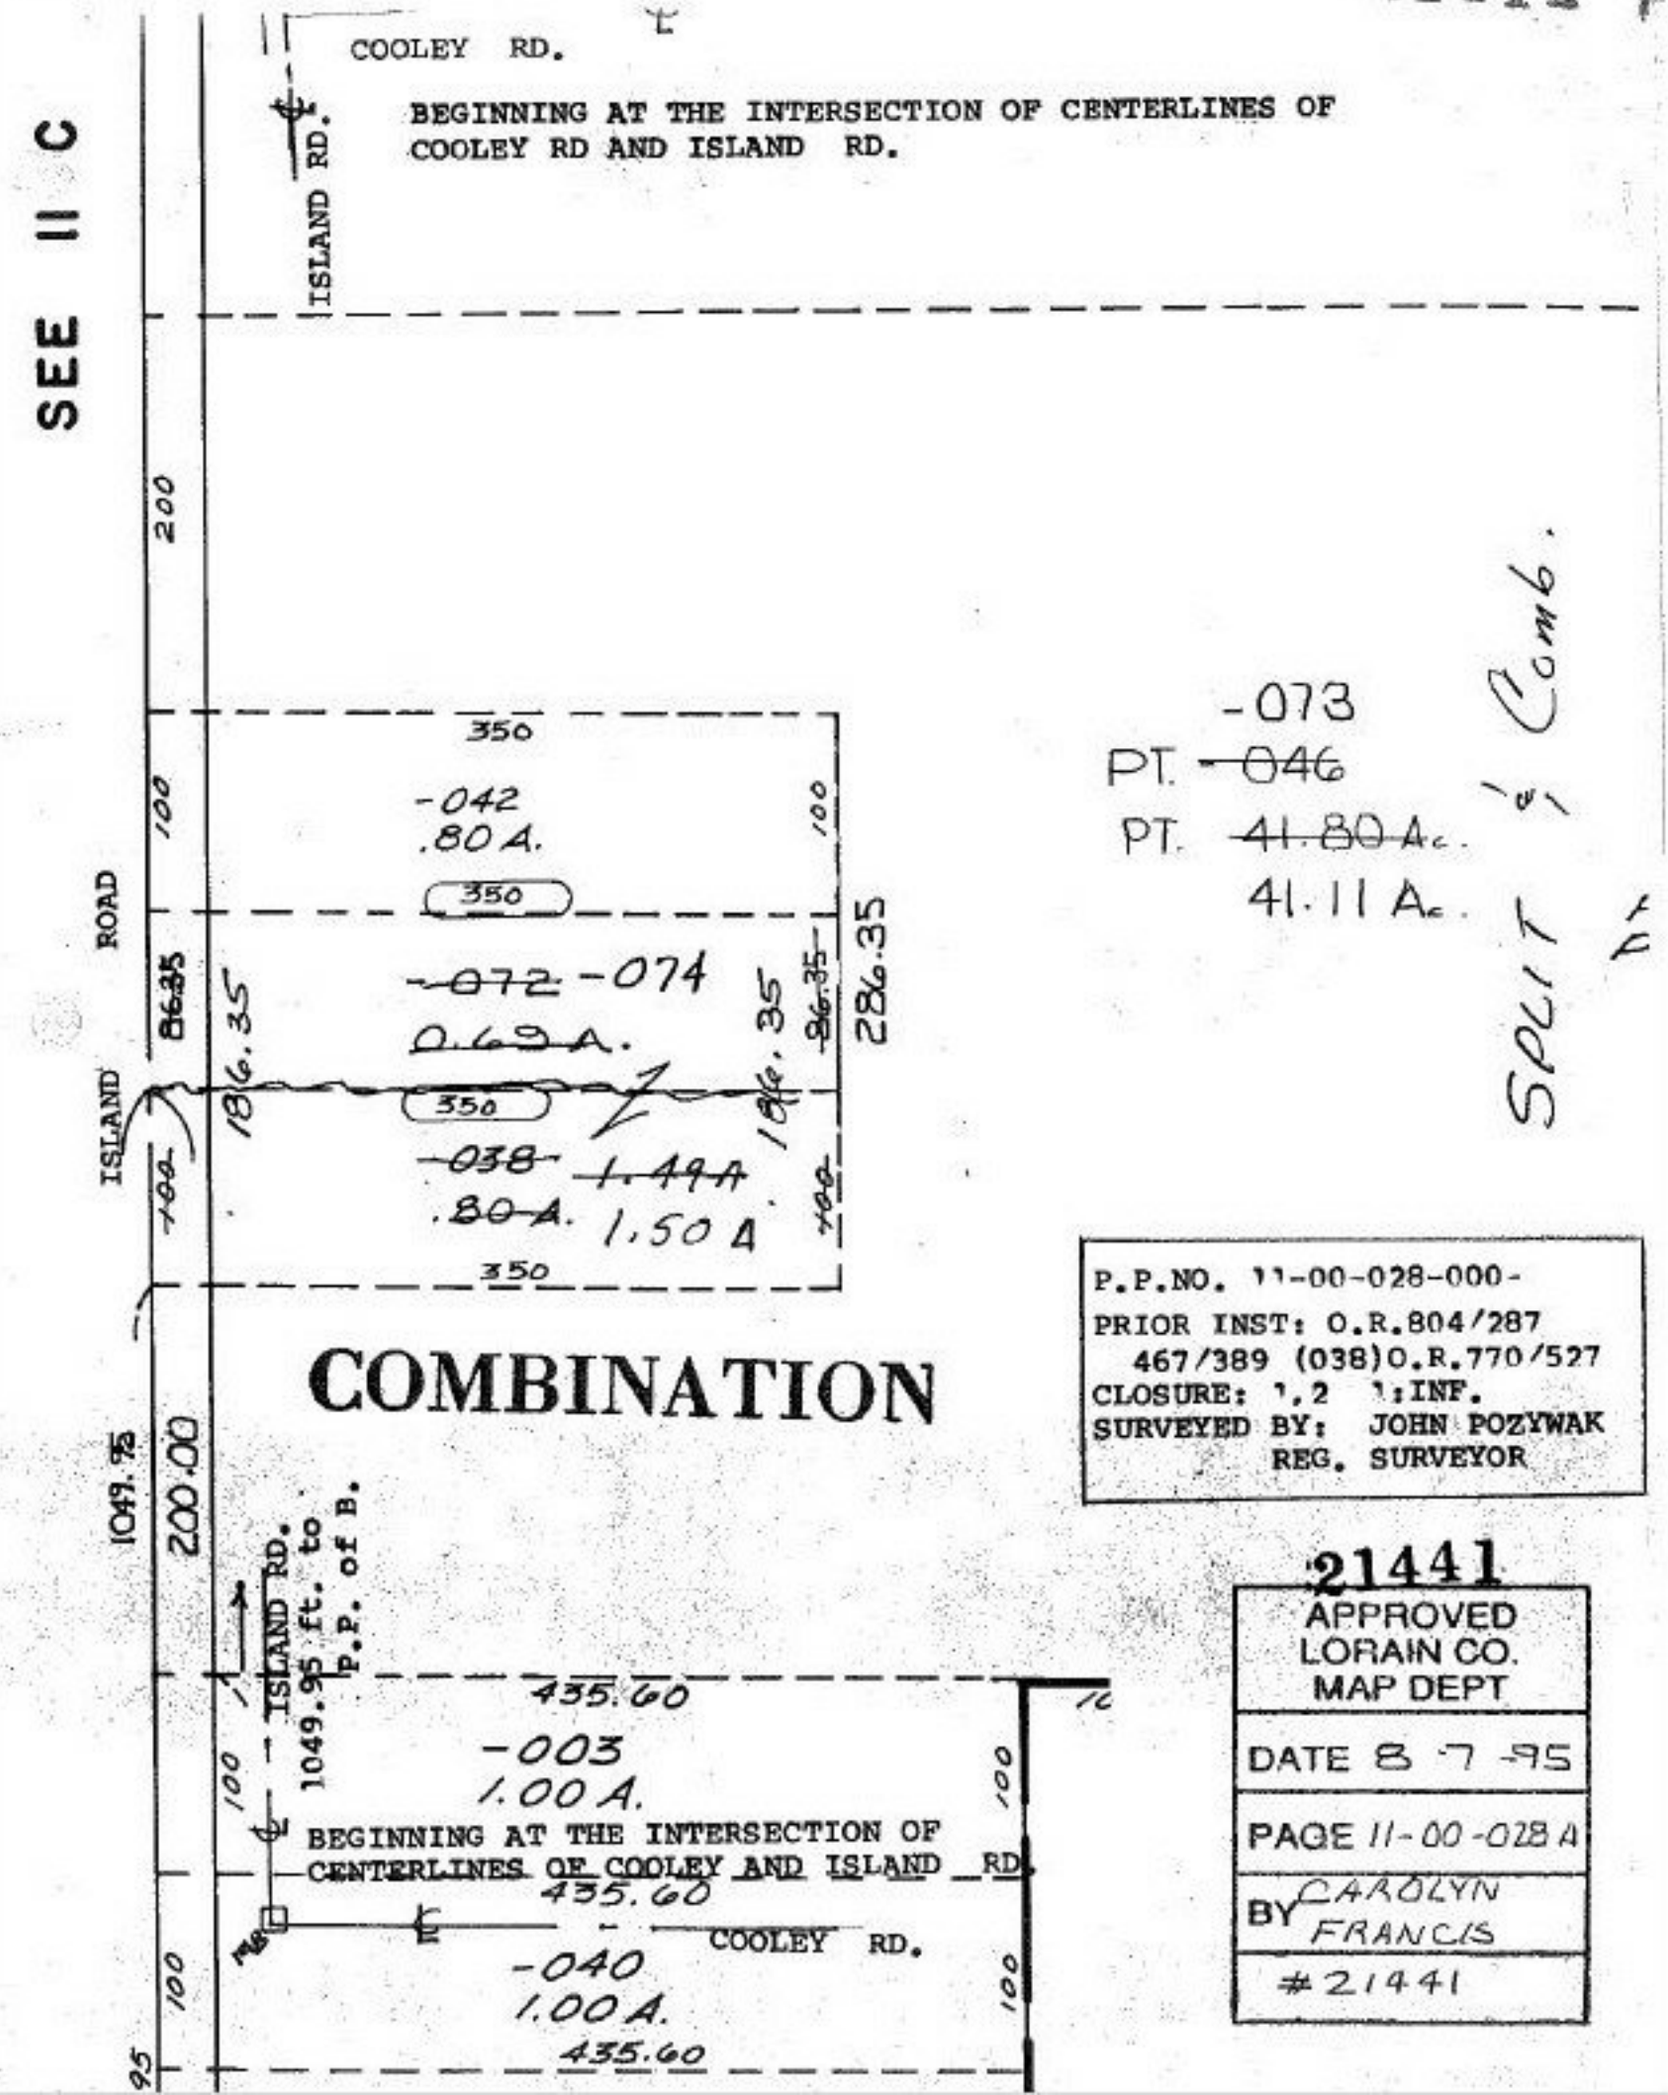

21441

APPROVED
LORAIN CO.
MAP DEPT

DATE 8-7-95

PAGE 11-00-028 A

BY CAROLYN FRANCIS

#21441