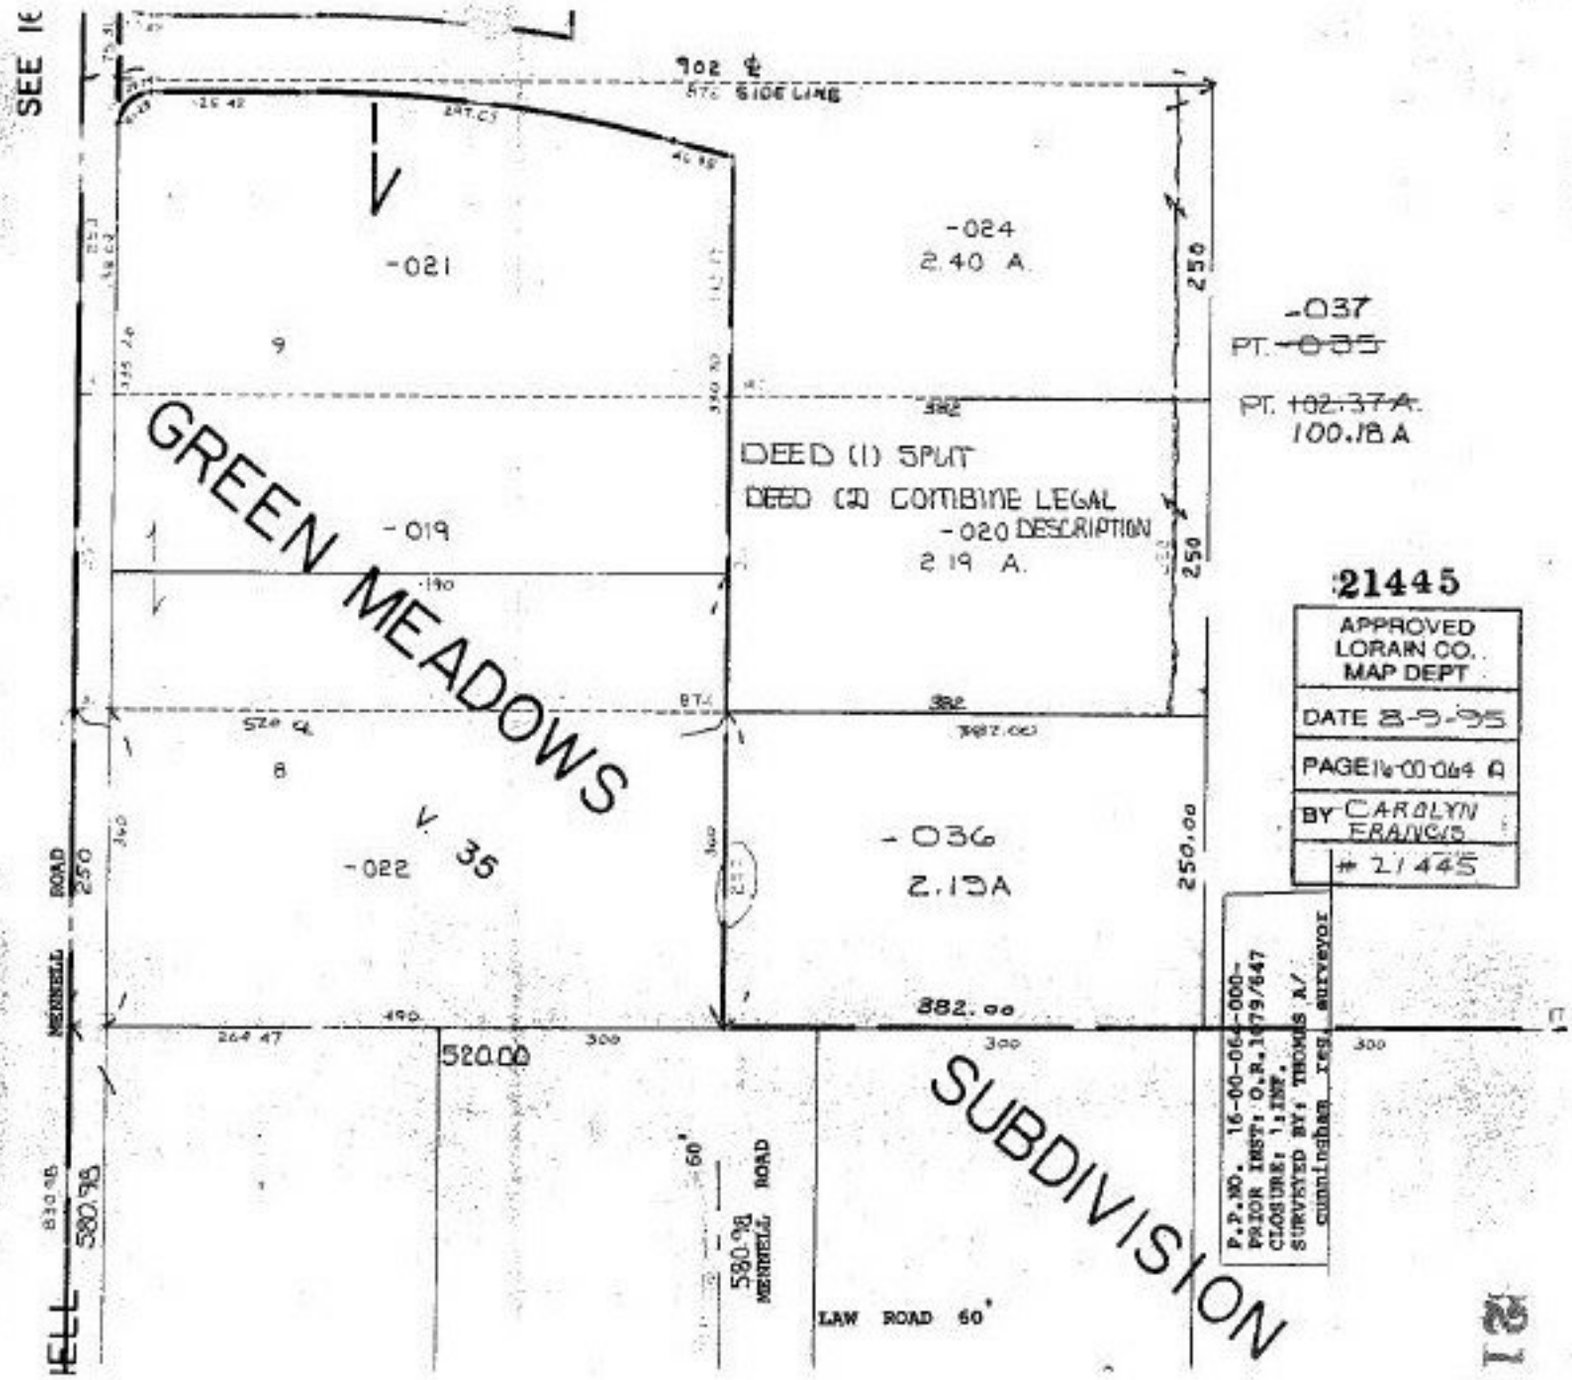
SEE 16
902 ℄
SIDE LINE
-021
-024
2.40 A.
-037
PT. ~~-035~~
PT. ~~102.37 A.~~
100.18 A
DEED (1) SPLIT
DEED (2) COMBINE LEGAL
-020 DESCRIPTION
2.19 A.
-019
GREEN MEADOWS
-022
V. 35
-036
2.19A
250
250.00
382.00
520.00
580.98
MENNELL ROAD
LAW ROAD 60'
SUBDIVISION
21445
APPROVED
LORAIN CO.
MAP DEPT
DATE 8-9-95
PAGE 16-00-064 A
BY CAROLYN FRANCIS
21445
P.P.NO. 16-00-064-000-
PRIOR INST: O.R.1079/647
CLOSURE: 1:INF.
SURVEYED BY: THOMAS A/
cunningham reg. surveyor
21445