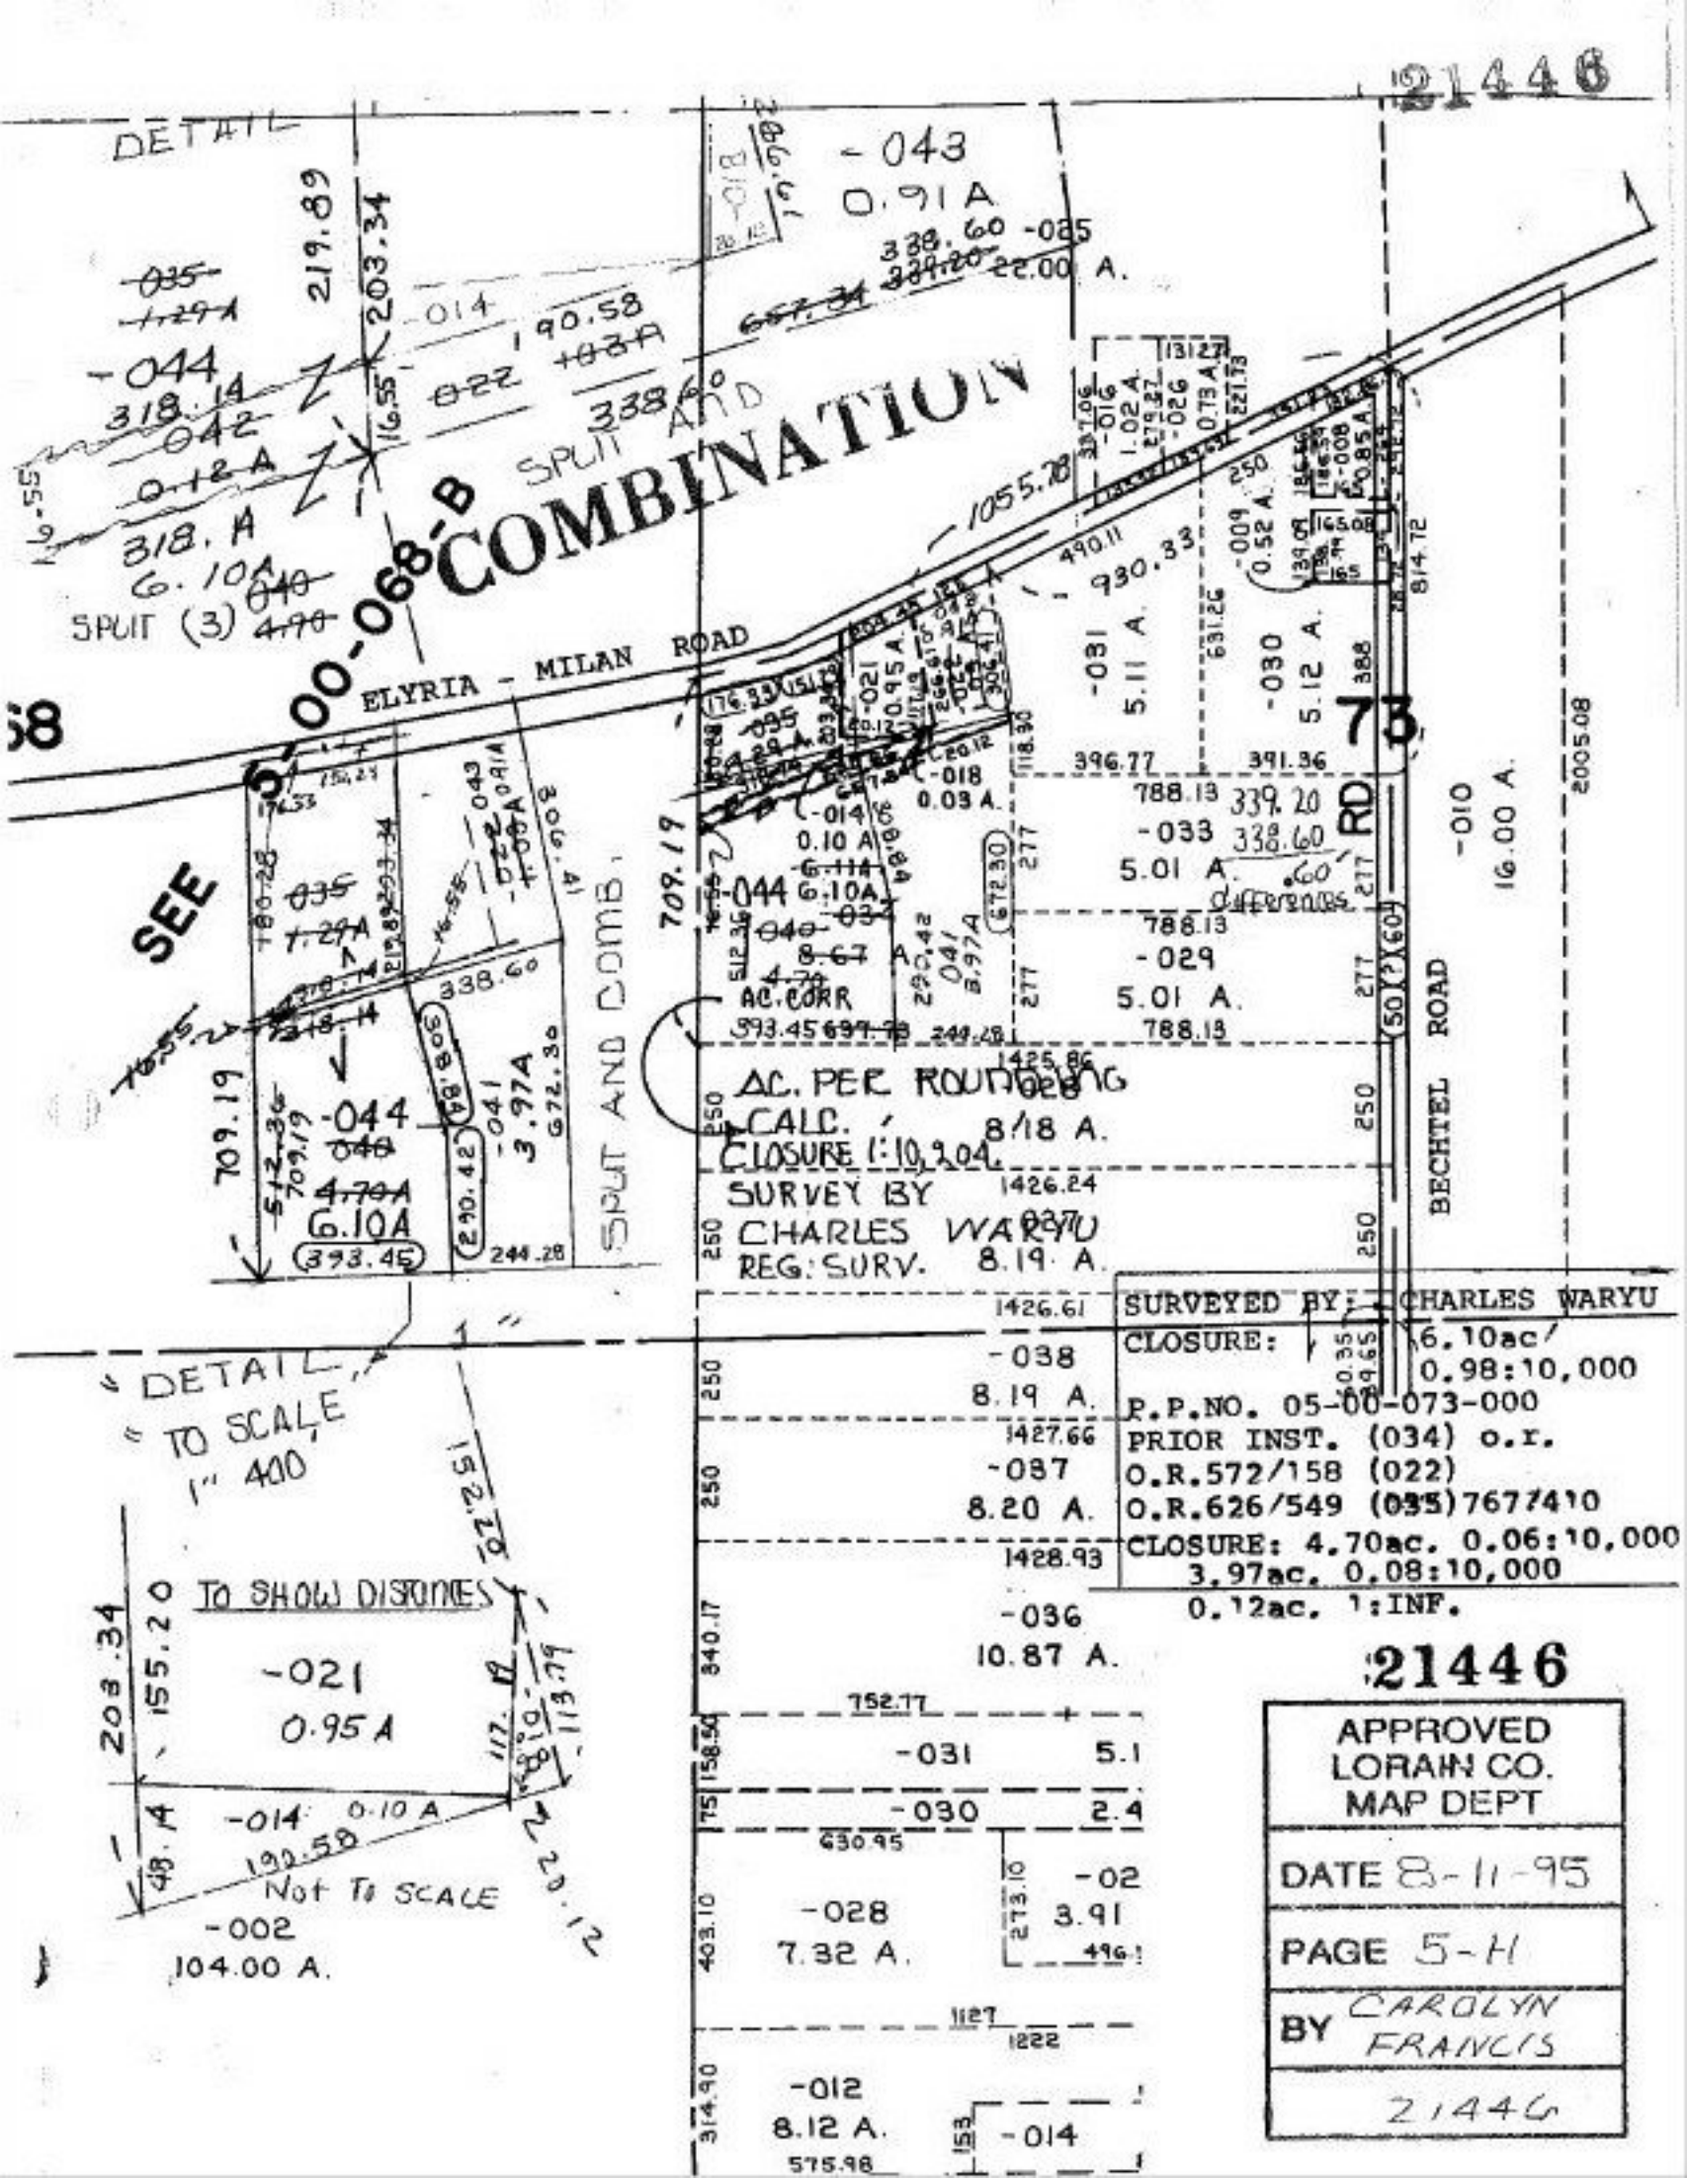
21446
DETAIL
COMBINATION
SPLIT AND
SPLIT (3)
ELYRIA - MILAN ROAD
SEE 5-00-068-B
SPLIT AND COMB.
BECHTEL ROAD
73
RD
AC. PER ROUNDING CALC.
CLOSURE 1:10,204.
SURVEY BY CHARLES WARYU
REG: SURV.
DETAIL
TO SCALE 1" 400
TO SHOW DISTANCES
Not To SCALE
-043 0.91 A
-025 22.00 A.
-044 318.14
-042 0.12 A
318. A 6.10A
-014 190.58
-022 338.60
-031 5.11 A.
-030 5.12 A.
-033 5.01 A.
-029 5.01 A.
-010 16.00 A.
-018 0.03 A.
-014 0.10 A
-044 6.10A
-034 8.67 A.
AC. CORR
-044 6.10A
-041 3.97A
-038 8.19 A.
-037 8.20 A.
-036 10.87 A.
-031 5.1
-030 2.4
-028 7.32 A.
-02 3.91
-012 8.12 A.
-014
-021 0.95 A
-014 0.10 A
-002 104.00 A.
SURVEYED BY: CHARLES WARYU
CLOSURE: 6.10ac/ 0.98:10,000
P.P.NO. 05-00-073-000
PRIOR INST. (034) o.r.
O.R.572/158 (022)
O.R.626/549 (035)7677410
CLOSURE: 4.70ac. 0.06:10,000
3.97ac. 0.08:10,000
0.12ac. 1:INF.
21446
APPROVED LORAIN CO. MAP DEPT
DATE 8-11-95
PAGE 5-H
BY CAROLYN FRANCIS
21446