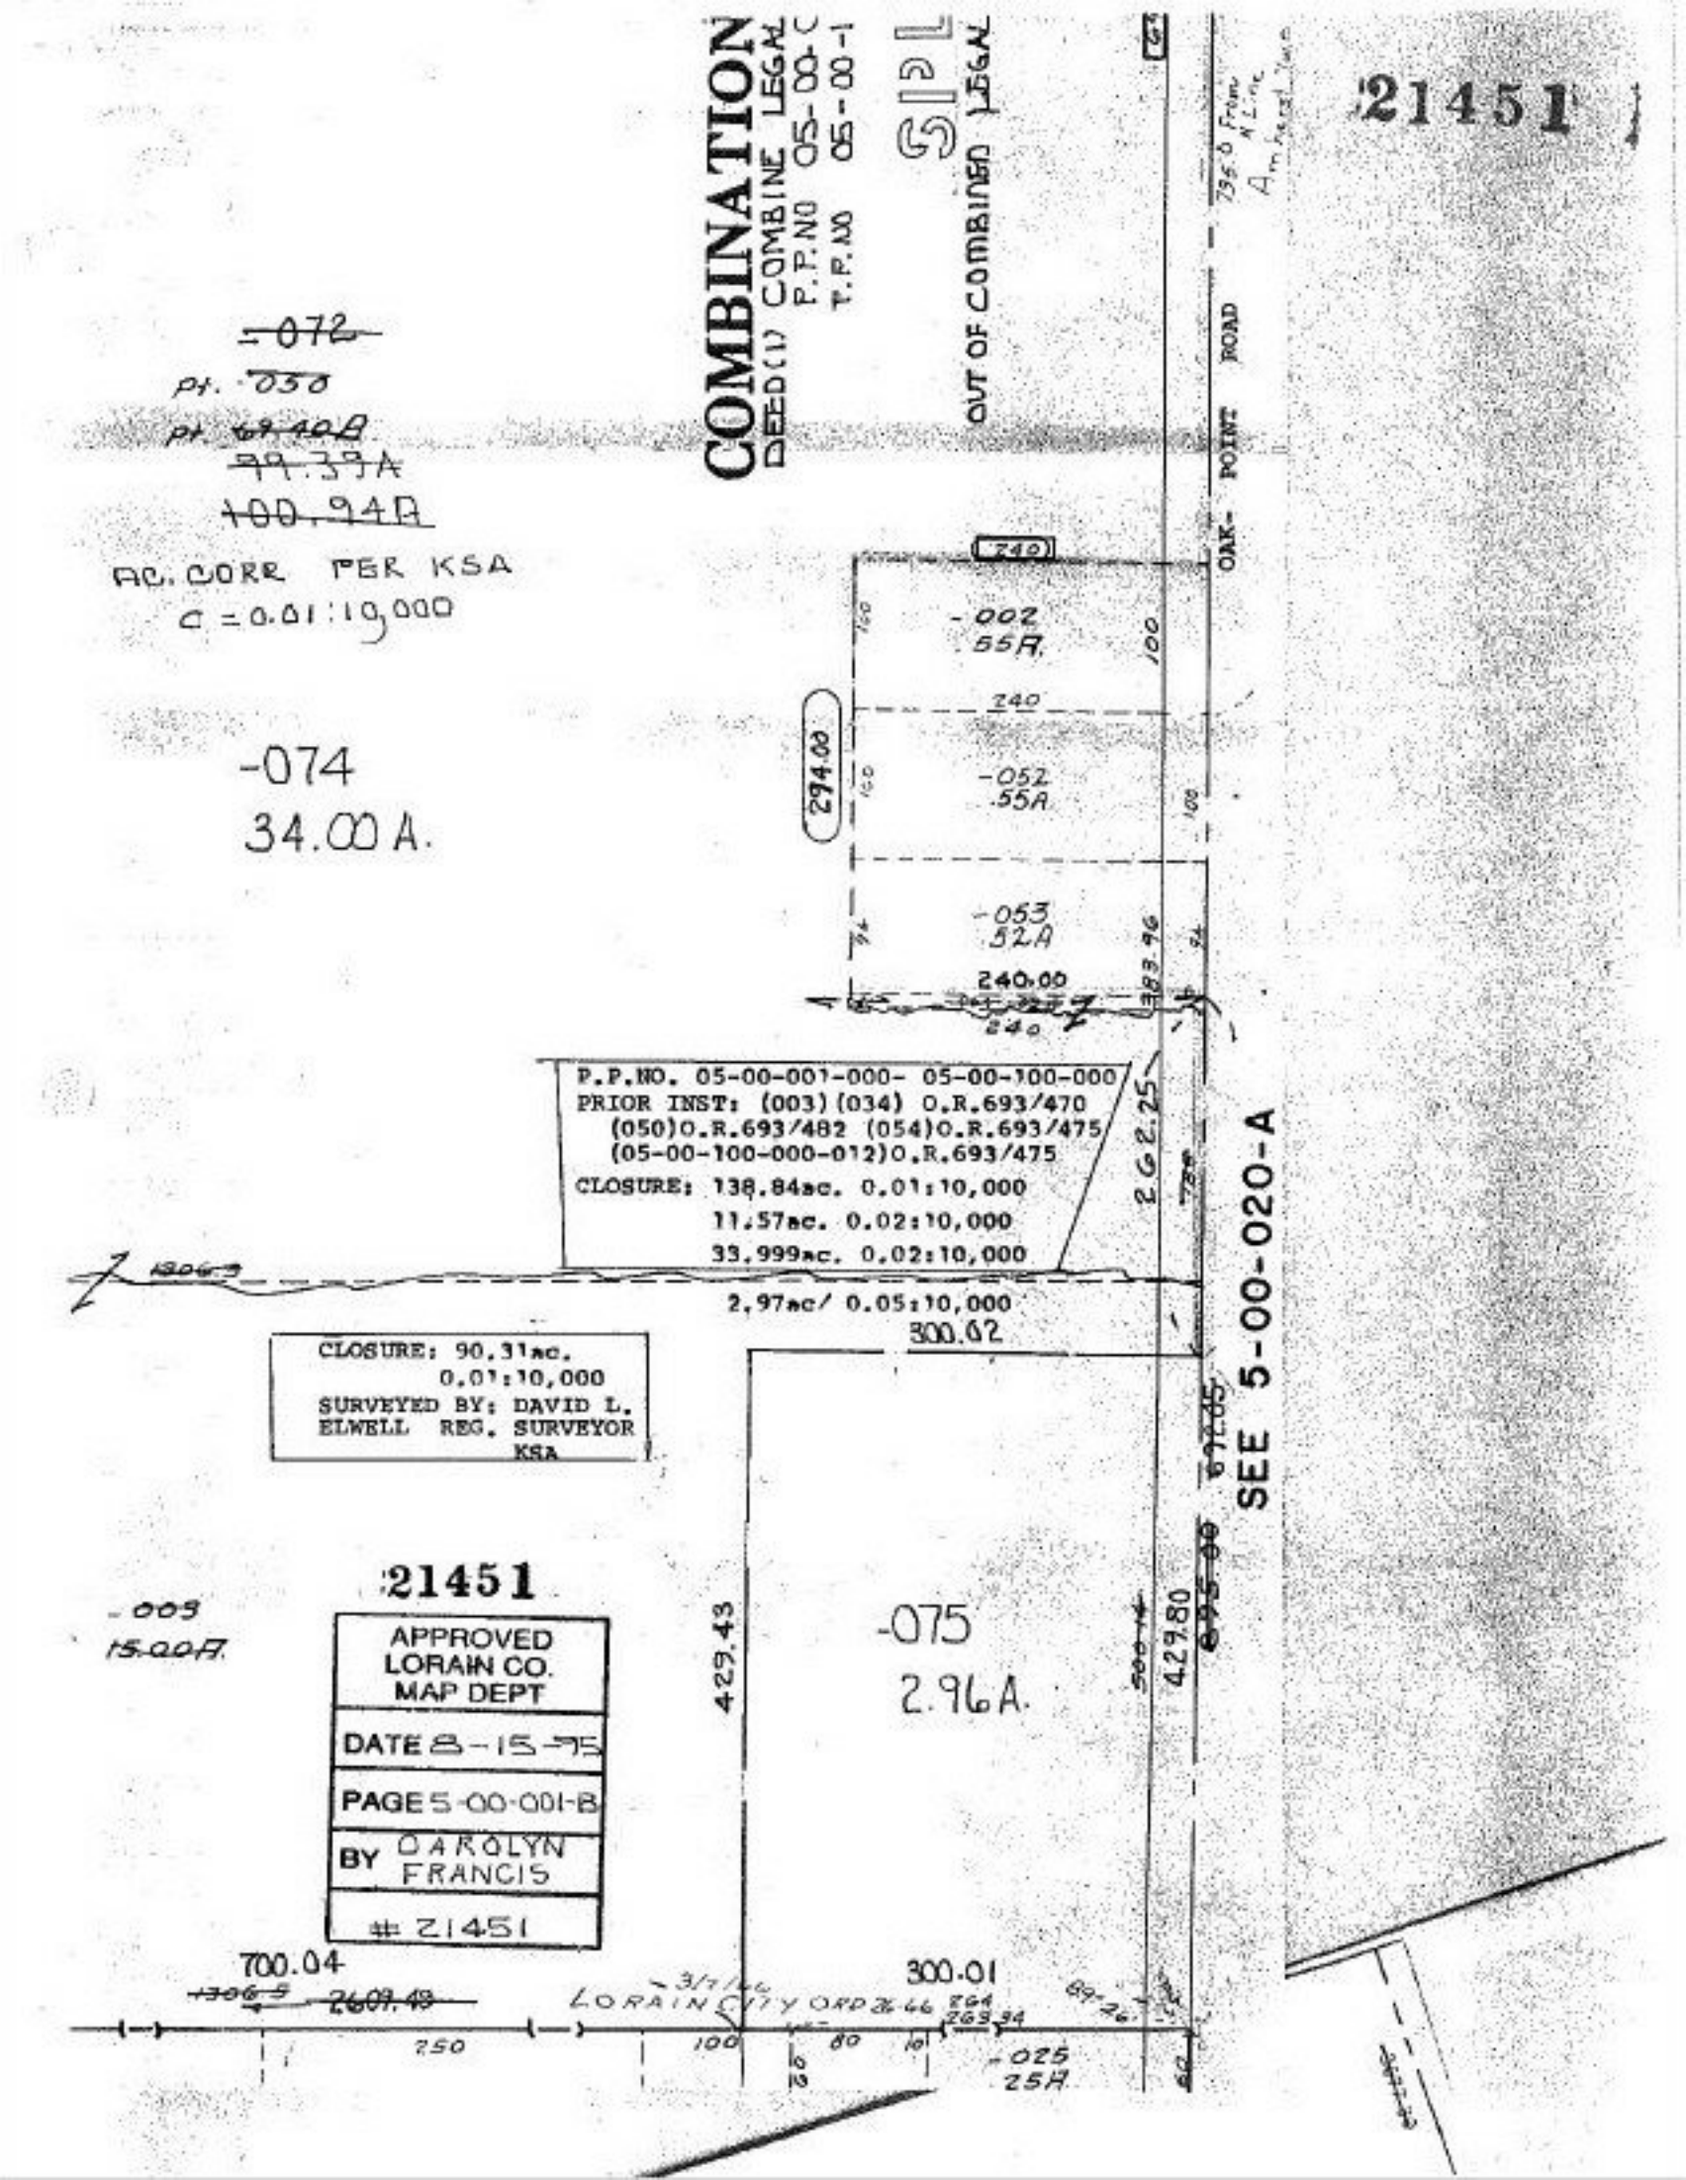
21451
COMBINATION
DEED(1) COMBINE LEGAL
P.P.NO 05-00-
T.P.NO 05-00-1
OUT OF COMBINED LEGAL
OAK-POINT ROAD
-072
pt. 030
pt. 69.40A
99.39A
100.94A
AC. CORR PER KSA
C=0.01:10,000
-074
34.00 A.
240
-002
.55A.
294.00
-052
.55A
-053
.52A
240.00
383.96
P.P.NO. 05-00-001-000- 05-00-100-000
PRIOR INST: (003)(034) O.R.693/470
(050)O.R.693/482 (054)O.R.693/475
(05-00-100-000-012)O.R.693/475
CLOSURE: 138.84ac. 0.01:10,000
11.57ac. 0.02:10,000
33.999ac. 0.02:10,000
2,97ac/ 0.05:10,000
2662.25
SEE 5-00-020-A
300.02
CLOSURE: 90.31ac.
0.01:10,000
SURVEYED BY: DAVID L.
ELWELL REG. SURVEYOR
KSA
21451
APPROVED
LORAIN CO.
MAP DEPT
DATE 8-15-95
PAGE 5-00-001-B
BY CAROLYN
FRANCIS
21451
-009
15.00A.
429.43
-075
2.96A.
429.80
700.04
2609.49
300.01
LORAIN CITY ORD 3/7/46
-025
25A