21451

COMBINATION

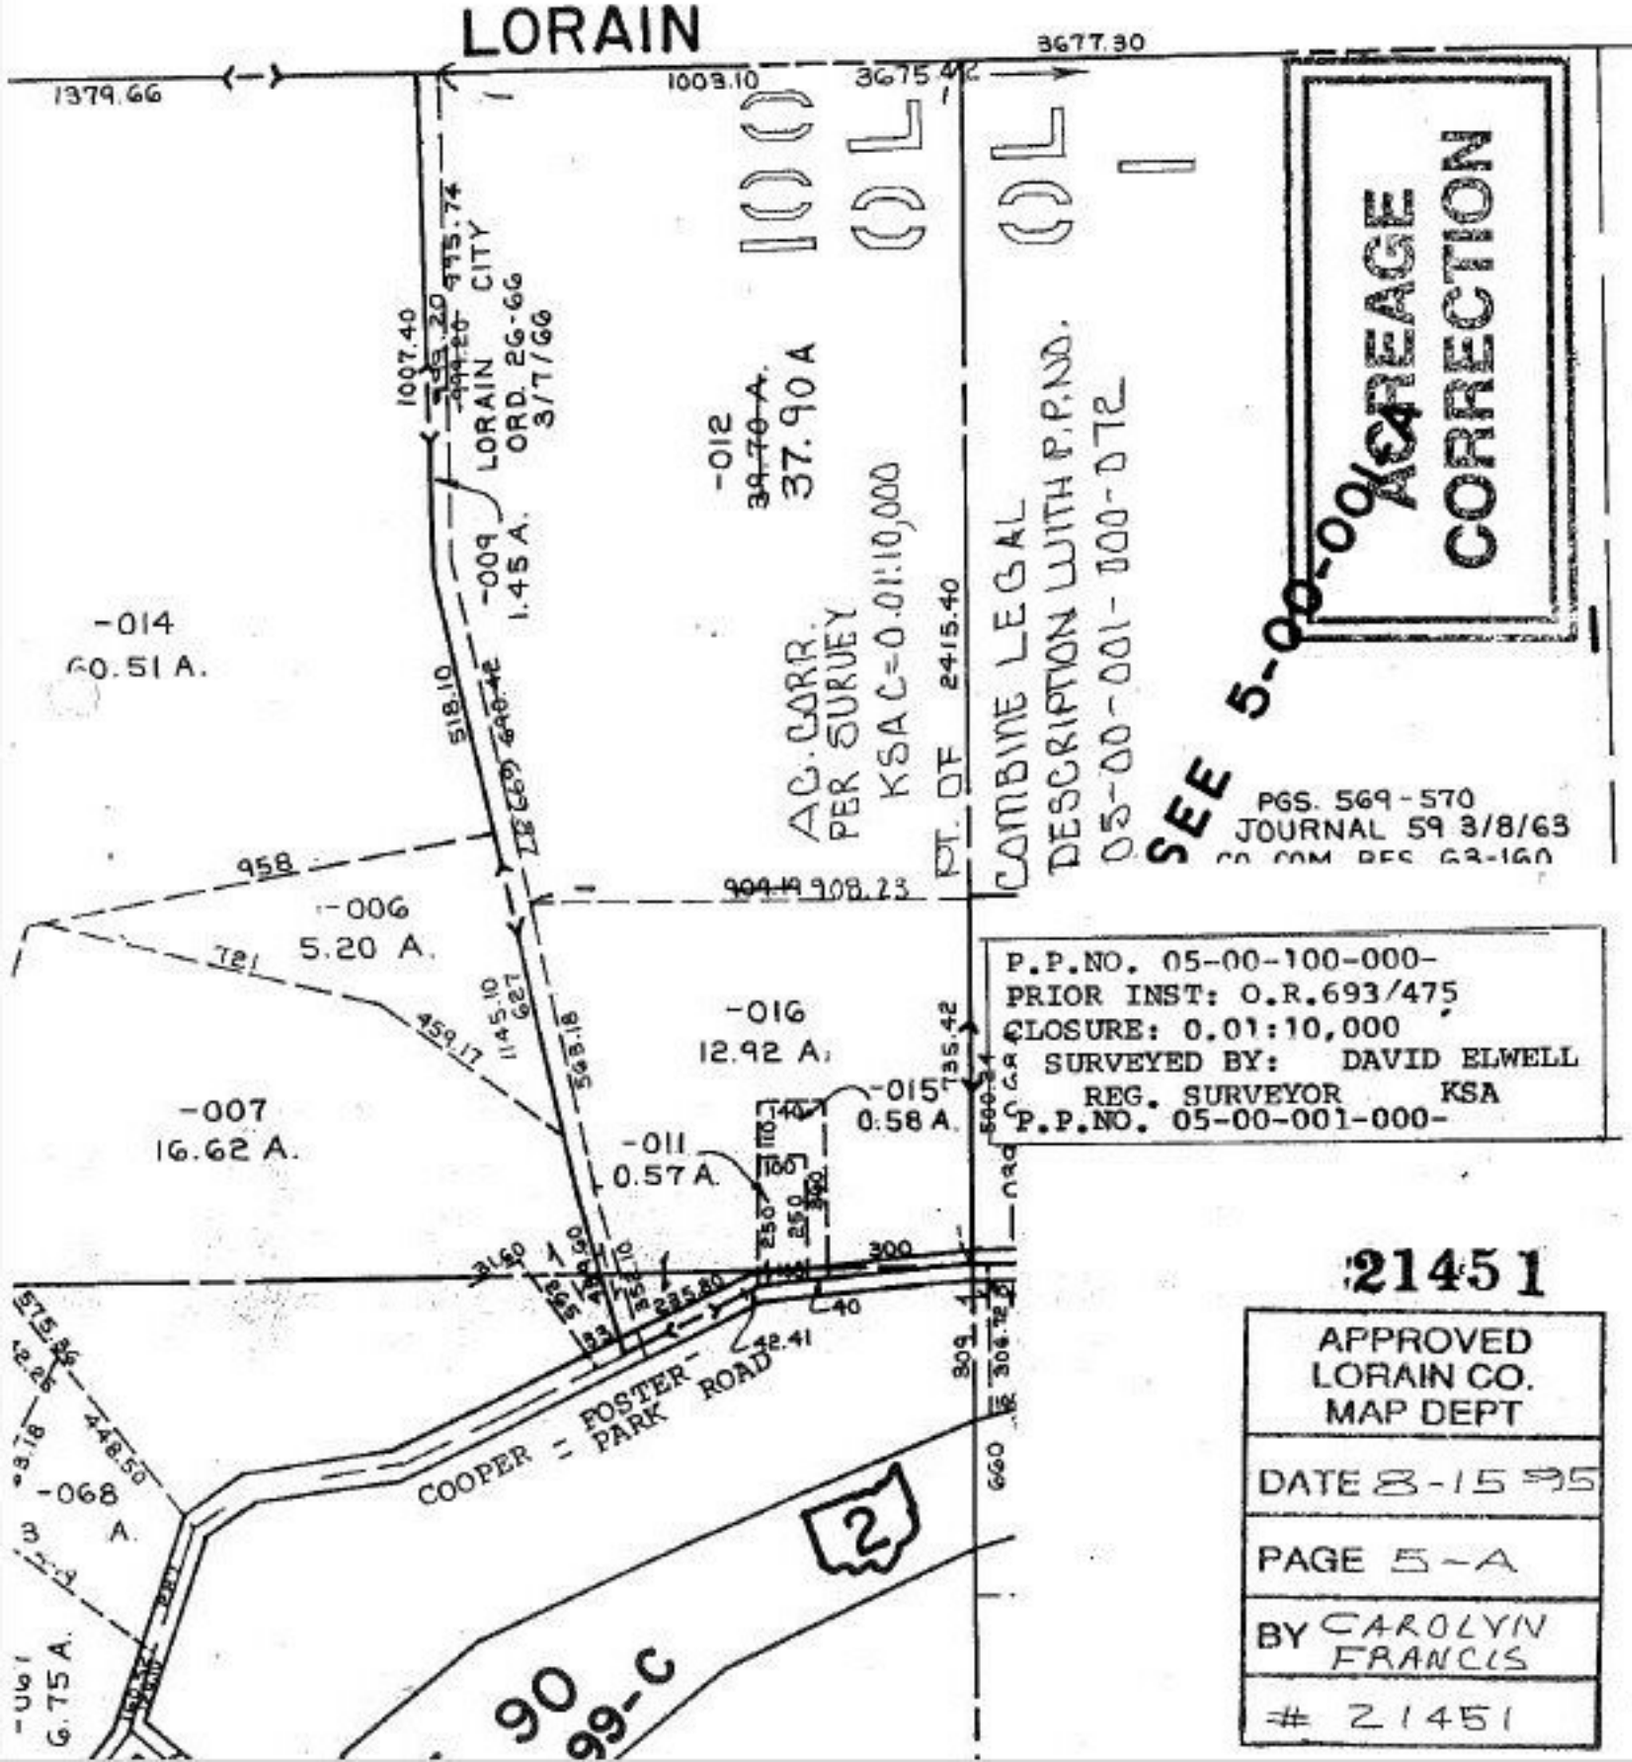

21451

APPROVED
LORAIN CO.
MAP DEPT

DATE 8-15-95

PAGE 5-A

BY CAROLYN FRANCIS

21451