21453-A

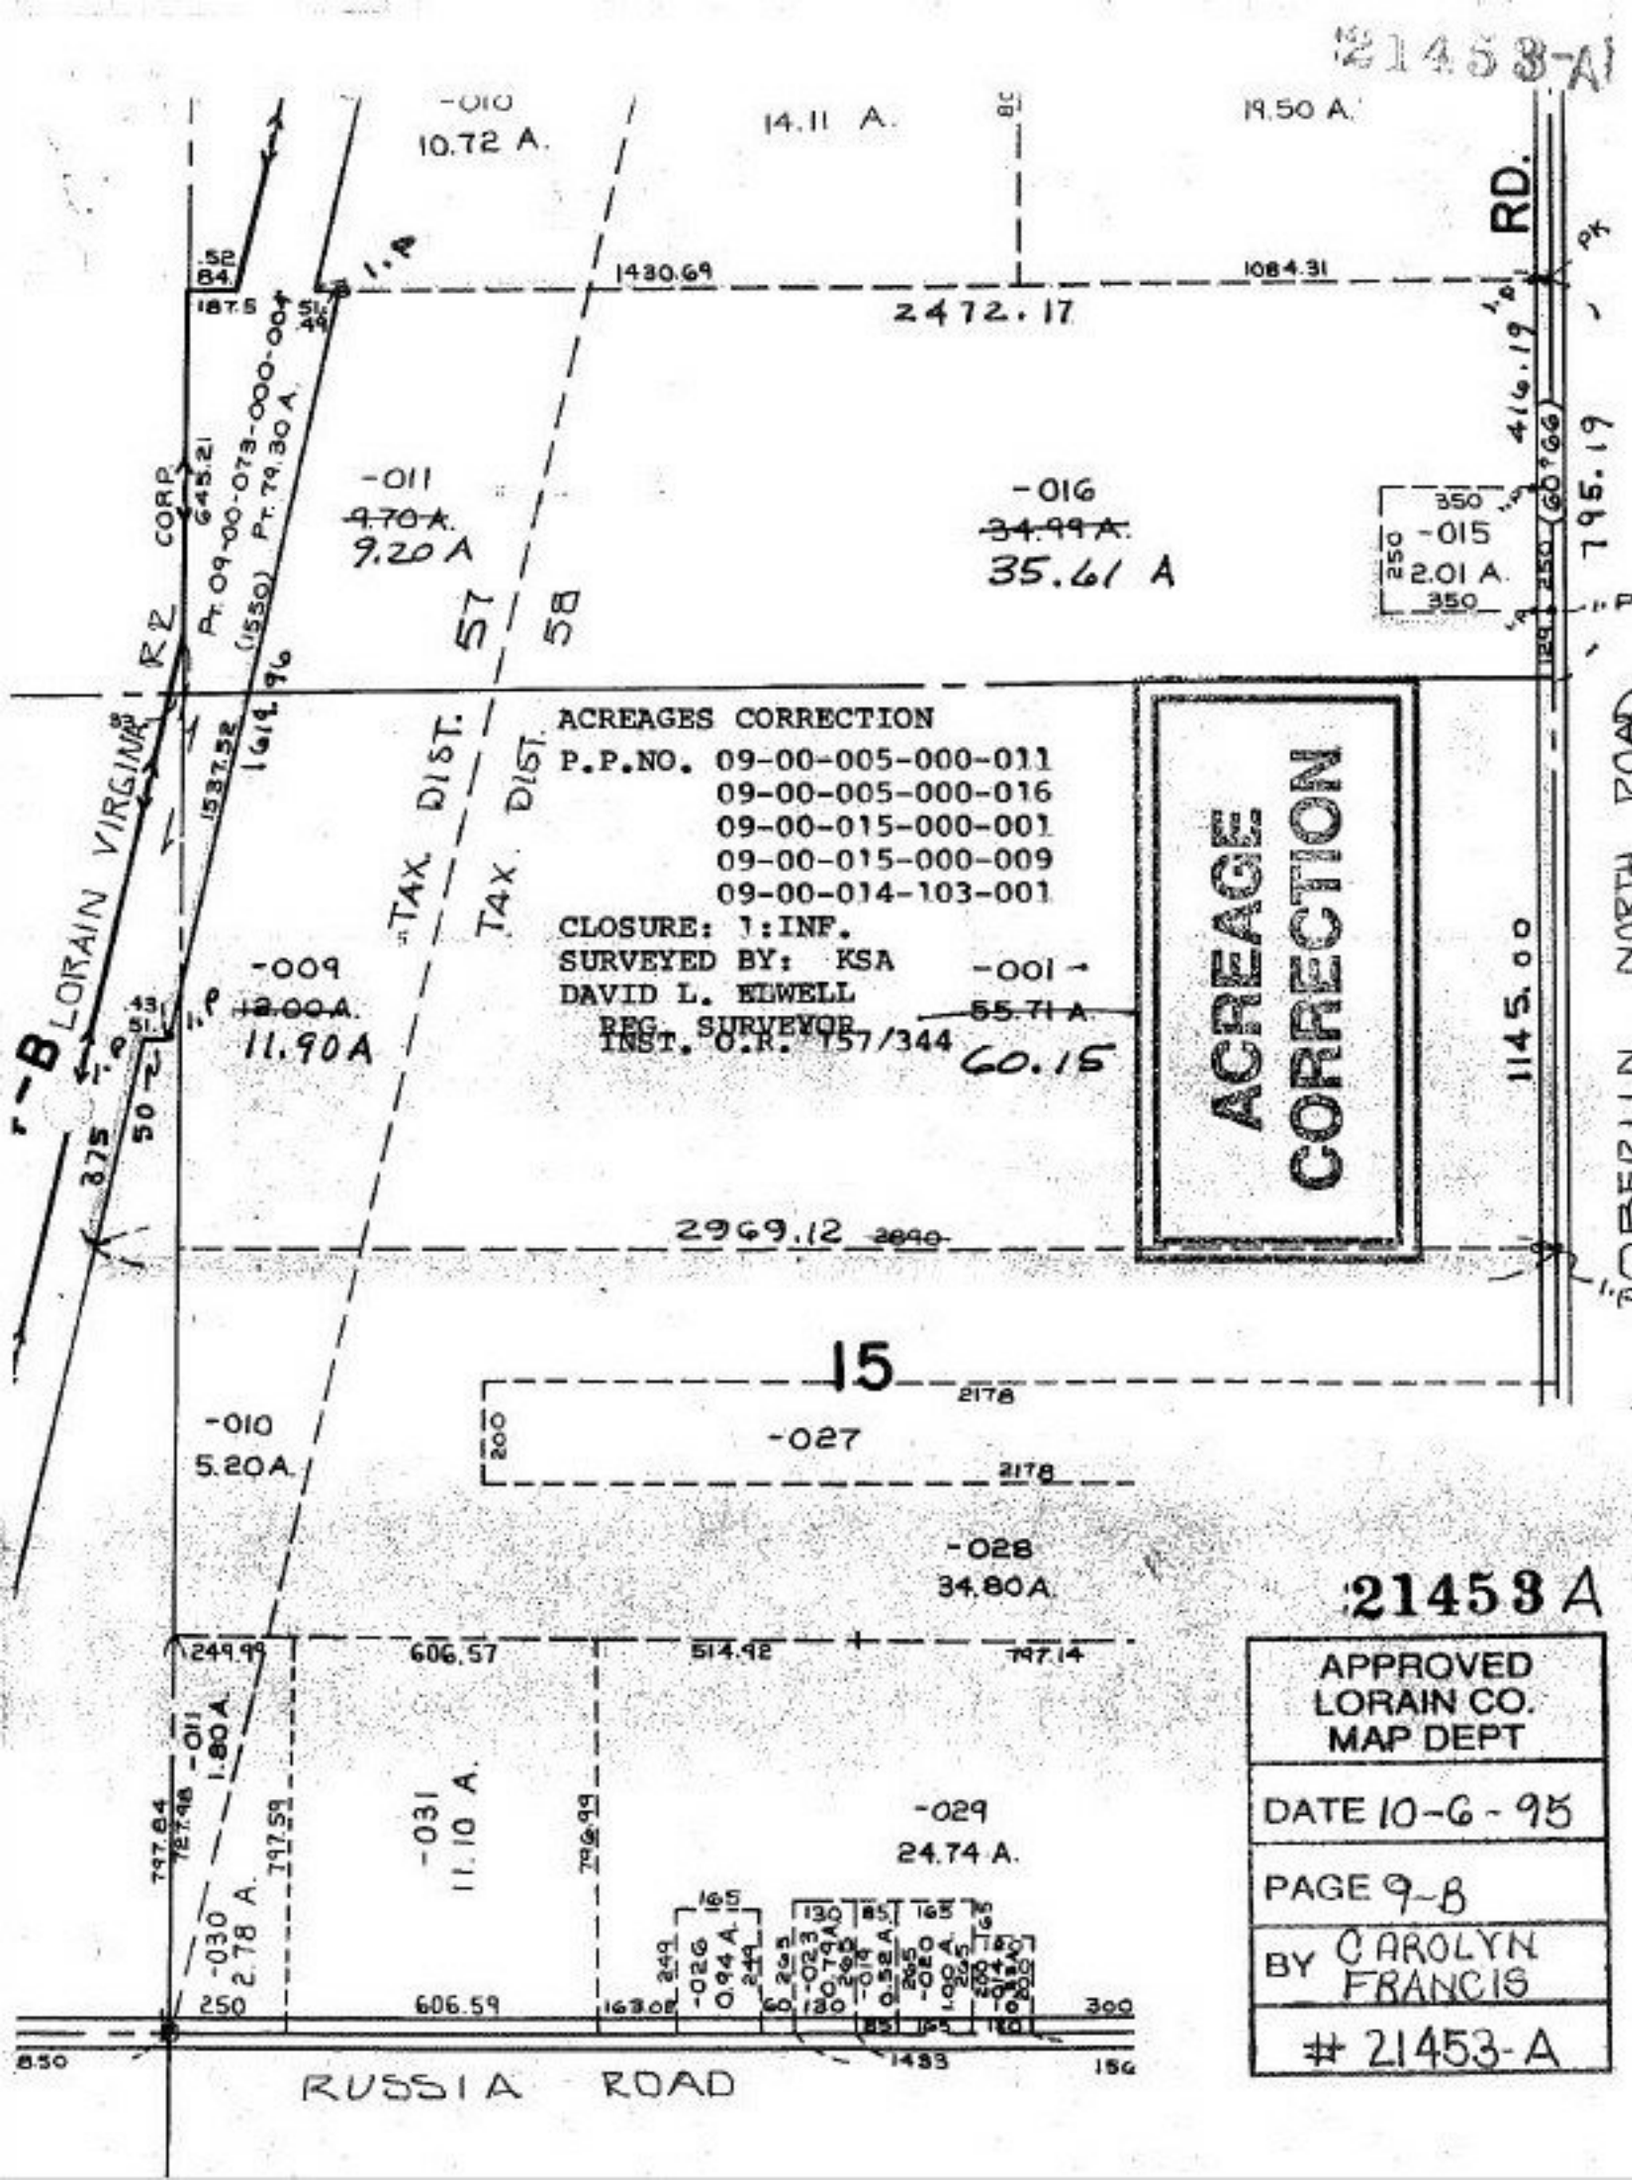

21453 A

APPROVED LORAIN CO. MAP DEPT
DATE 10-6-95
PAGE 9-B
BY CAROLYN FRANCIS
21453-A