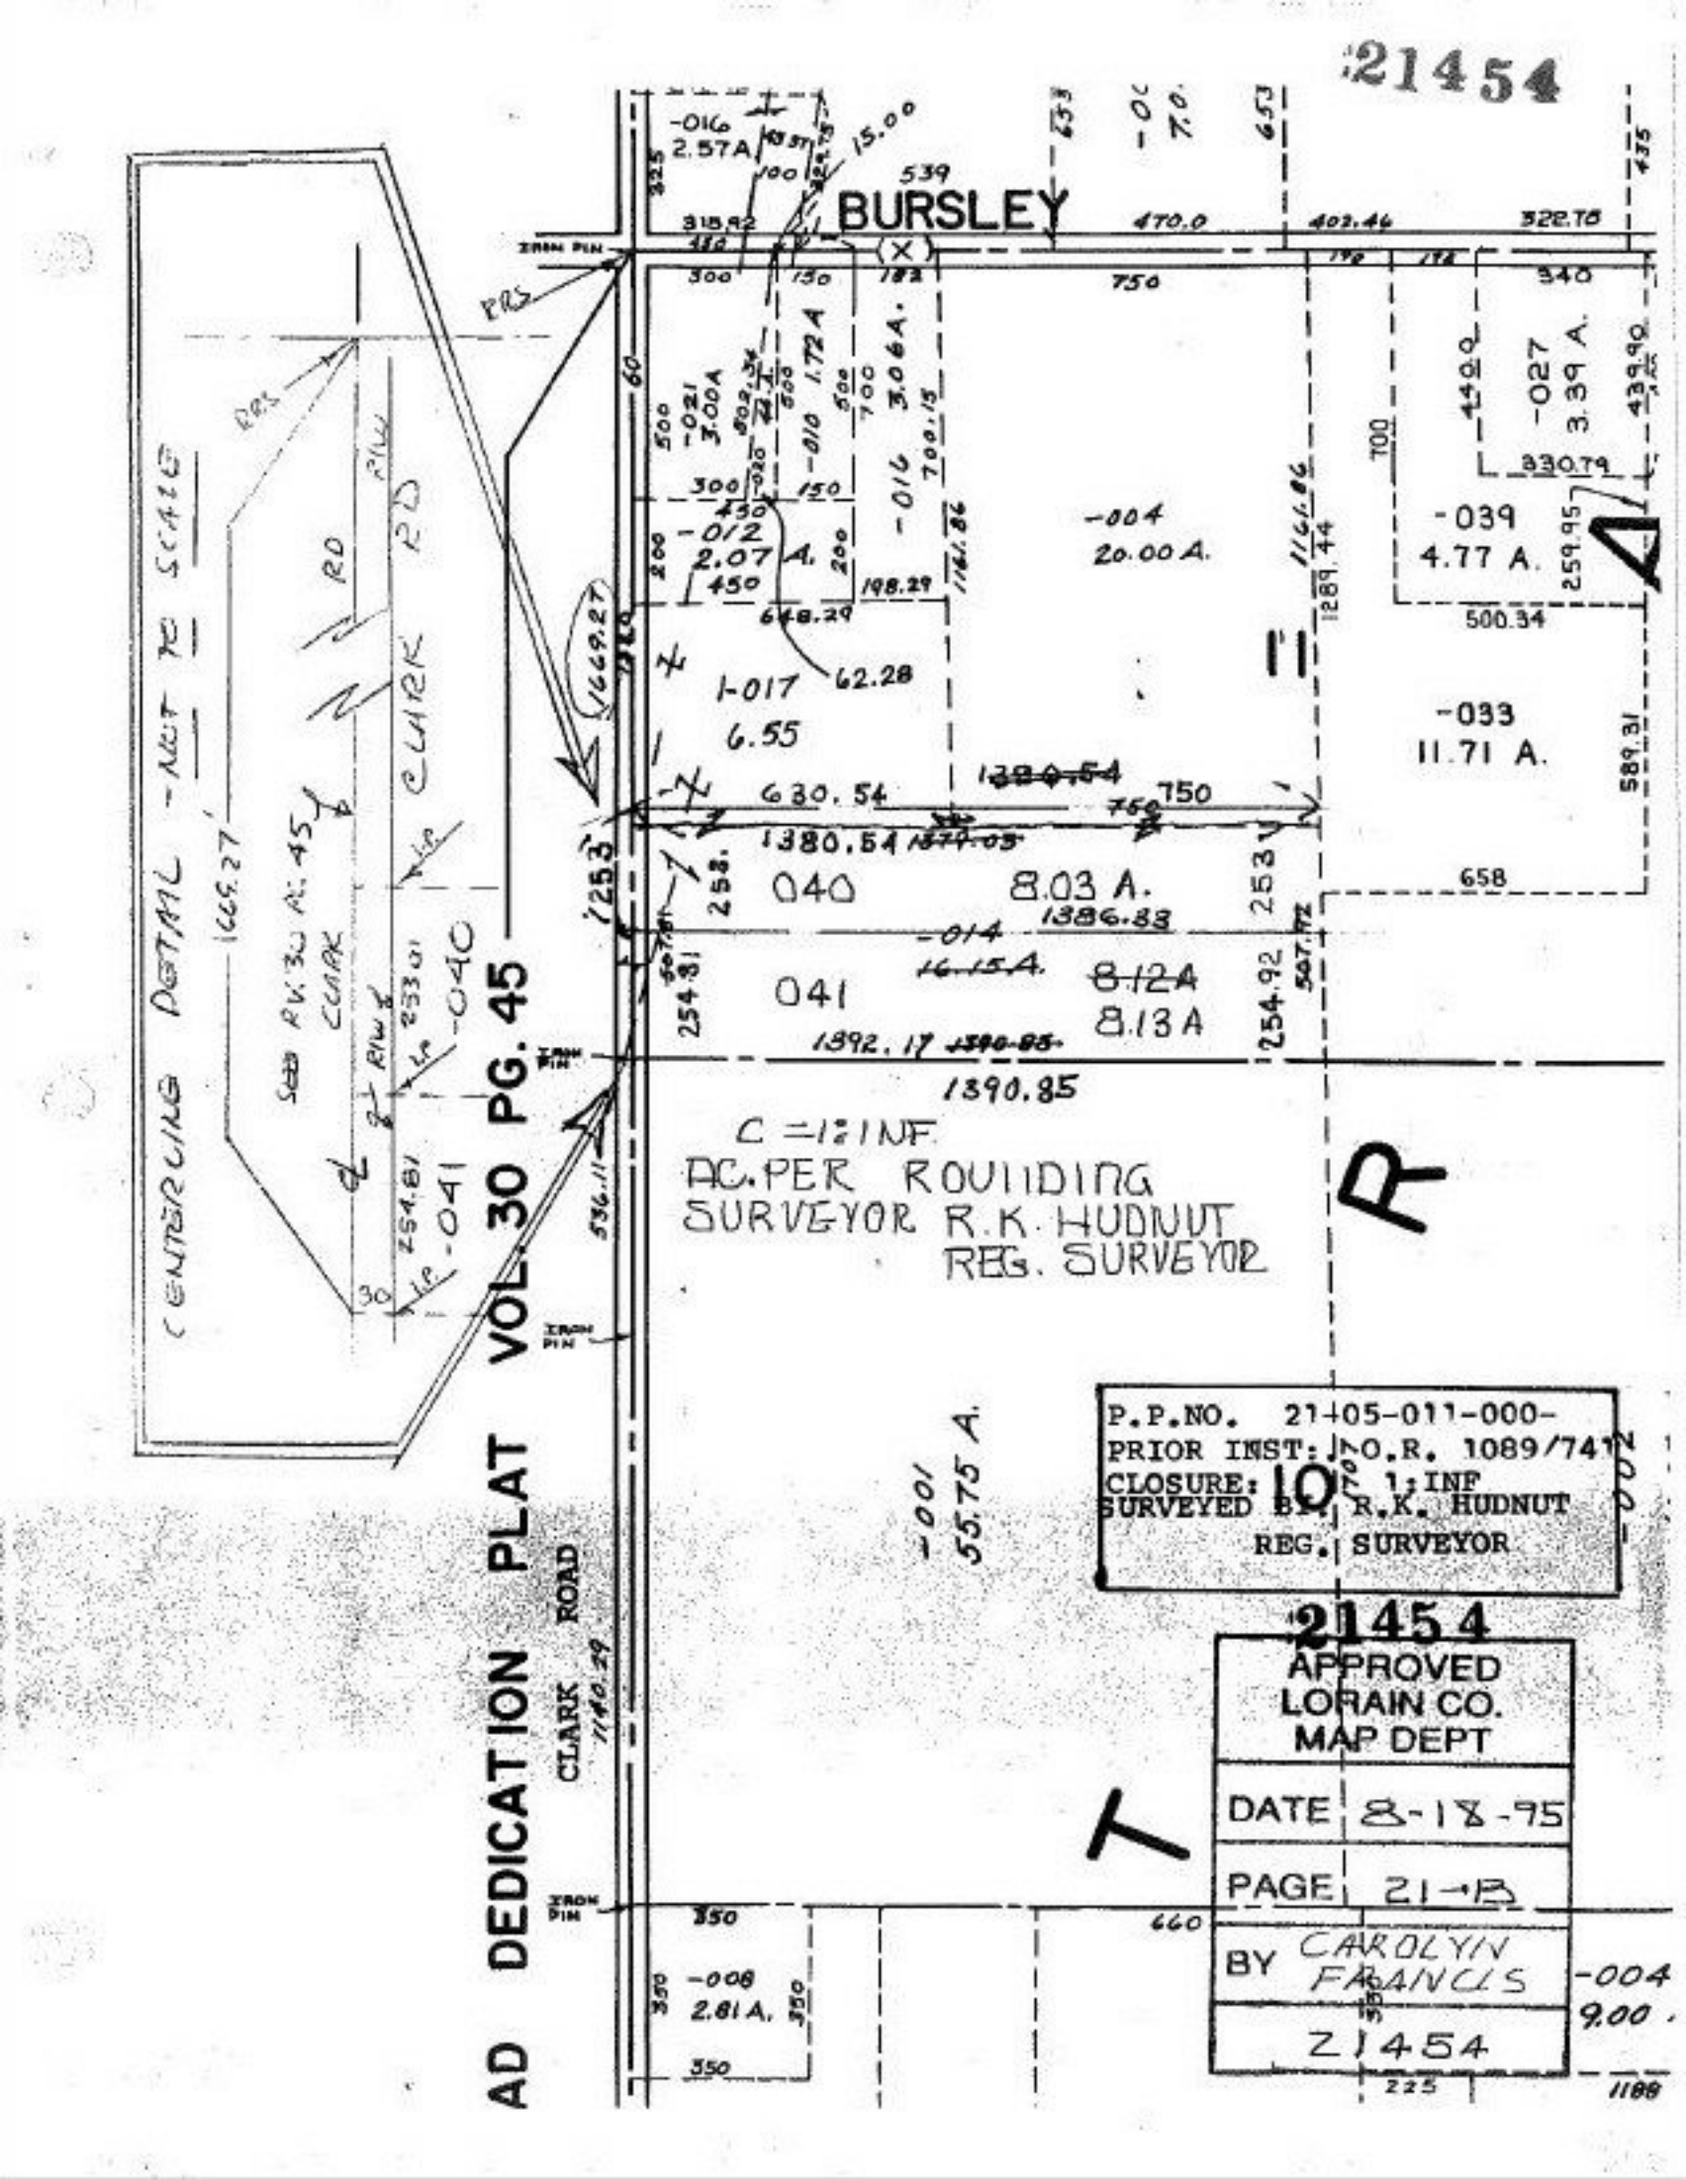
21454
BURSLEY
CENTERLINE DETAIL - NOT TO SCALE
SEE RV. 30 PG. 45
CLARK
RD
CLARK RD
AD DEDICATION PLAT VOL. 30 PG. 45
CLARK ROAD
-016
2.57A
-021
3.00A
-010 1.72A
-016 3.06A.
-012
2.07 A.
-004
20.00 A.
-027
3.39 A.
-039
4.77 A.
-033
11.71 A.
1-017
6.55
040
8.03 A.
041
8.13A
-014
16.15A.
-001
55.75 A.
-008
2.81 A.
-004
9.00
C = 1:INF
AC. PER ROUNDING
SURVEYOR R.K. HUDNUT
REG. SURVEYOR
P.P.NO. 21-05-011-000-
PRIOR INST: J.O.R. 1089/741
CLOSURE: 1:INF
SURVEYED BY: R.K. HUDNUT
REG. SURVEYOR
21454
APPROVED
LORAIN CO.
MAP DEPT
DATE 8-18-95
PAGE 21-B
BY CAROLYN FRANCIS
21454
IRON PIN
1669.27
1253
1390.54
1380.54
1392.17
1390.85
1386.88
1289.44
1161.86
589.31
1189