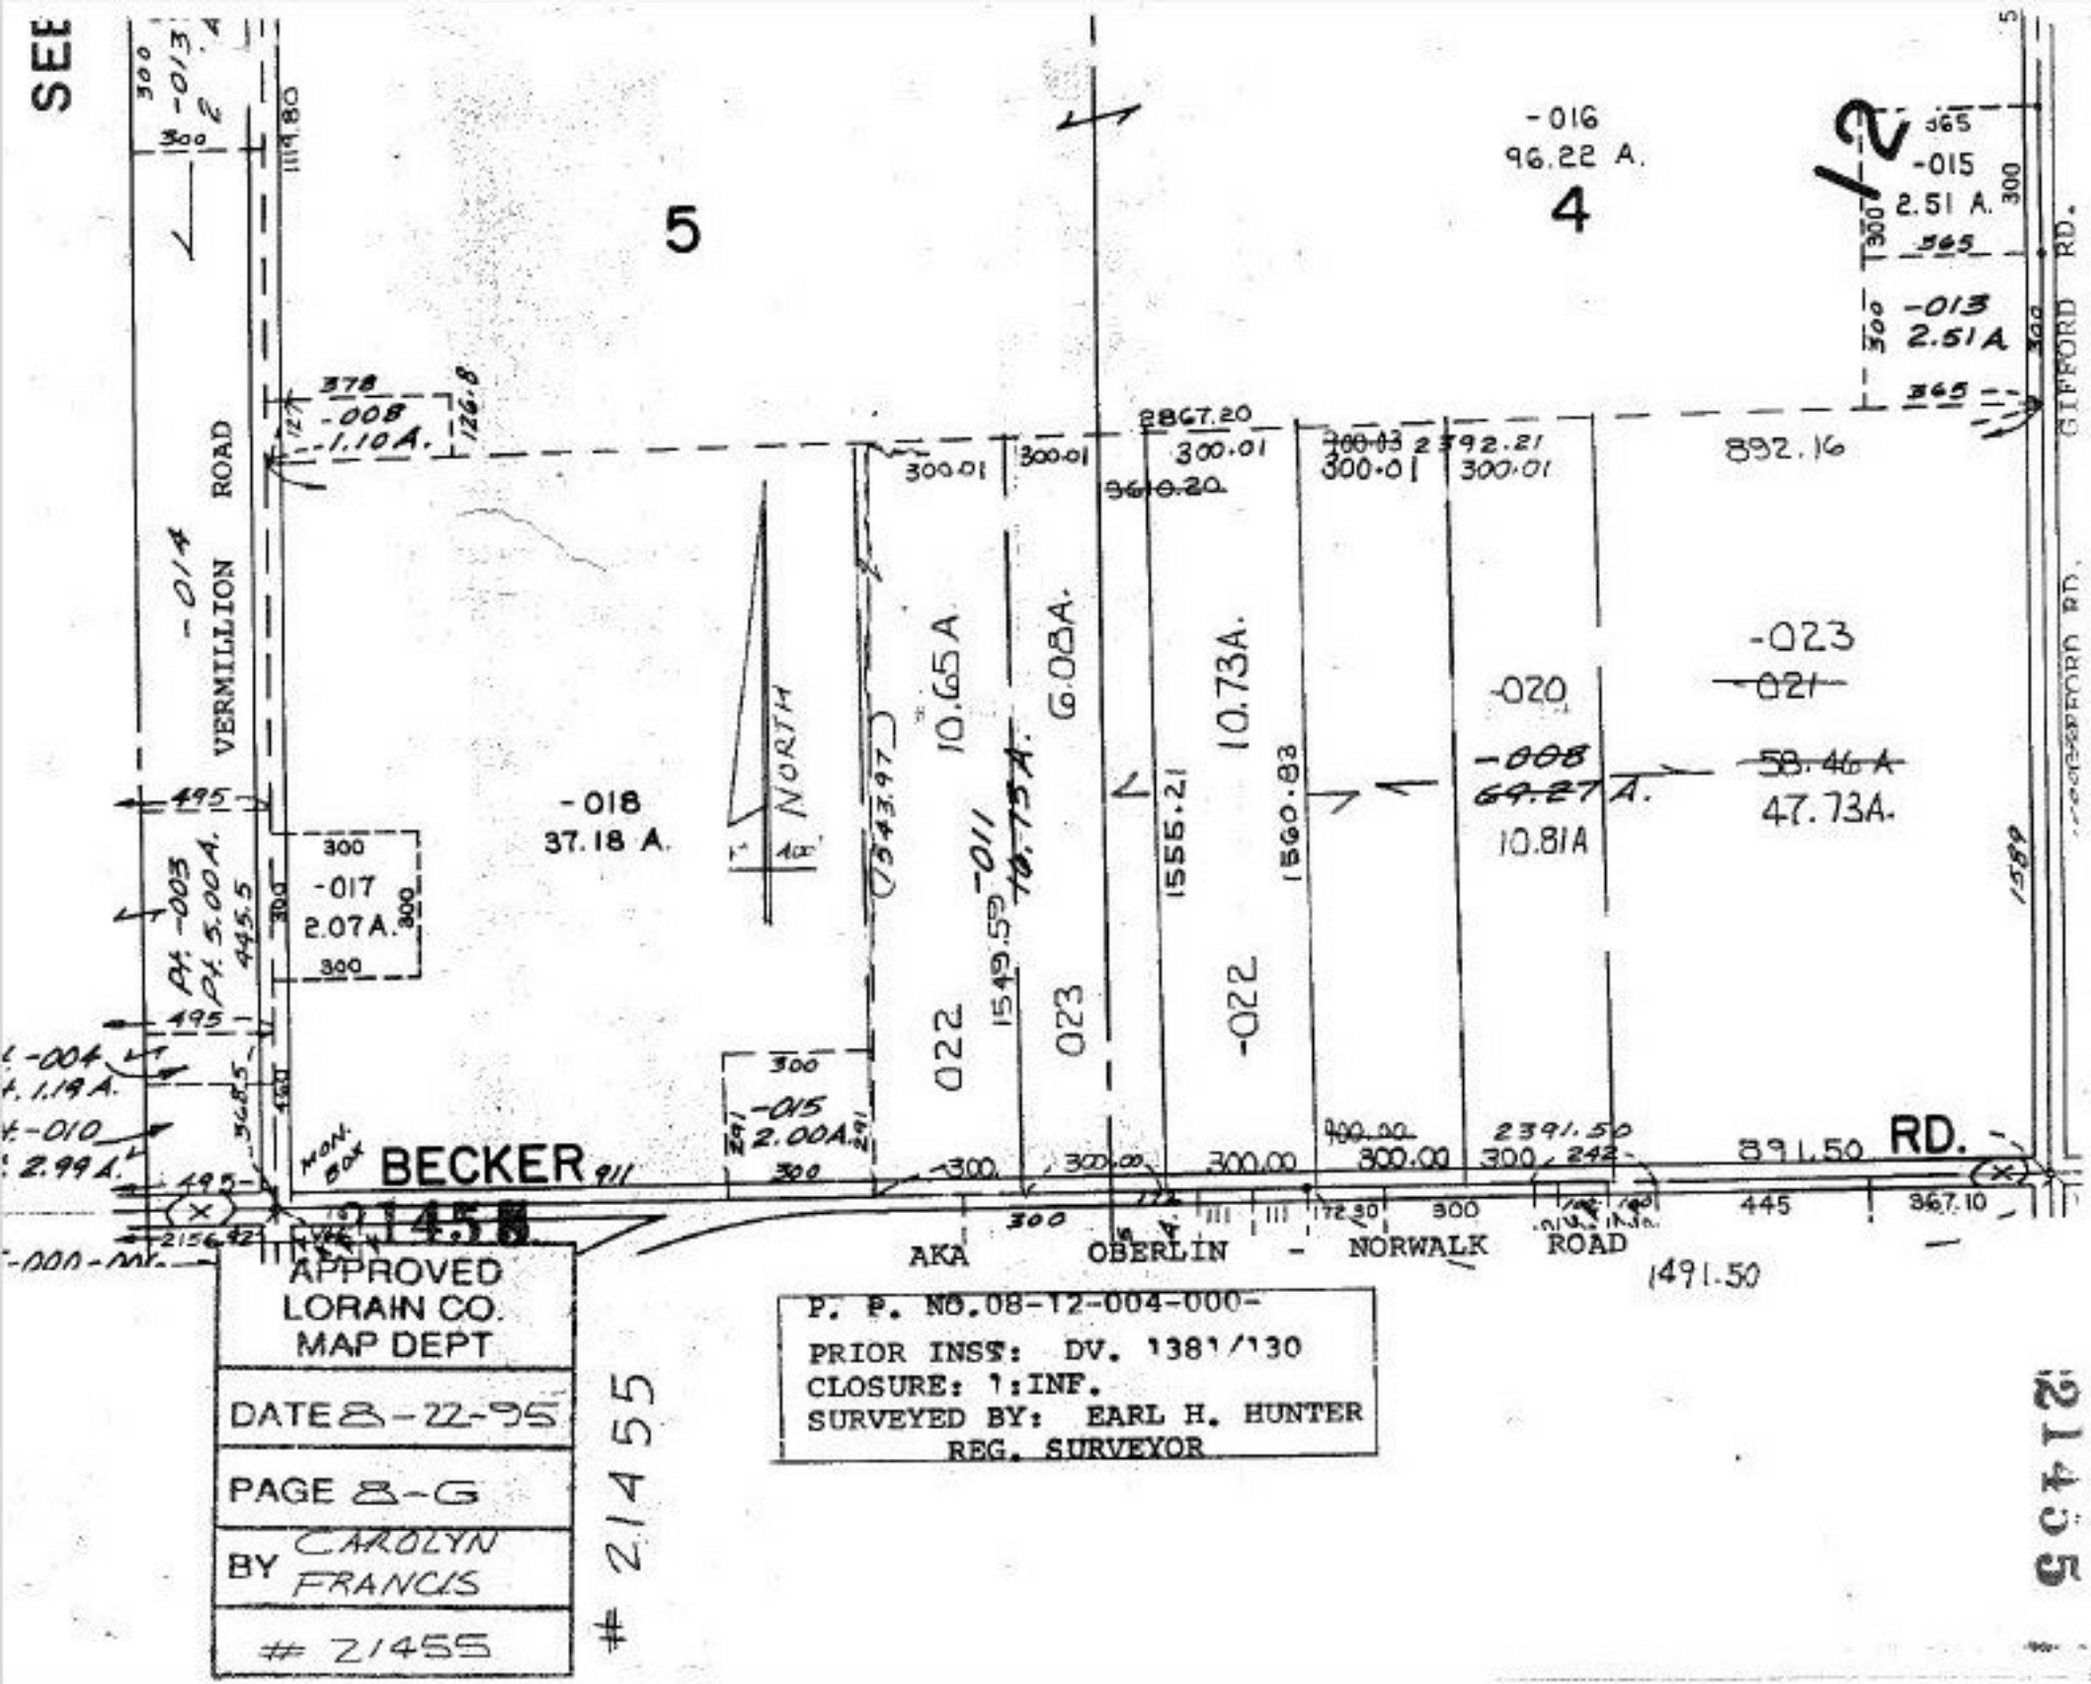
SEE
5
4
-016
96.22 A.
-015
2.51 A.
-013
2.51A
-014
VERMILLION ROAD
-008
1.10A.
-018
37.18 A.
-017
2.07A.
-003
Pt. 5.00A.
-004
1.19A.
-010
2.99A.
-011
10.75A.
10.65A.
6.03A.
10.73A.
-020
-008
69.27 A.
10.81A
-023
-021
58.46A
47.73A.
022
023
-022
NORTH
-015
2.00A.
BECKER RD.
AKA OBERLIN - NORWALK ROAD
GIFFORD RD.
1491.50
APPROVED
LORAIN CO.
MAP DEPT
DATE 8-22-95
PAGE 8-G
BY CAROLYN FRANCIS
21455
P. P. NO. 08-12-004-000-
PRIOR INST: DV. 1381/130
CLOSURE: 1:INF.
SURVEYED BY: EARL H. HUNTER
REG. SURVEYOR
21455
5 of 12