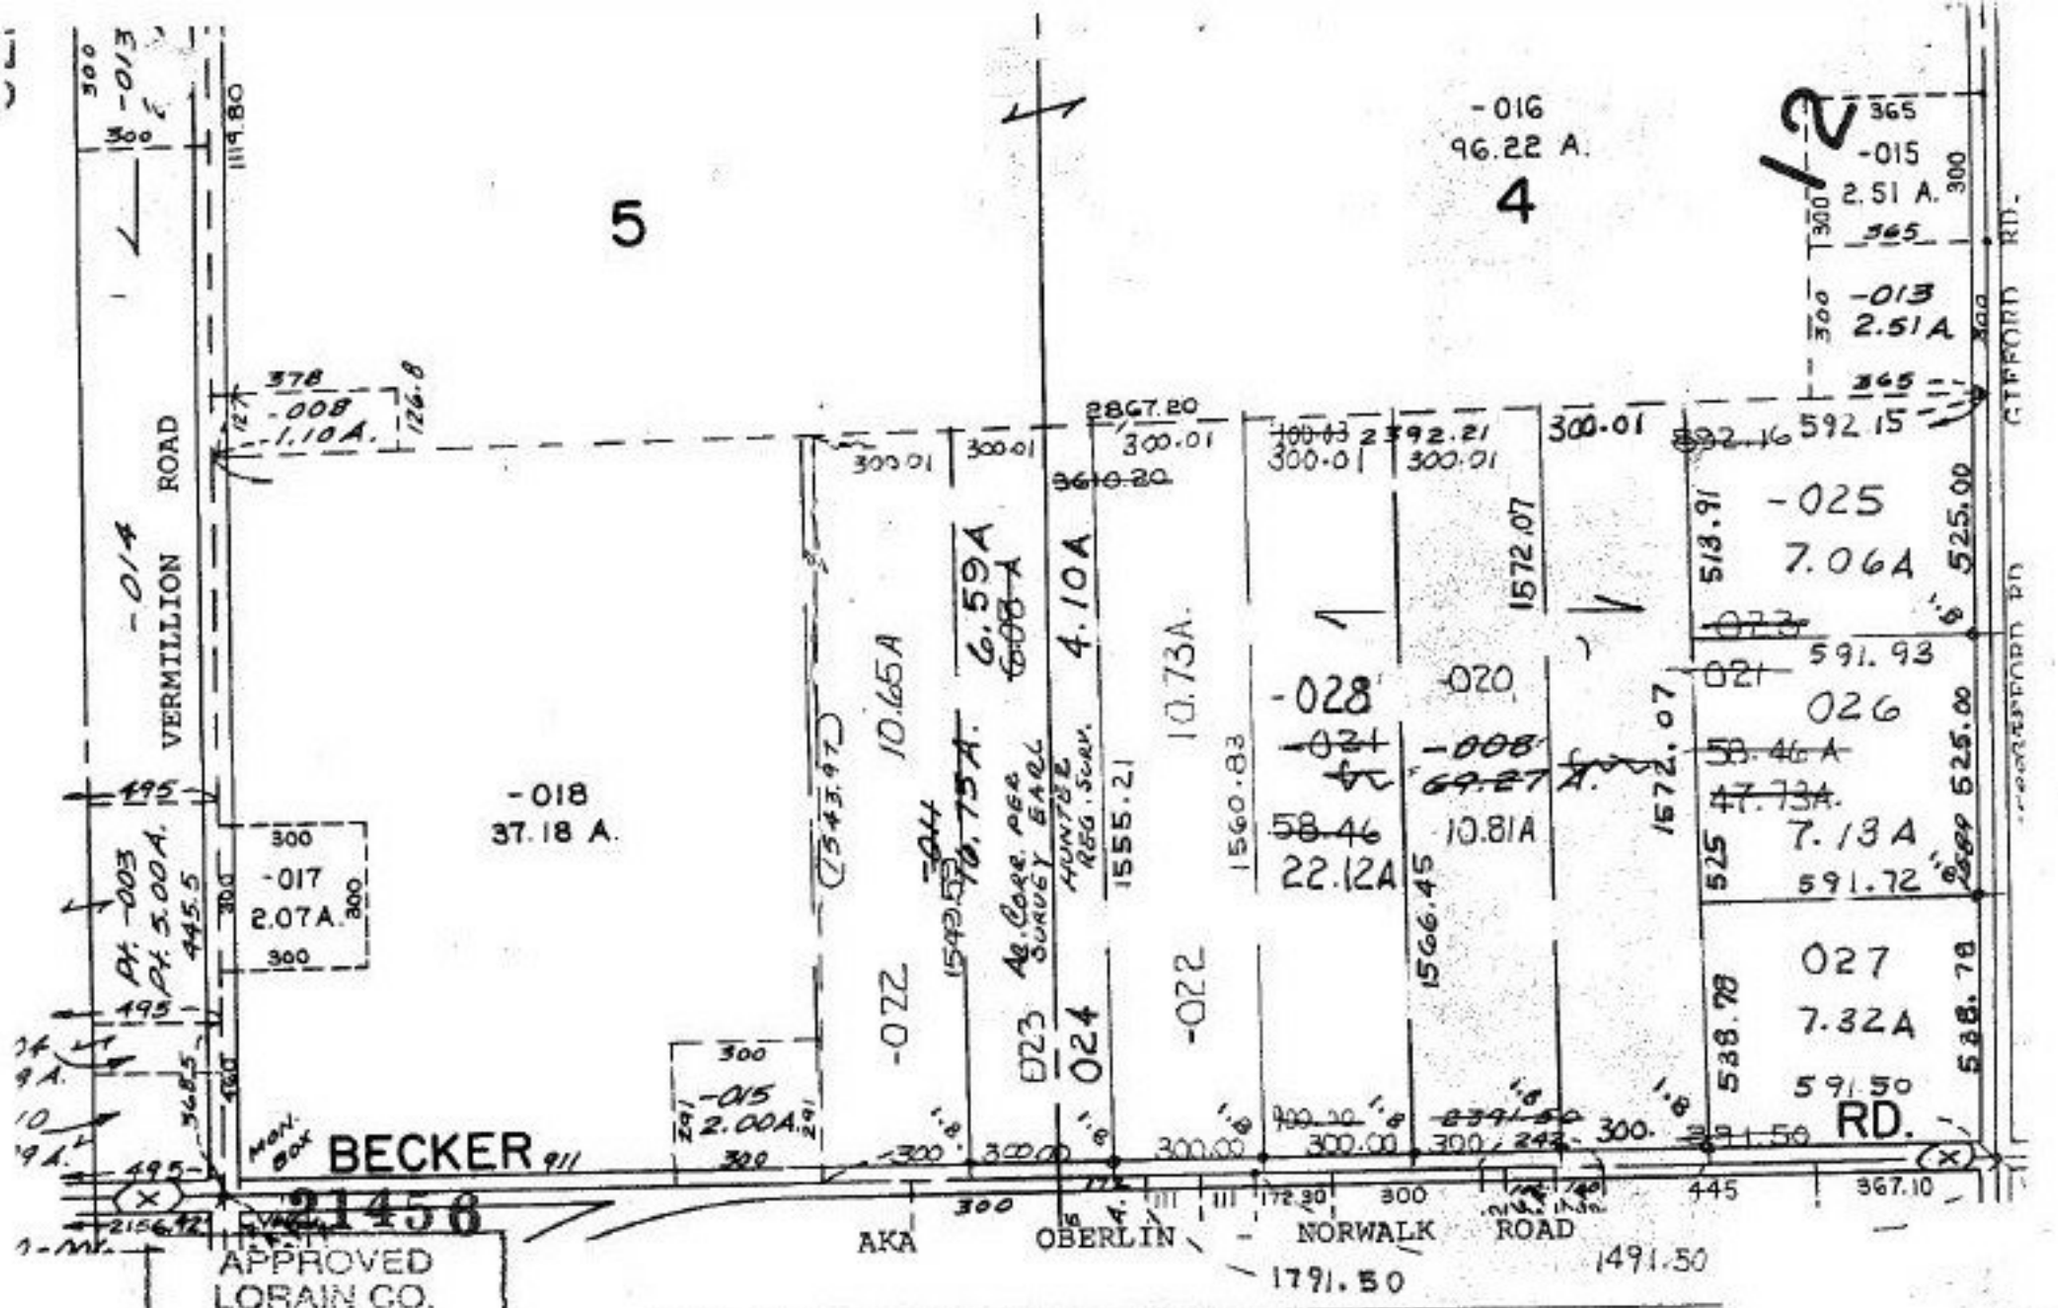
5
4
-016
96.22 A.
-015
2.51 A.
-013
2.51A
-014
VERMILLION ROAD
-018
37.18 A.
-008
1.10A.
-017
2.07A.
-003
Pt. 5.00A.
-028
-008
69.27 A.
10.81A
22.12A
-025
7.06A
026
7.13A
027
7.32A
-022
10.65A
10.73A.
6.59A
4.10A
6.75A.
024
023
BECKER RD.
911
21456
AKA
OBERLIN - NORWALK ROAD
CLIFFORD RD.
APPROVED
LORAIN CO.
MAP DEPT
DATE 9-6-95
PAGE 8-G
BY CAROLYN FRANCIS
#21456
P.P. NO. 08-12-004-000- PRIOR INST: DV. 1381/130
08-12-005-000- CLOSURE: 10.69 ac. 1:INF.
CLOSURE: 7.06ac. 0.04:10,000 7.13ac. 0.01:10,000
7.32ac. 0.02:10,000
SURVEYED BY: EARL H. HUNTER REG. SURVEYOR