21457-A

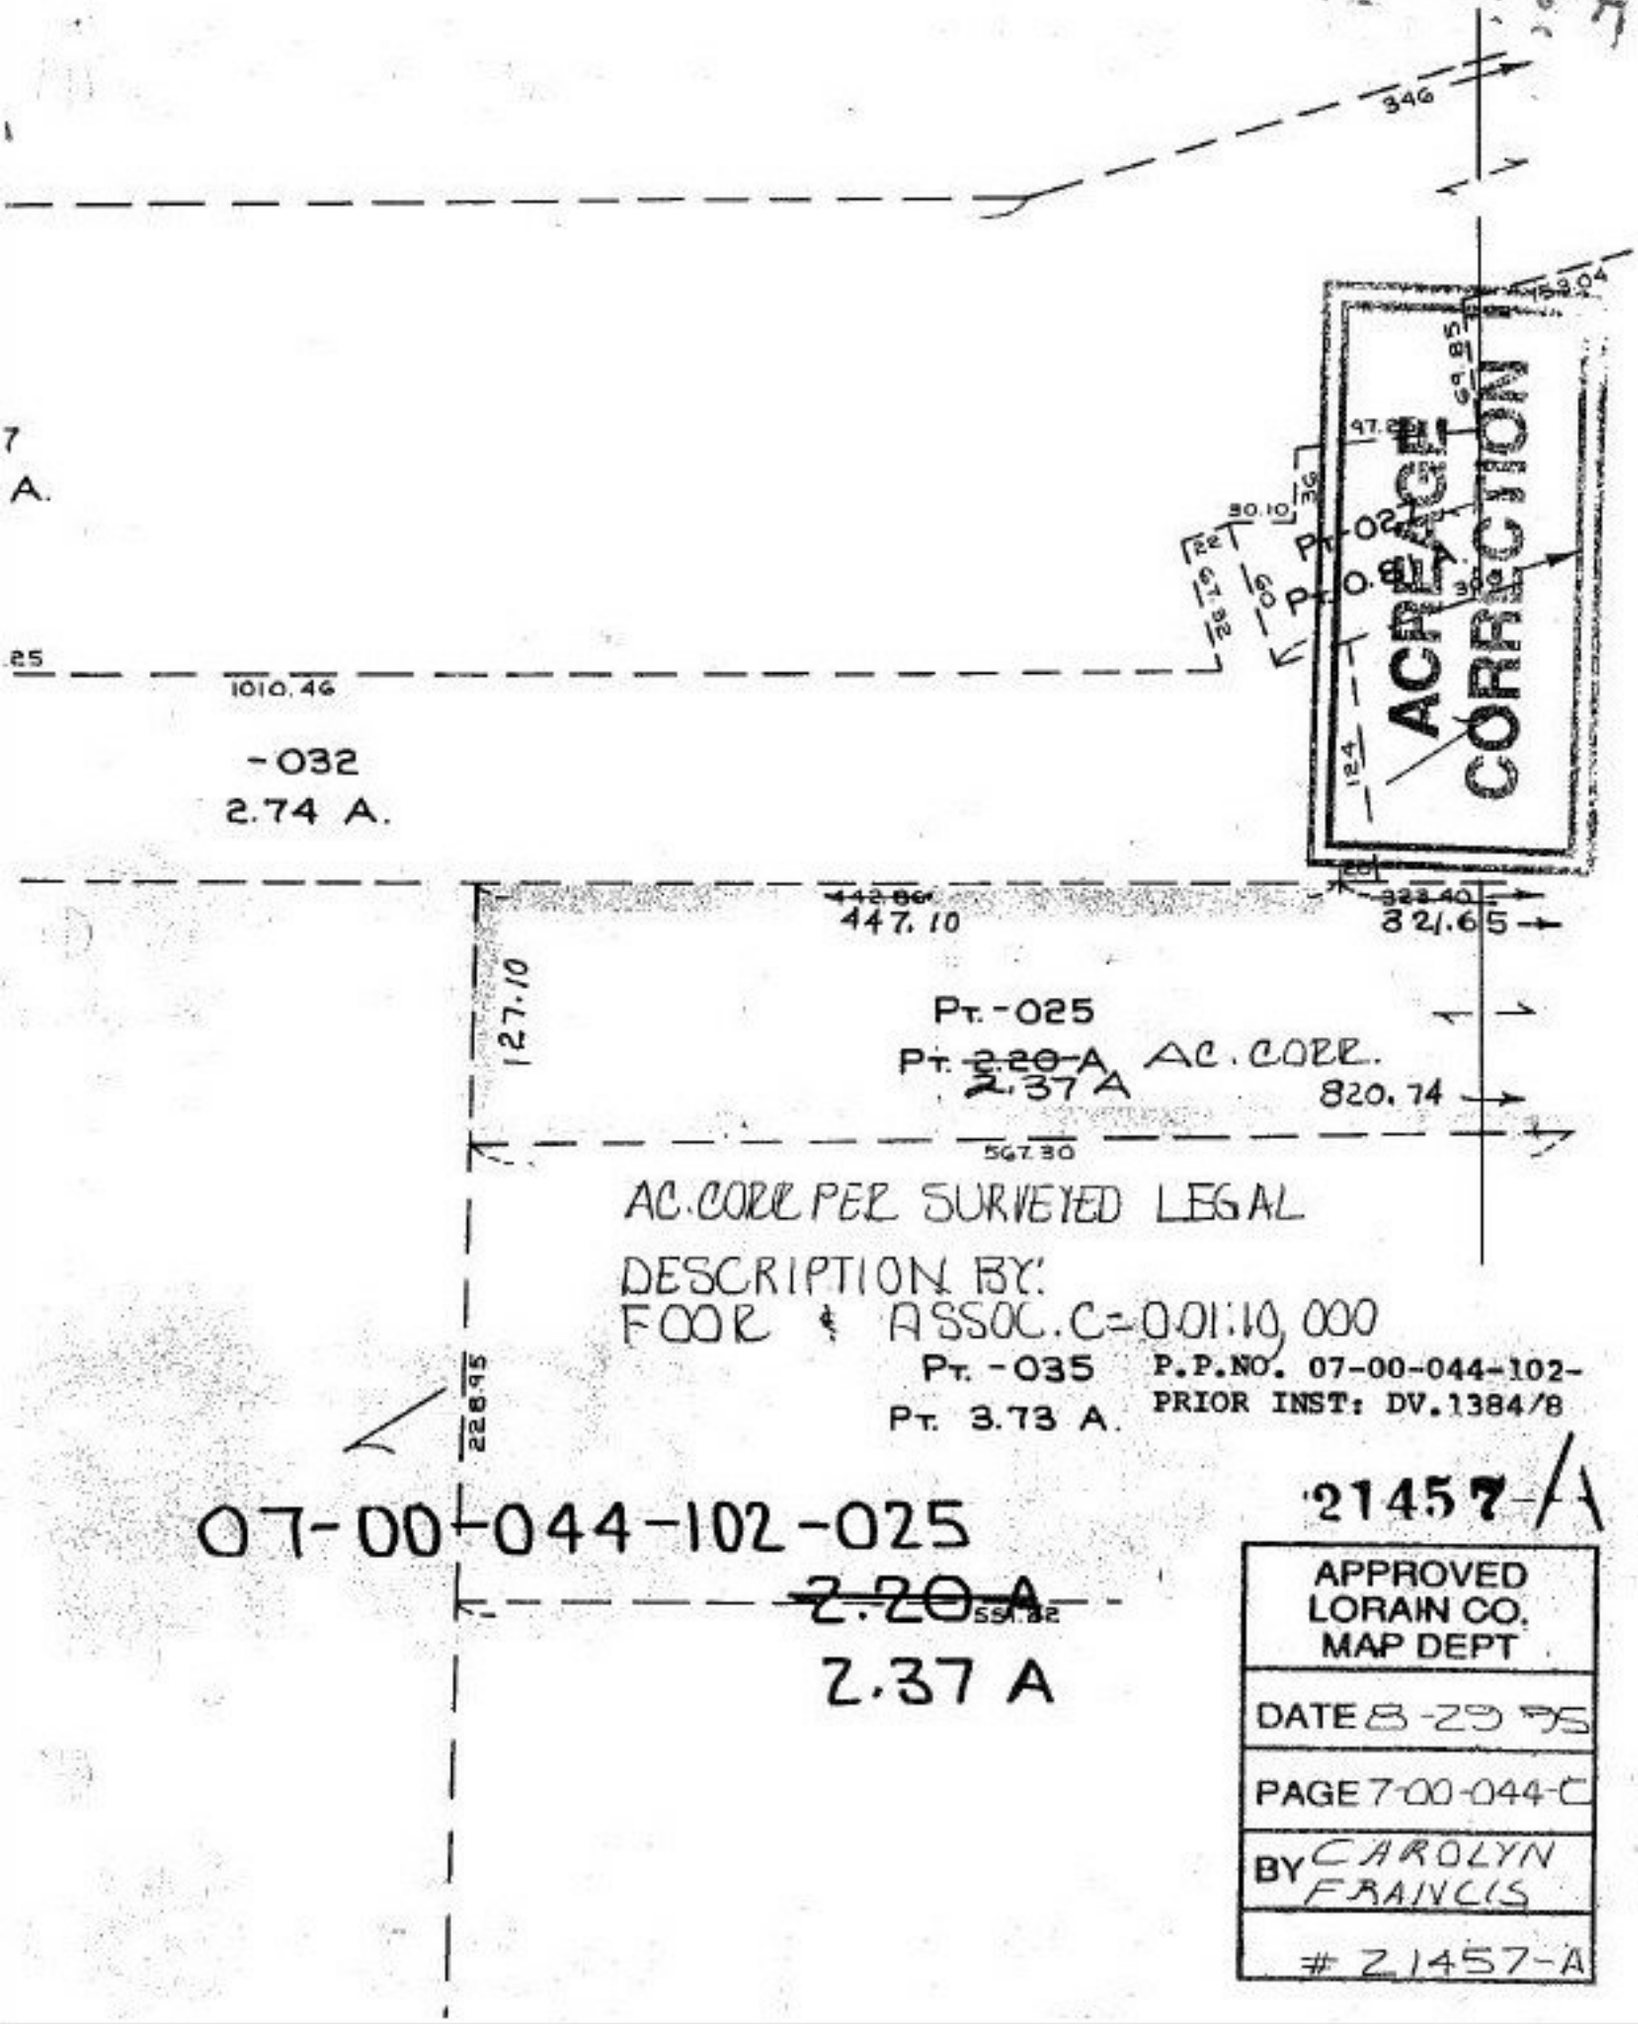
346
153.04
69.85
47.2
30.10
Pt-027
Pt-0.81 A.
ACREAGE CORRECTION
124
1010.46
-032
2.74 A.
442.86
447.10
323.40
321.65
127.10
Pt.-025
Pt. ~~2.20 A~~ 2.37 A AC. CORR.
820.74
567.30
AC. CORR PER SURVEYED LEGAL
DESCRIPTION BY:
FOOR & ASSOC. C=0.01:10,000
Pt.-035
Pt. 3.73 A.
P.P.NO. 07-00-044-102-
PRIOR INST: DV.1384/8
228.95
07-00-044-102-025
~~2.20 A~~
551.82
2.37 A
21457-A
APPROVED
LORAIN CO.
MAP DEPT
DATE 8-29-95
PAGE 7-00-044-C
BY CAROLYN FRANCIS
21457-A