21459

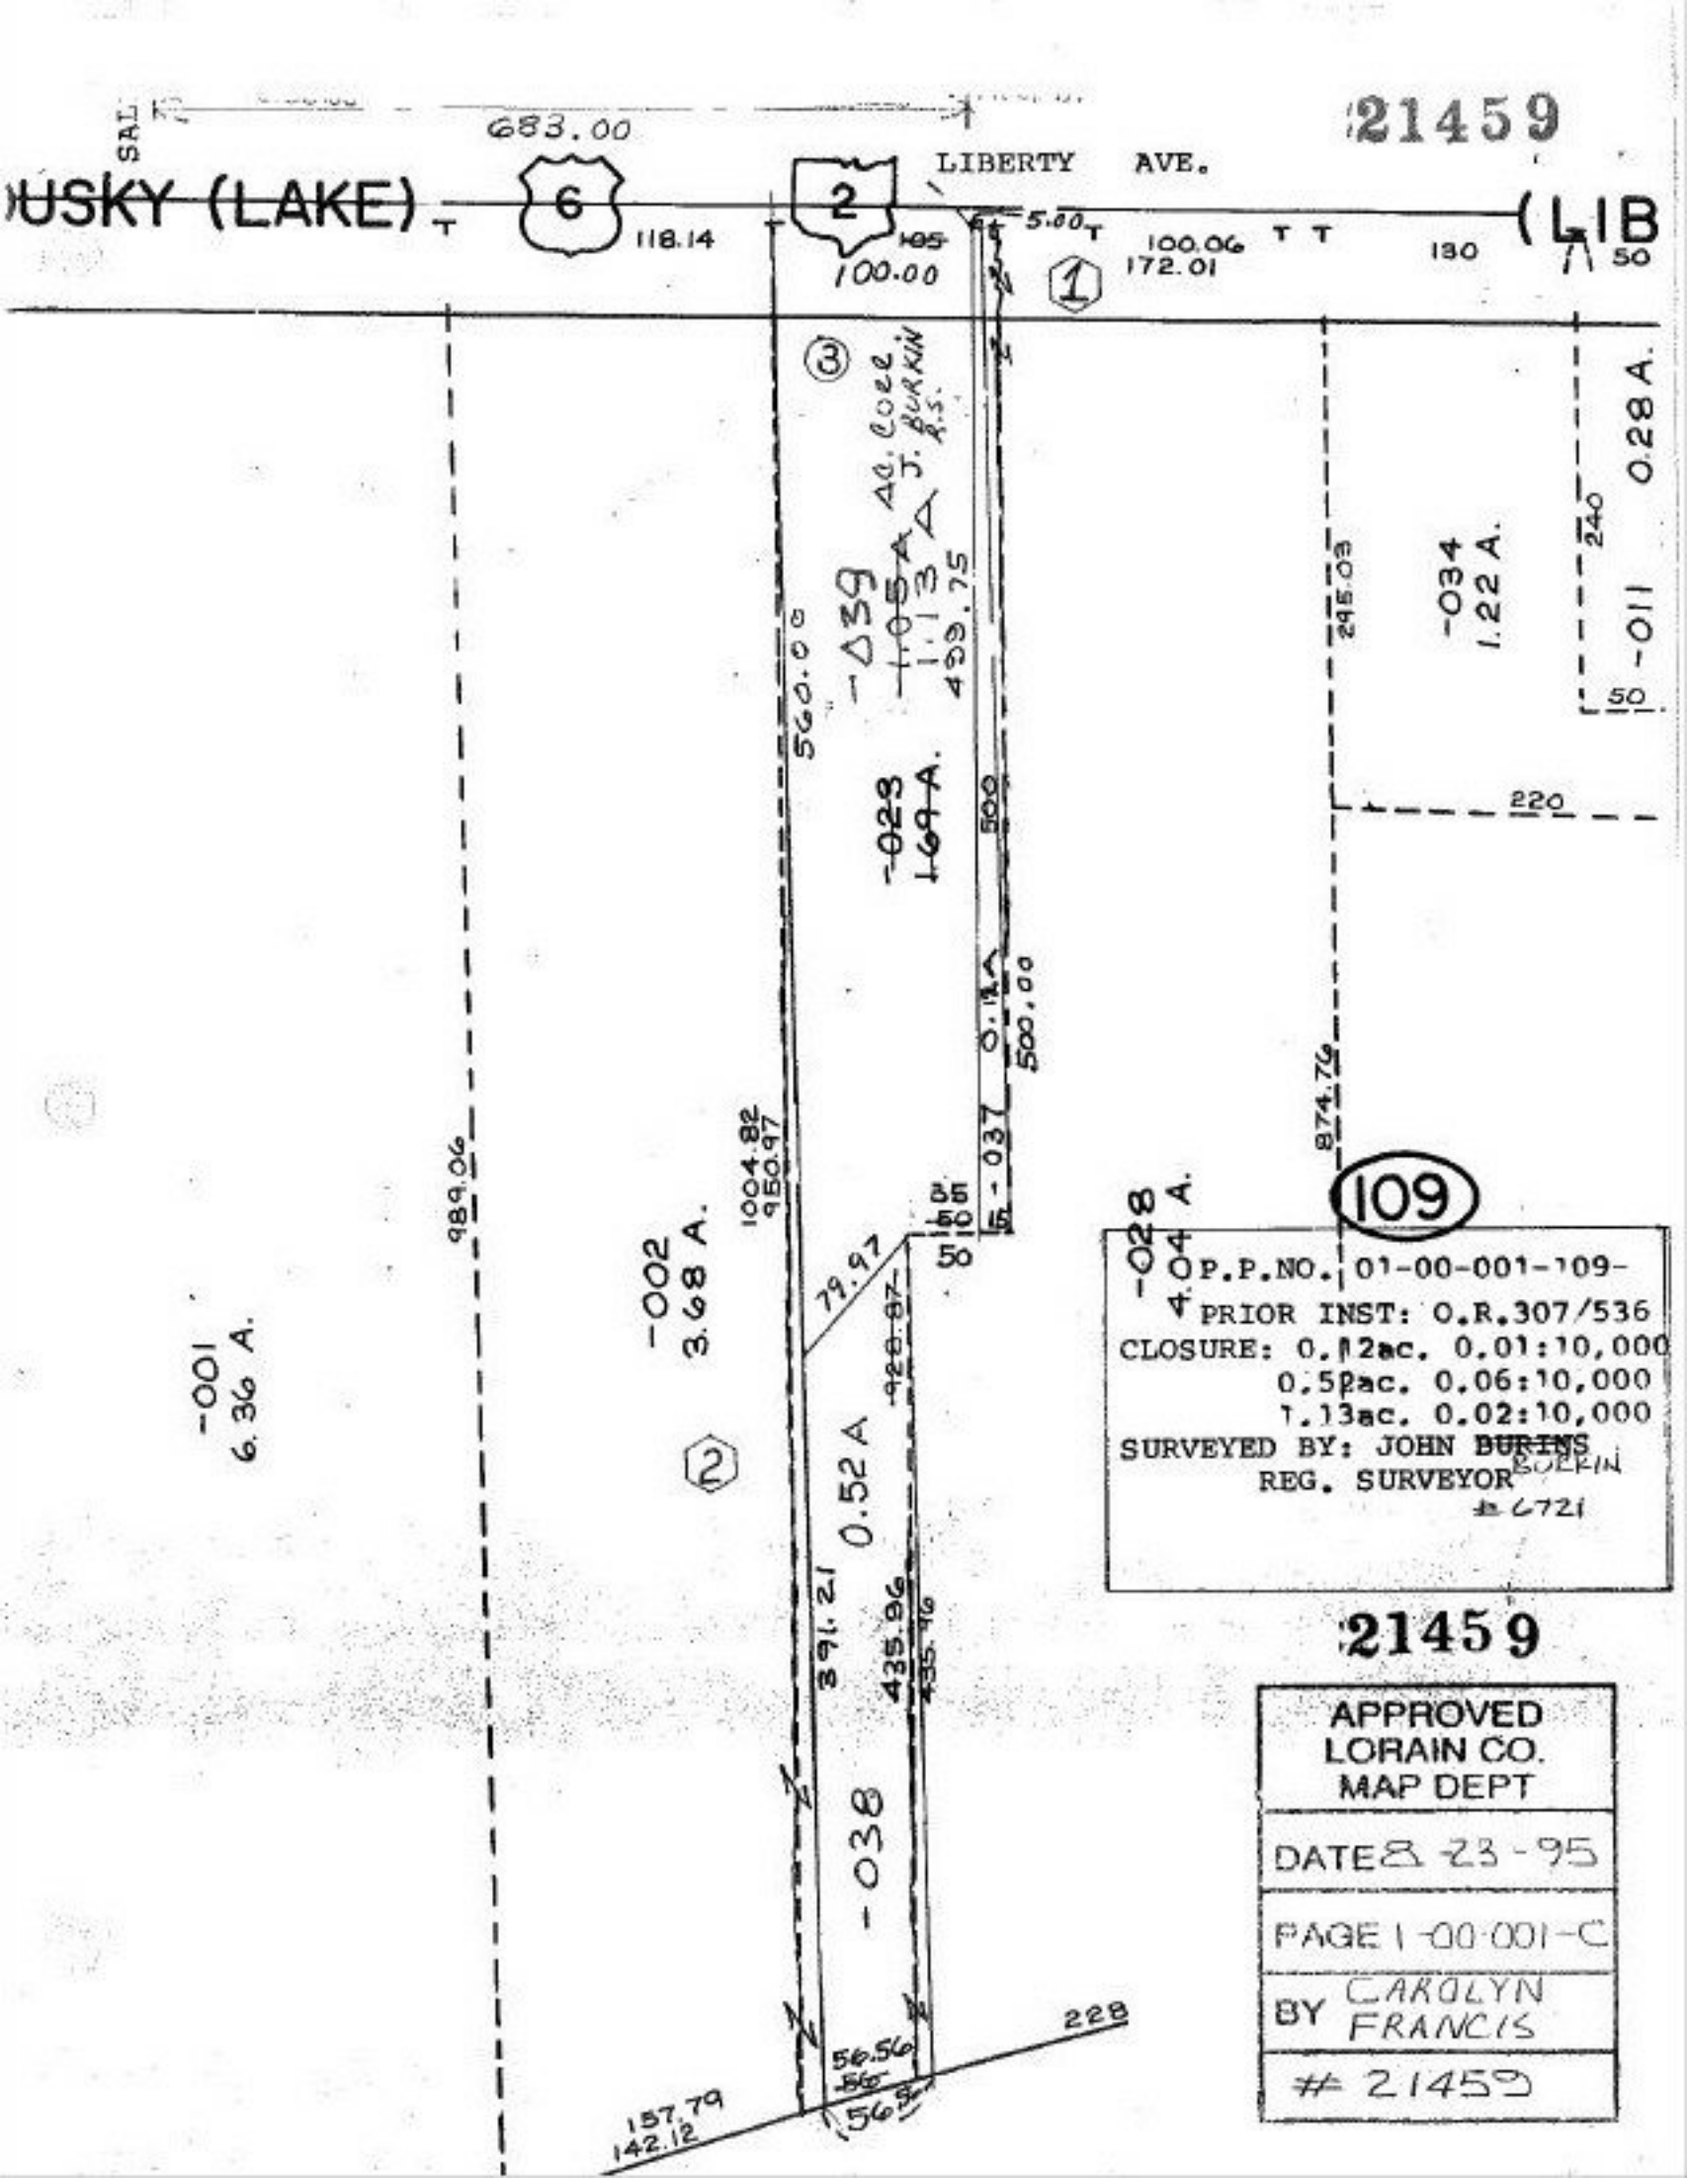

P.P.NO. 01-00-001-109-
PRIOR INST: O.R.307/536
CLOSURE: 0.12ac. 0.01:10,000
0.52ac. 0.06:10,000
1.13ac. 0.02:10,000
SURVEYED BY: JOHN ~~BURINS~~ BURKIN
REG. SURVEYOR
#6721

21459

APPROVED
LORAIN CO.
MAP DEPT

DATE 8-23-95

PAGE 1-00-001-C

BY CAROLYN FRANCIS

21459