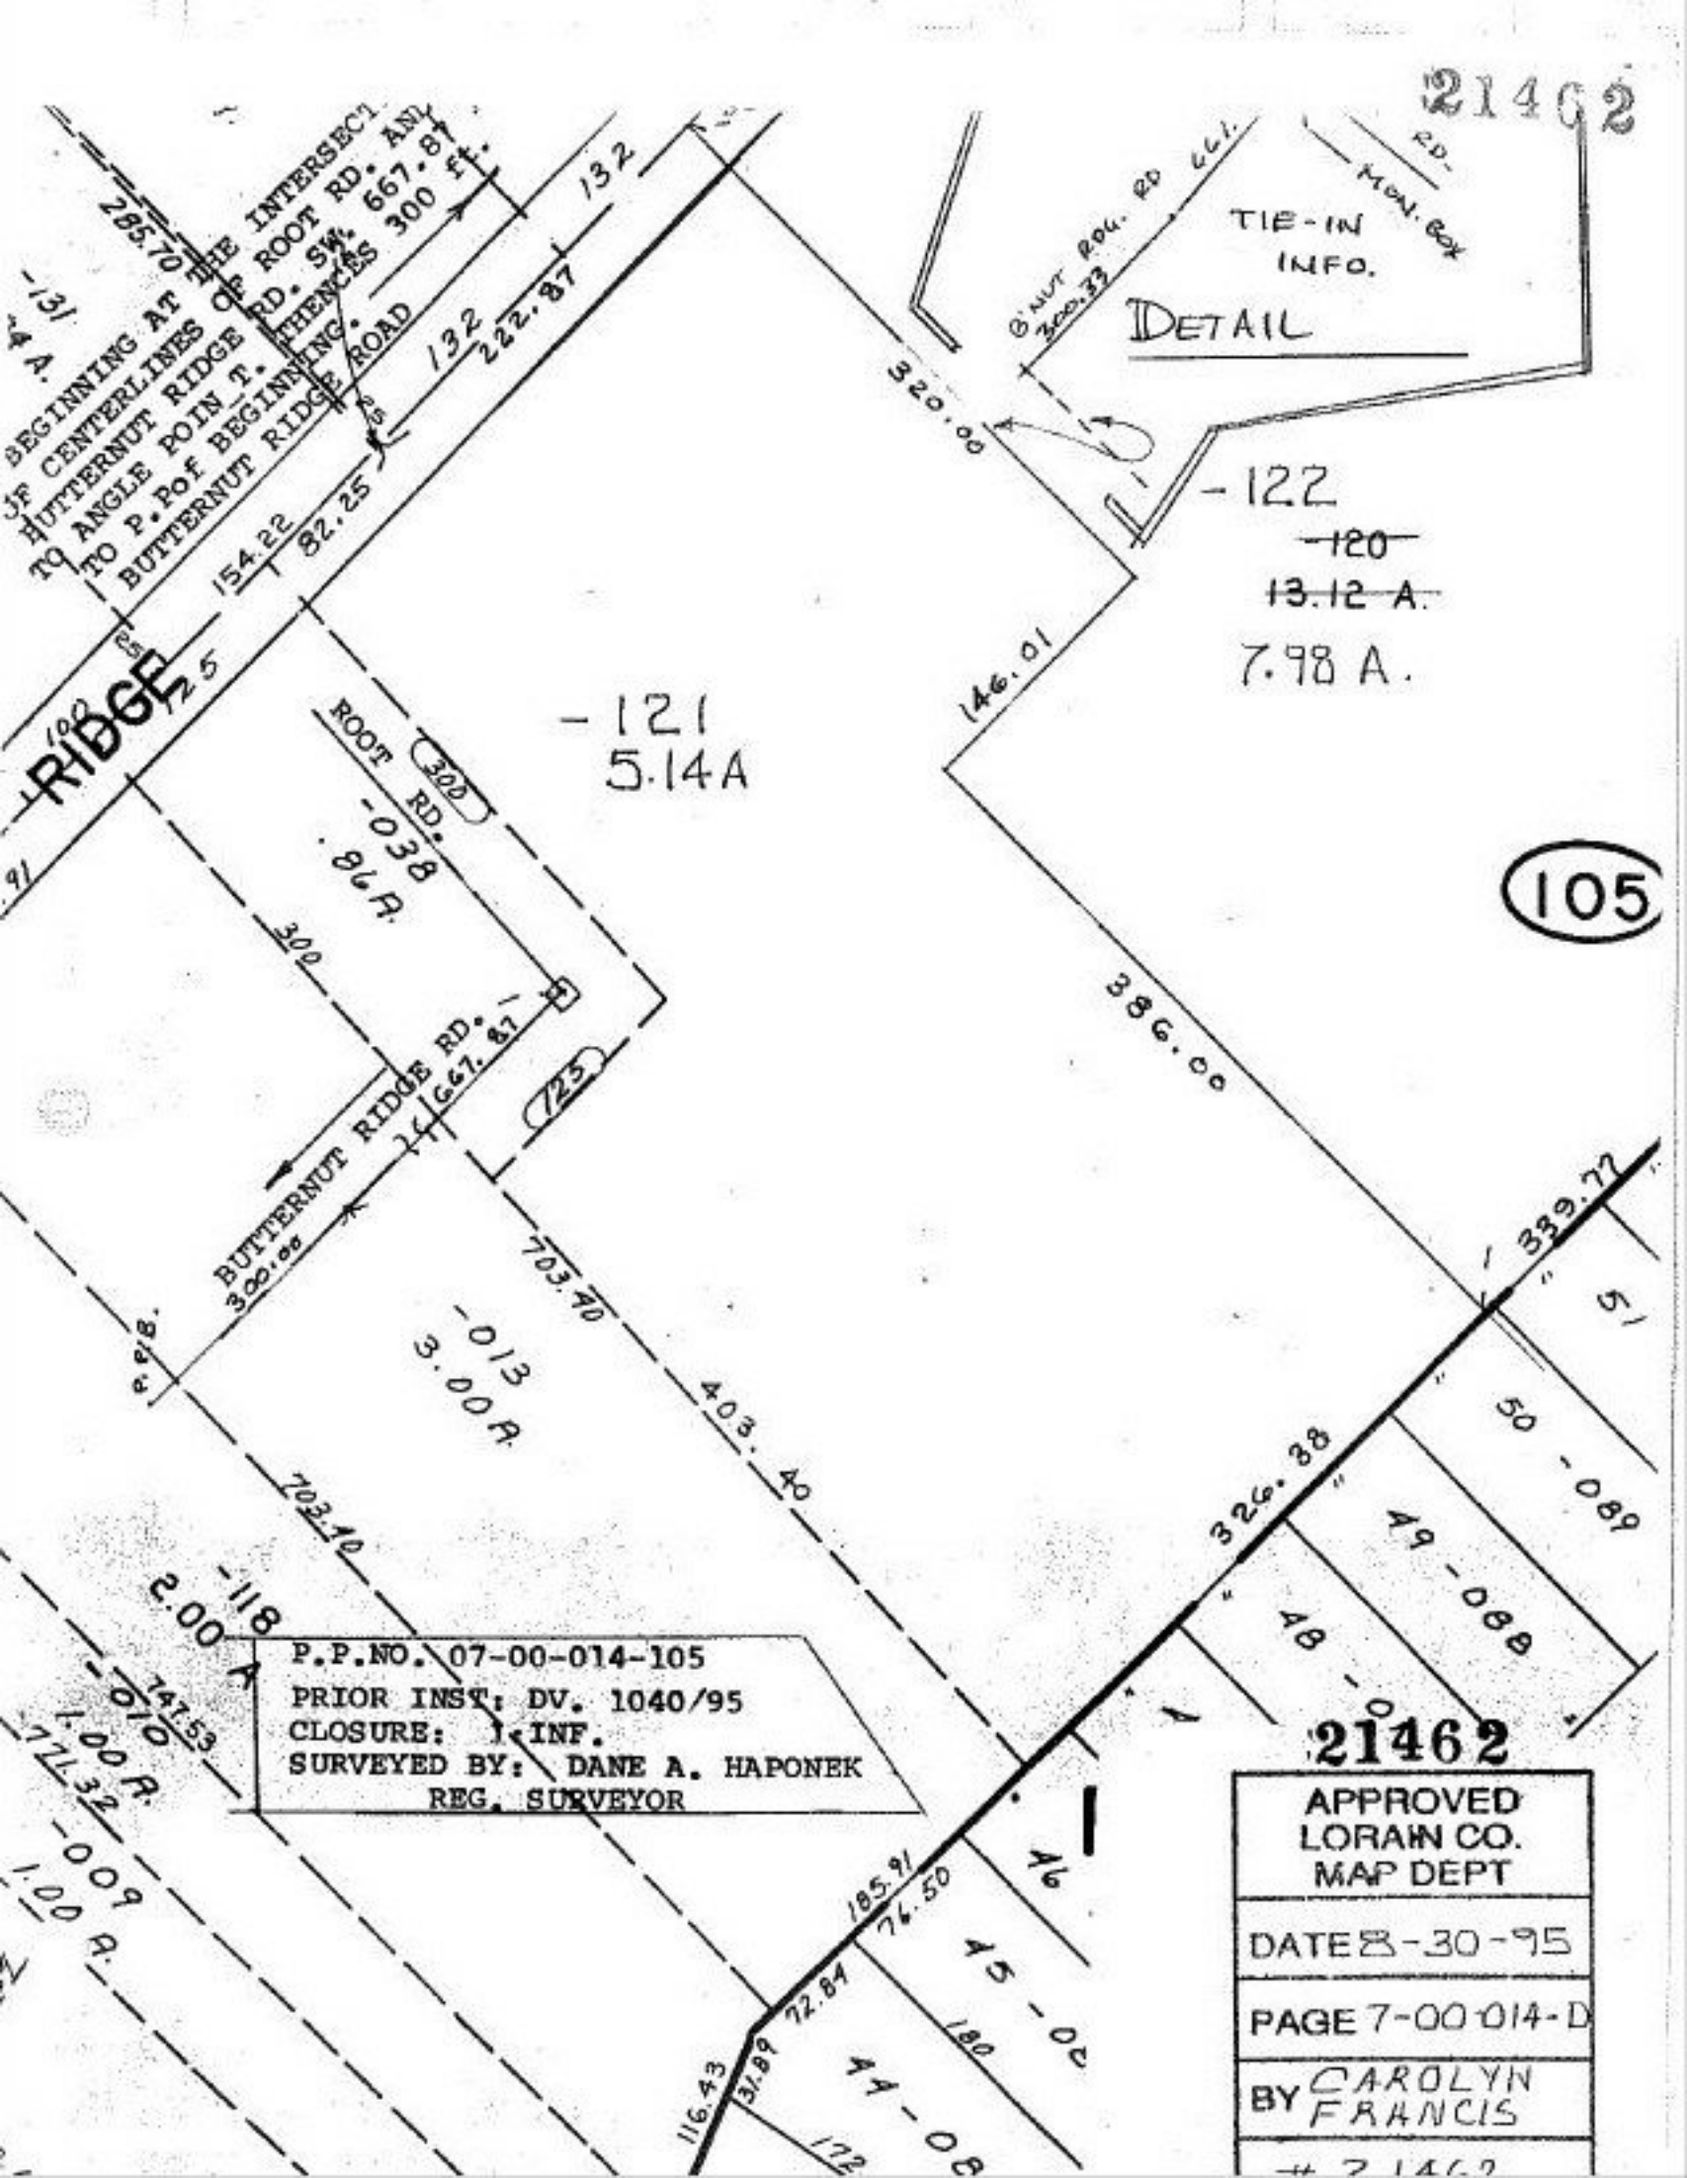
21462
BEGINNING AT THE INTERSECT OF CENTERLINES OF ROOT RD. AND HUTTERNUT RIDGE RD. SW. 667.87 TO ANGLE POIN_T. THENCES 300 ft. TO P.Pof BEGINNING. BUTTERNUT RIDGE ROAD
285.70
132
222.87
154.22
82.25
RIDGE
-131
4 A.
TIE-IN INFO.
DETAIL
MON. BOX
8' NUT ROW. RD
661.
300.33
320.00
-122
-120
13.12 A.
7.98 A.
146.01
-121
5.14A
ROOT RD.
300
-038
.86 A.
105
386.00
BUTTERNUT RIDGE RD.
667.87
300.00
125
703.40
403.40
703.40
339.77
326.38
-013
3.00 A.
-118
2.00 A.
-610
1.00 A.
-009
1.00 A.
P.P.NO. 07-00-014-105
PRIOR INST: DV. 1040/95
CLOSURE: 1<INF.
SURVEYED BY: DANE A. HAPONEK
REG. SURVEYOR
51
50 -089
49 -088
48 -0
45 -0
44 -08
185.91
76.50
72.84
116.43
37.89
180
172
21462
APPROVED LORAIN CO. MAP DEPT
DATE 8-30-95
PAGE 7-00-014-D
BY CAROLYN FRANCIS
21462