#21465 X

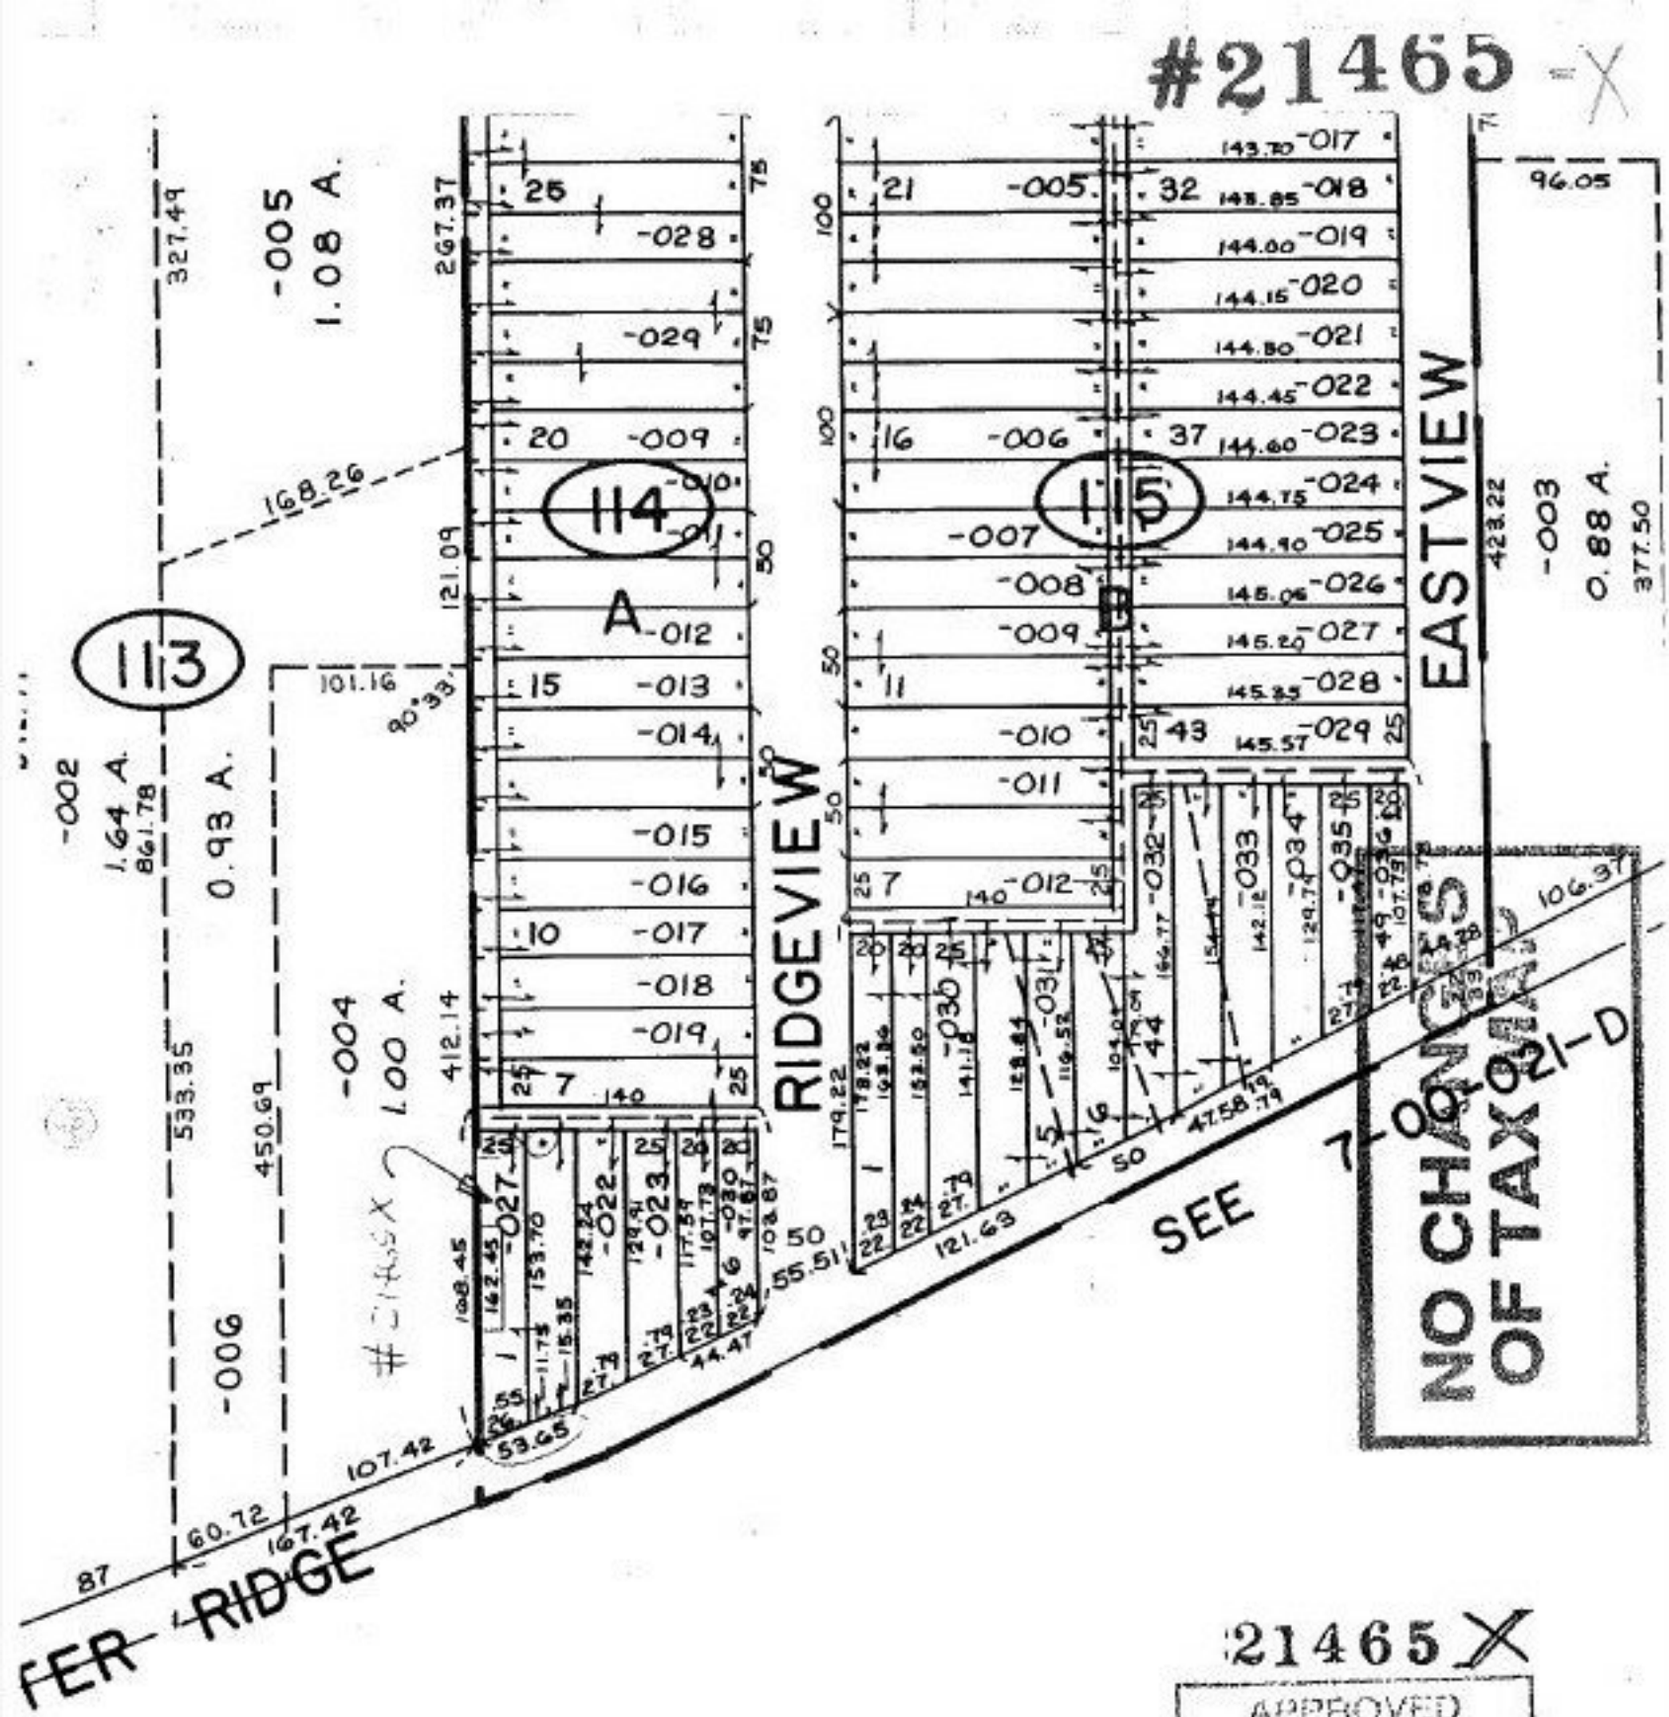

21465 X

APPROVED LORAIN CO. MAP DEPT
DATE 3-6-96
PAGE 7-00-021-B
BY CAROLYN FRANCIS
21465X

DEPTH CORR. TO DUP &
REG ONLY TAX MAP O.K
07-00-021-114-027
FROM 53.65 X ~~168.00~~
TO 53.65 X 162.45