21466

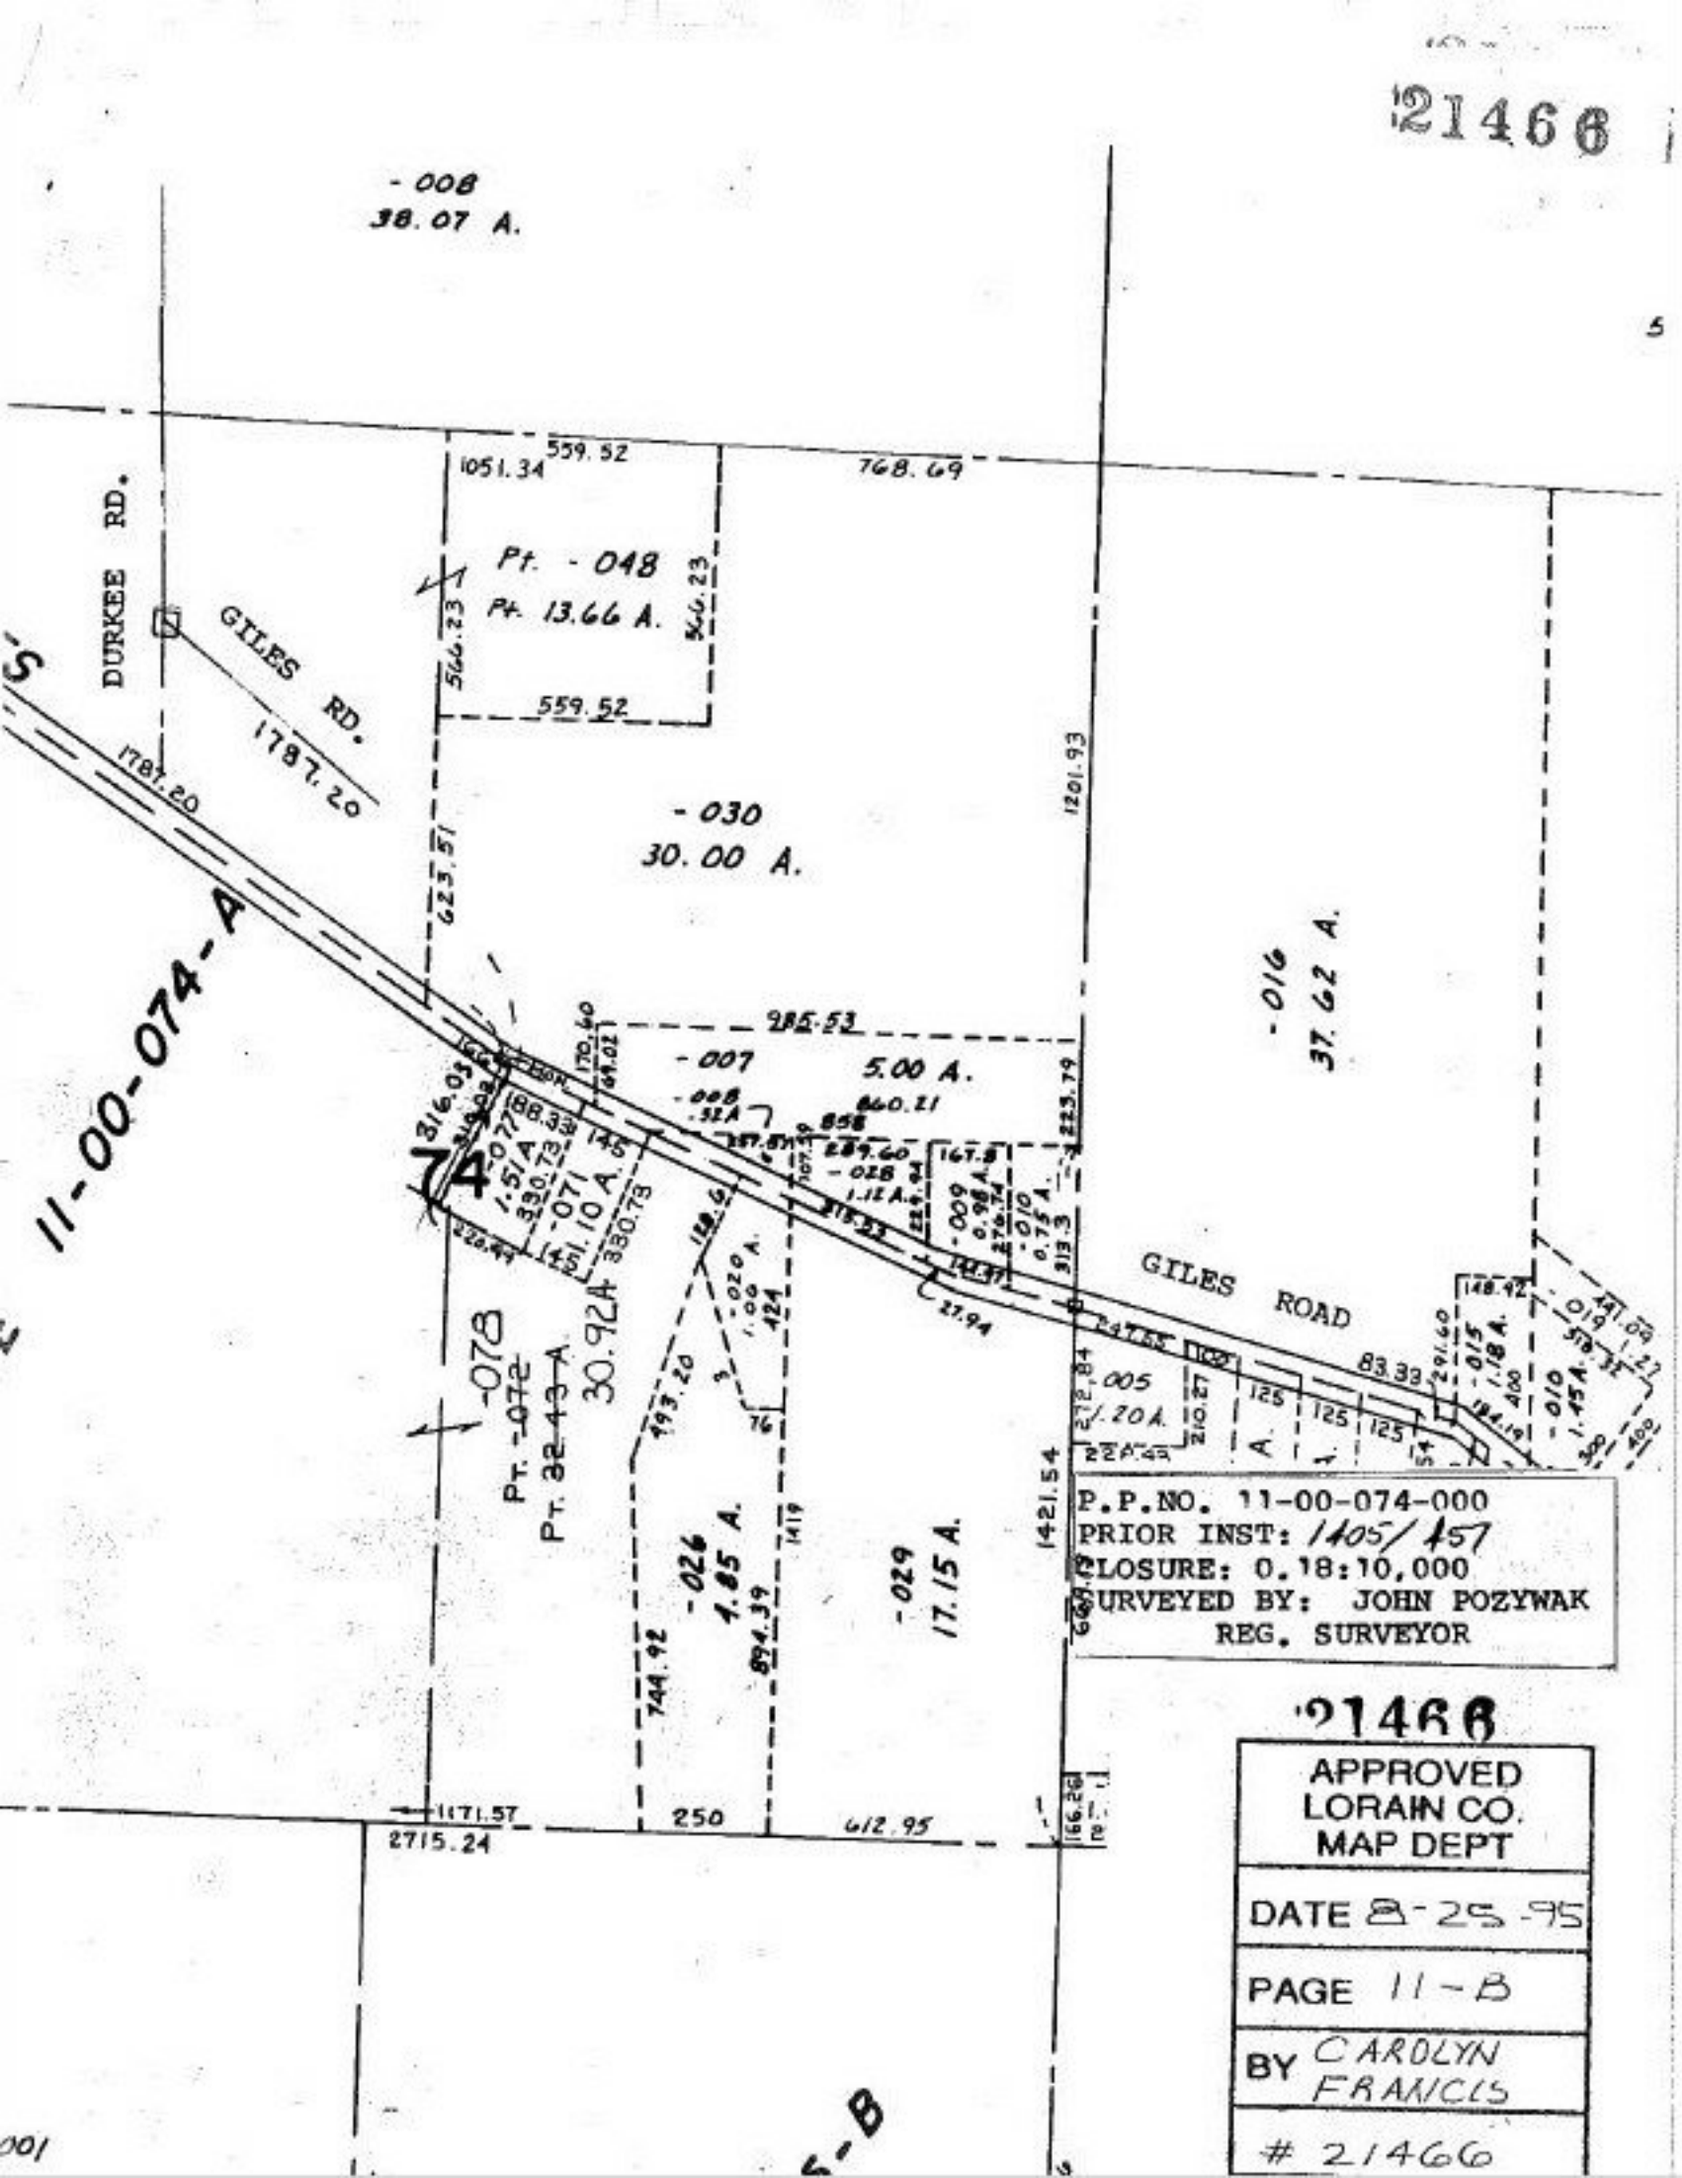

P.P.NO. 11-00-074-000
PRIOR INST: 1405/457
CLOSURE: 0.18:10,000
SURVEYED BY: JOHN POZYWAK
REG. SURVEYOR

21466

APPROVED
LORAIN CO.
MAP DEPT

DATE 8-25-95

PAGE 11-B

BY CAROLYN FRANCIS

21466