21469

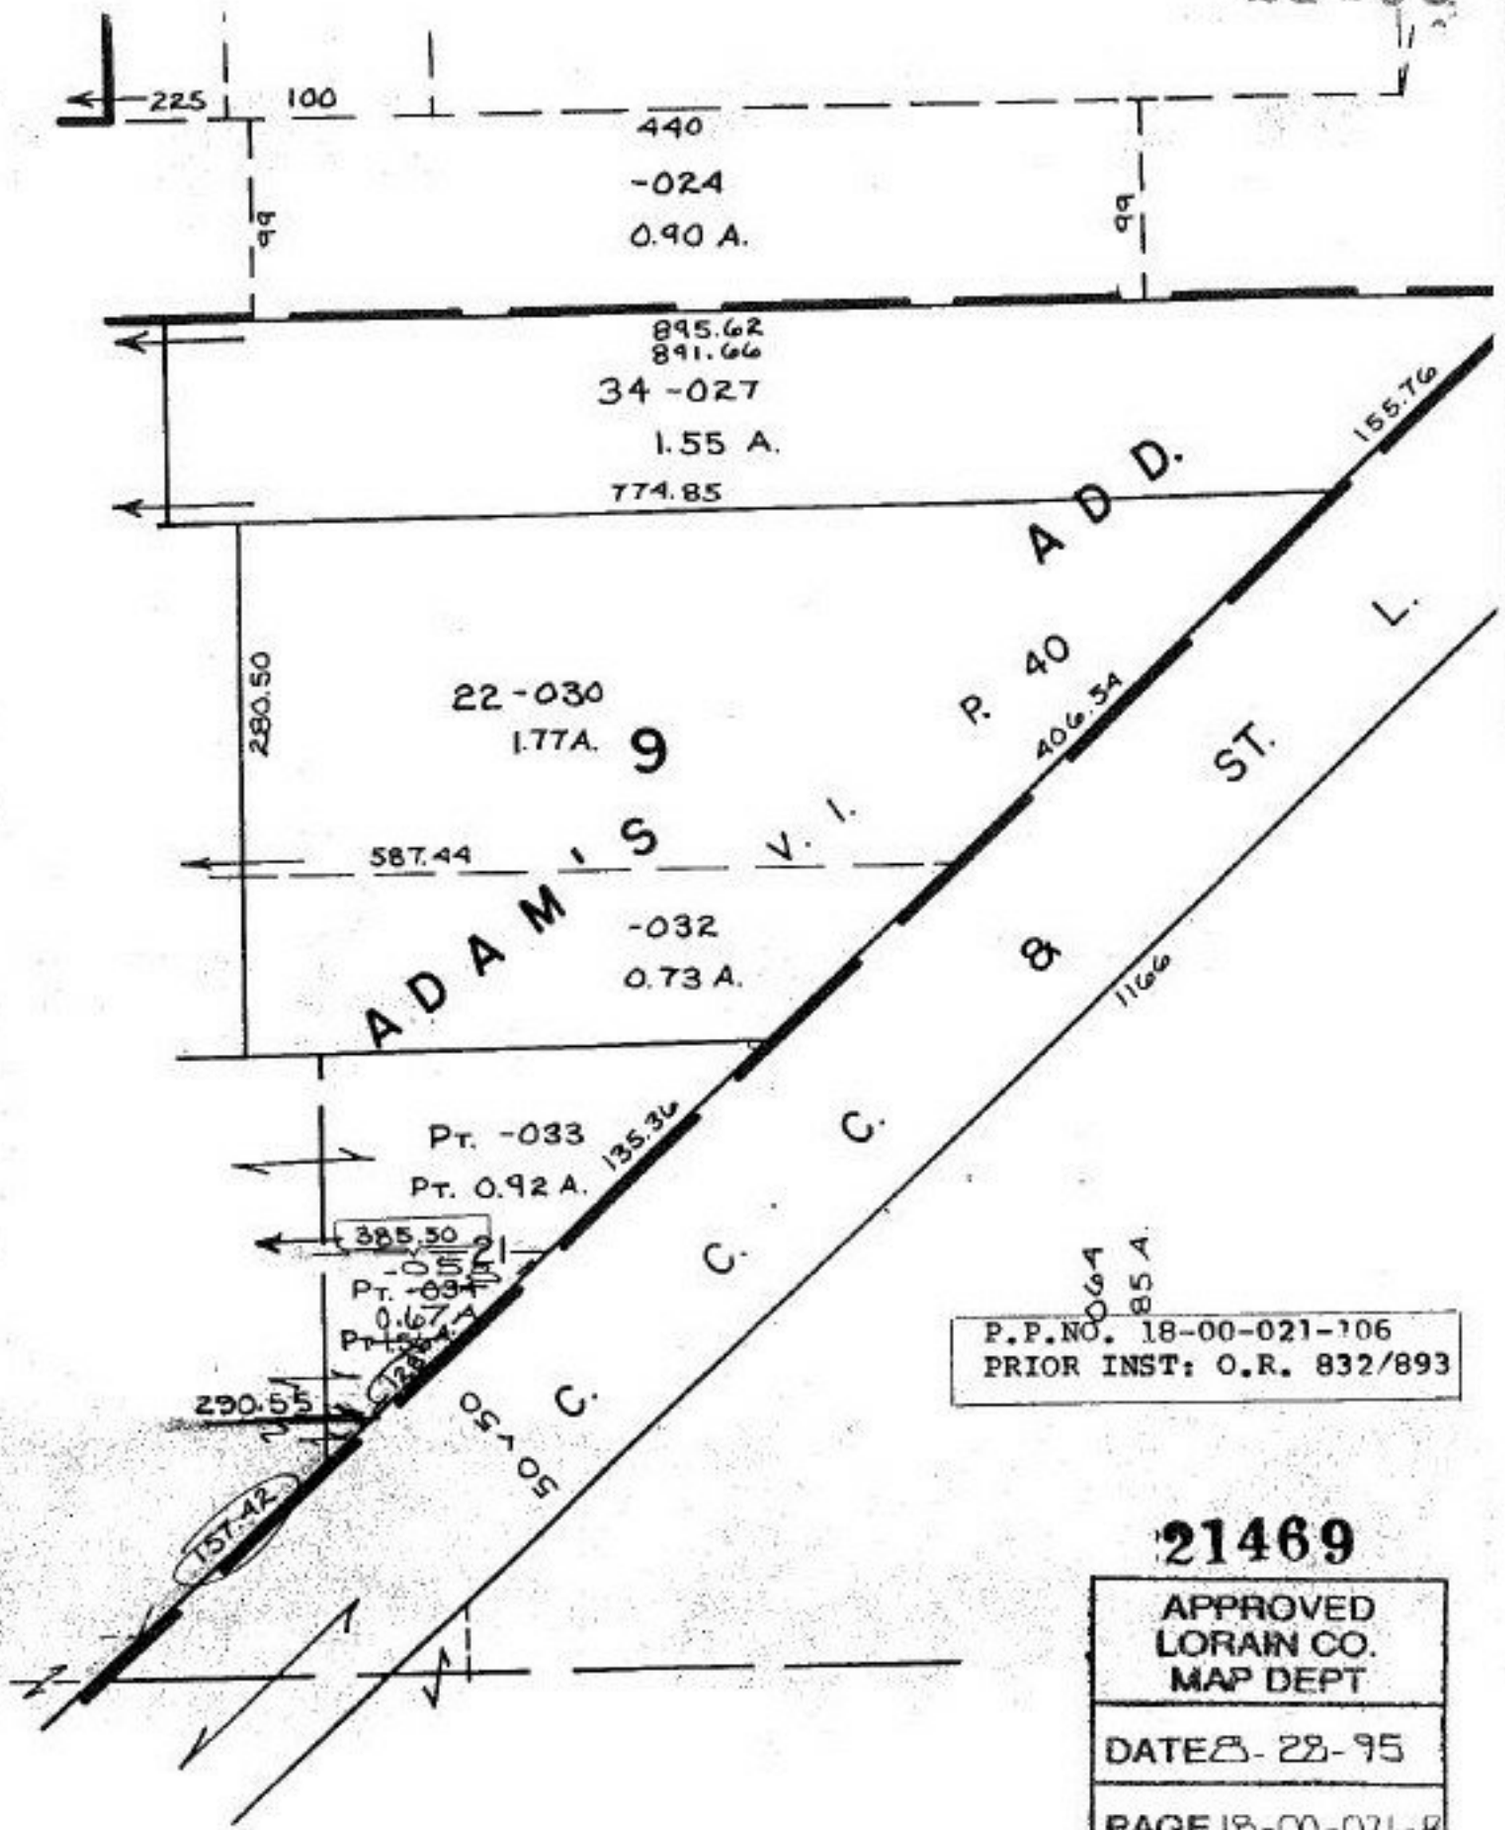

P.P.NO. 18-00-021-106
PRIOR INST: O.R. 832/893

21469

APPROVED LORAIN CO. MAP DEPT
DATE 8-28-95
PAGE 18-00-021-B
BY CAROLYN FRANCIS
21469

0 100