21470

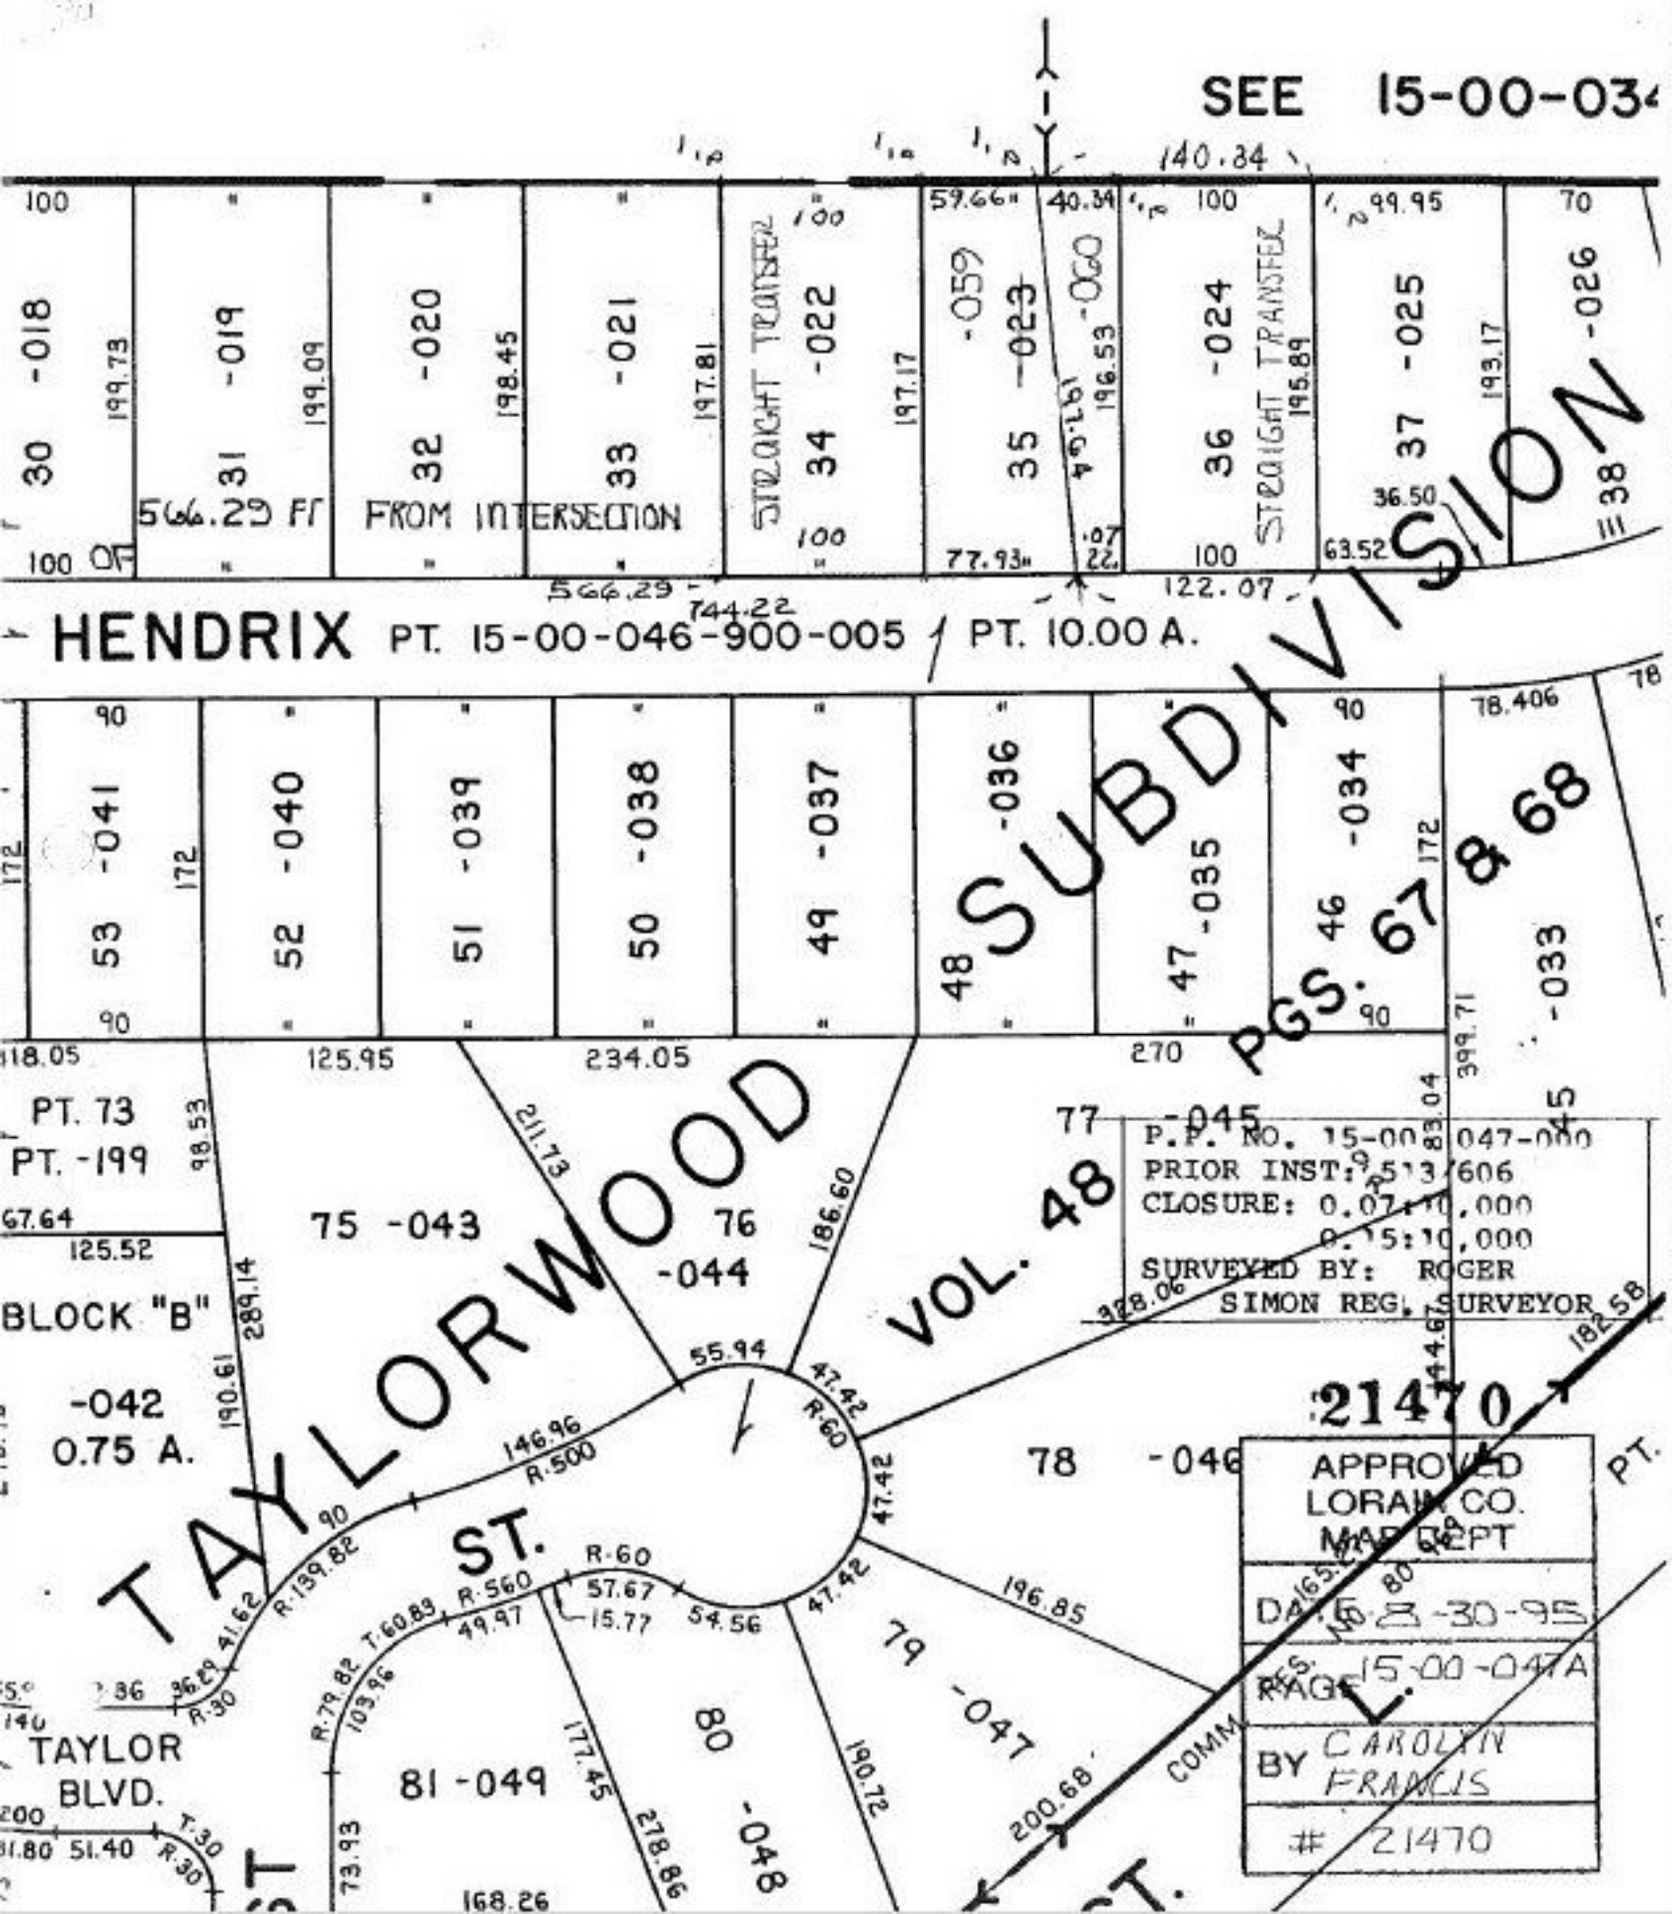
SEE 15-00-034
140.84
566.29 FT FROM INTERSECTION
744.22
122.07
HENDRIX PT. 15-00-046-900-005 / PT. 10.00 A.
SUBDIVISION
PGS. 67 & 68
VOL. 48
TAYLORWOOD
ST.
BLOCK "B"
-042
0.75 A.
PT. 73
PT. -199
75 -043
76 -044
77 -045
78 -046
79 -047
80 -048
81 -049
P.P. NO. 15-00-047-000
PRIOR INST: 513606
CLOSURE: 0.07:10,000
0.15:10,000
SURVEYED BY: ROGER SIMON REG. SURVEYOR
21470
APPROVED
LORAIN CO.
MAP DEPT
REF 15-00-047A
BY CAROLYN FRANCIS
21470
TAYLOR BLVD.
COMM.