#21475

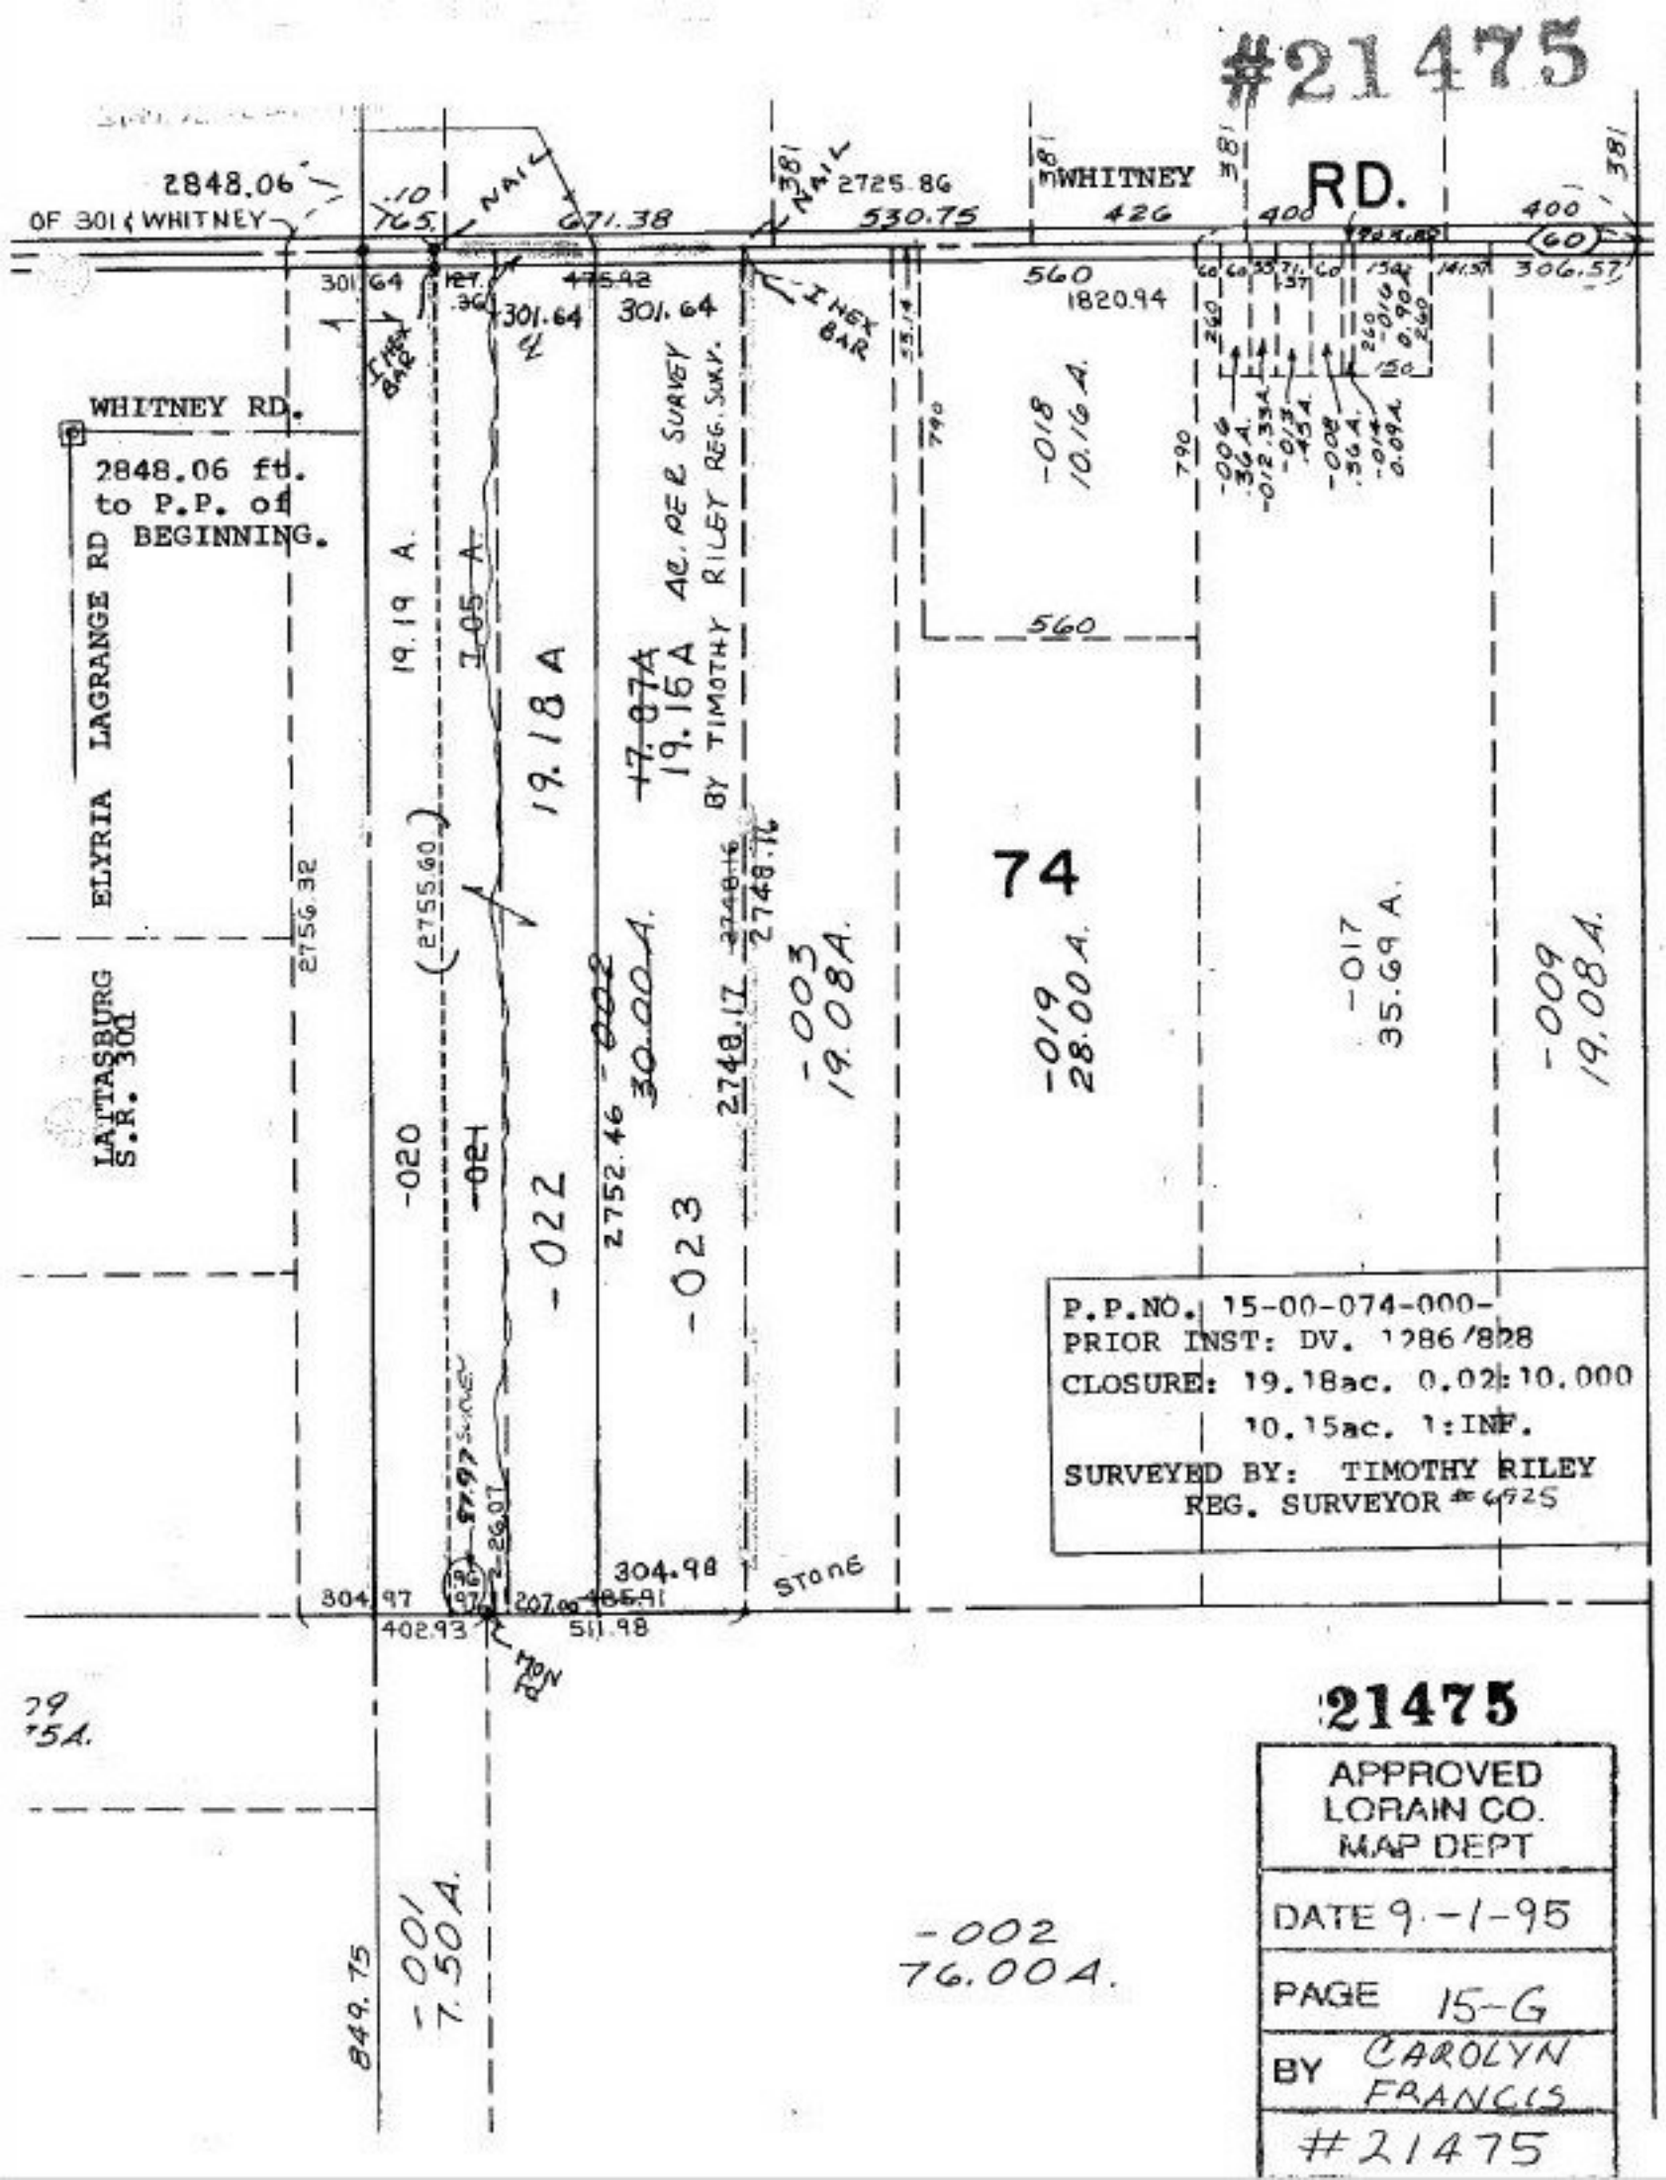

P.P.NO. 15-00-074-000-
PRIOR INST: DV. 1286/828
CLOSURE: 19.18ac. 0.02:10.000
10.15ac. 1:INF.
SURVEYED BY: TIMOTHY RILEY
REG. SURVEYOR # 6925

21475

APPROVED
LORAIN CO.
MAP DEPT

DATE 9-1-95

PAGE 15-G

BY CAROLYN FRANCIS

#21475