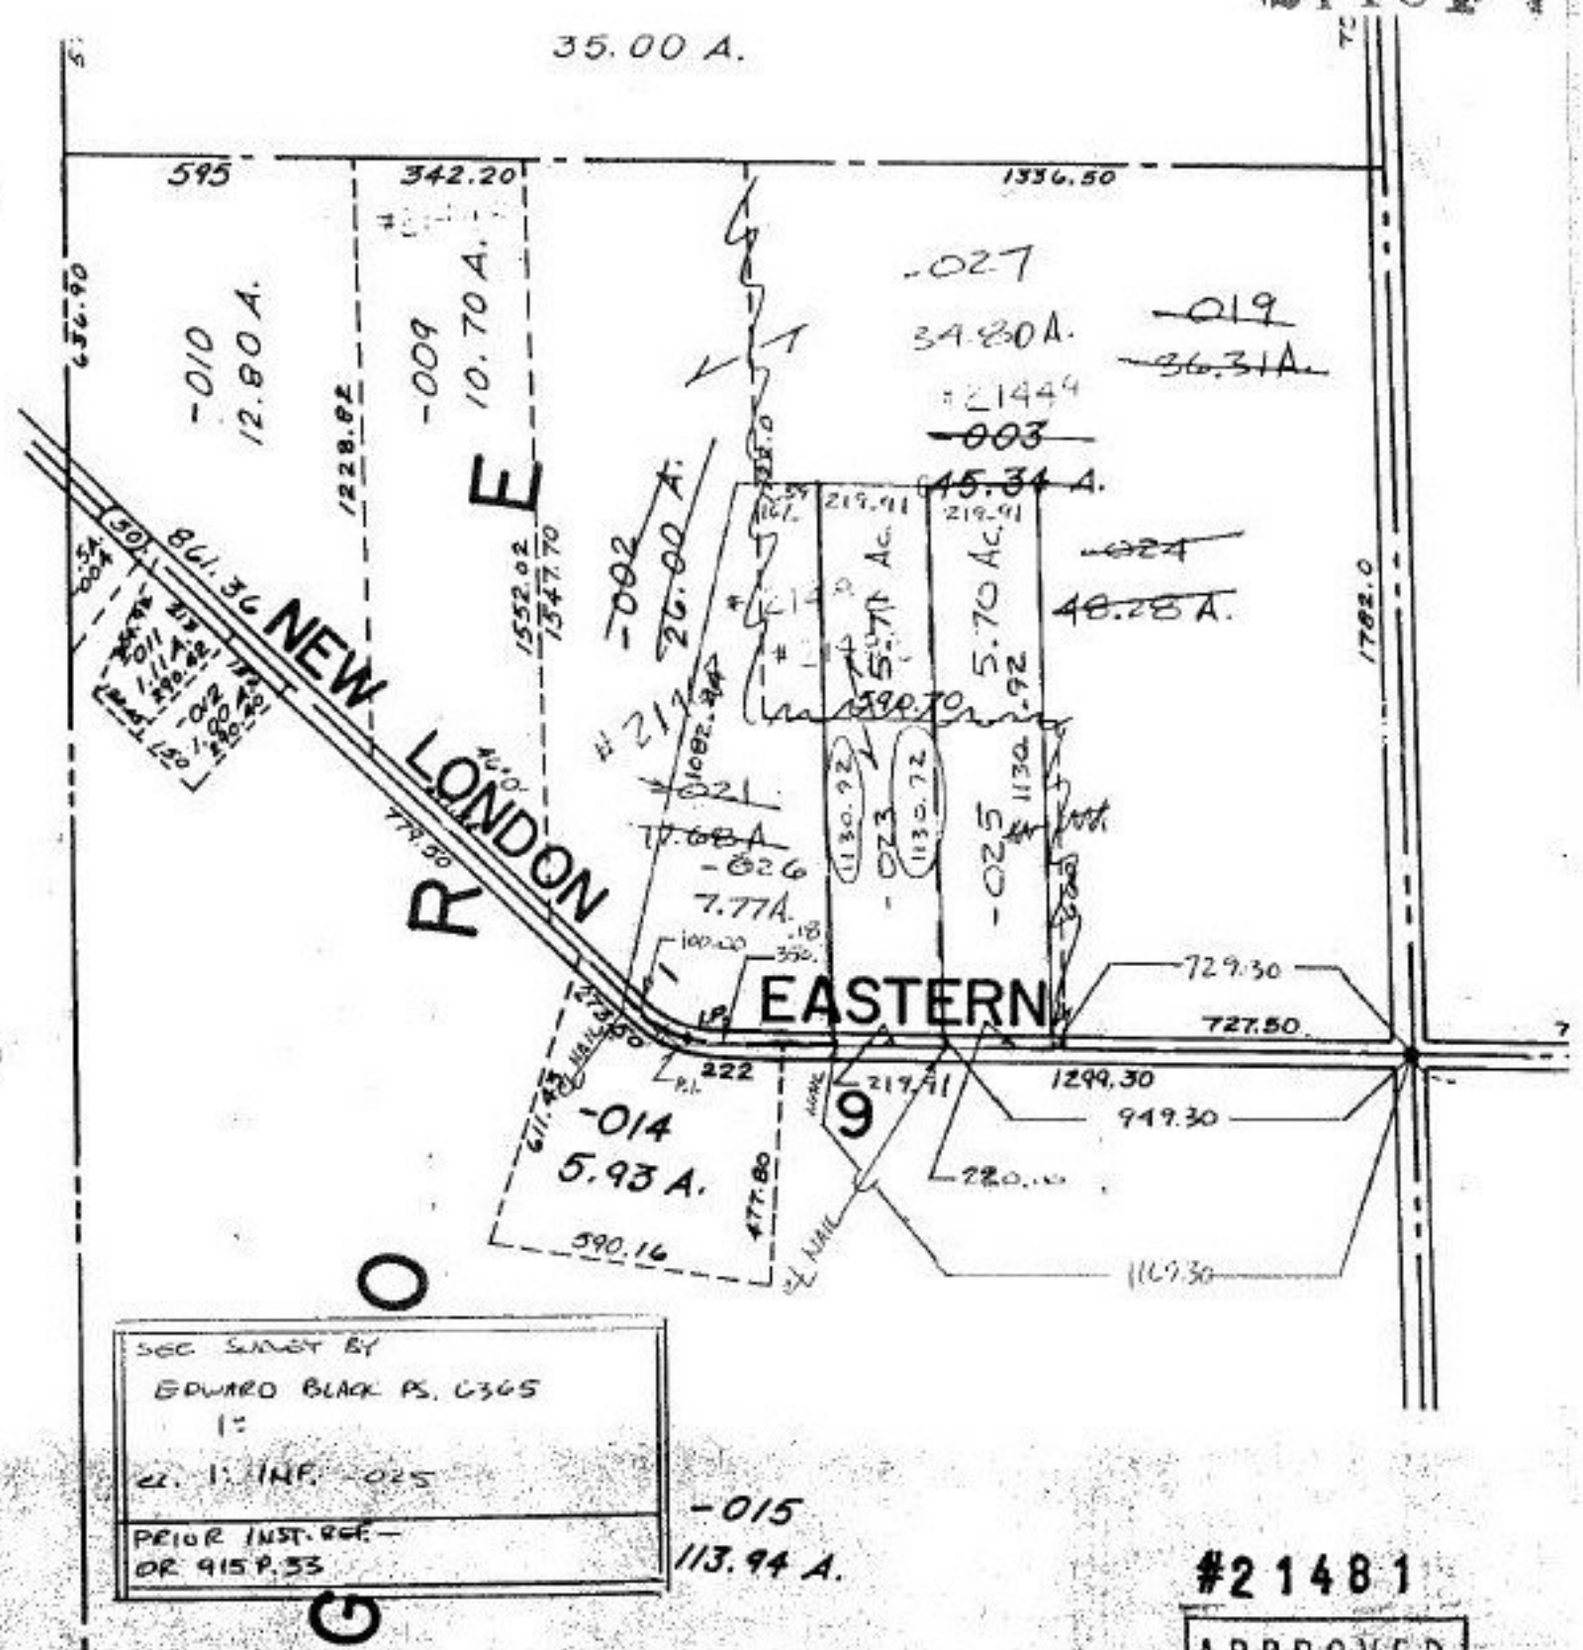

#21481

APPROVED
LORAIN CO.
MAP DEPT.
DATE 9-26-95
PAGE 20-F
BY T. McClain
VOID AFTER 21481