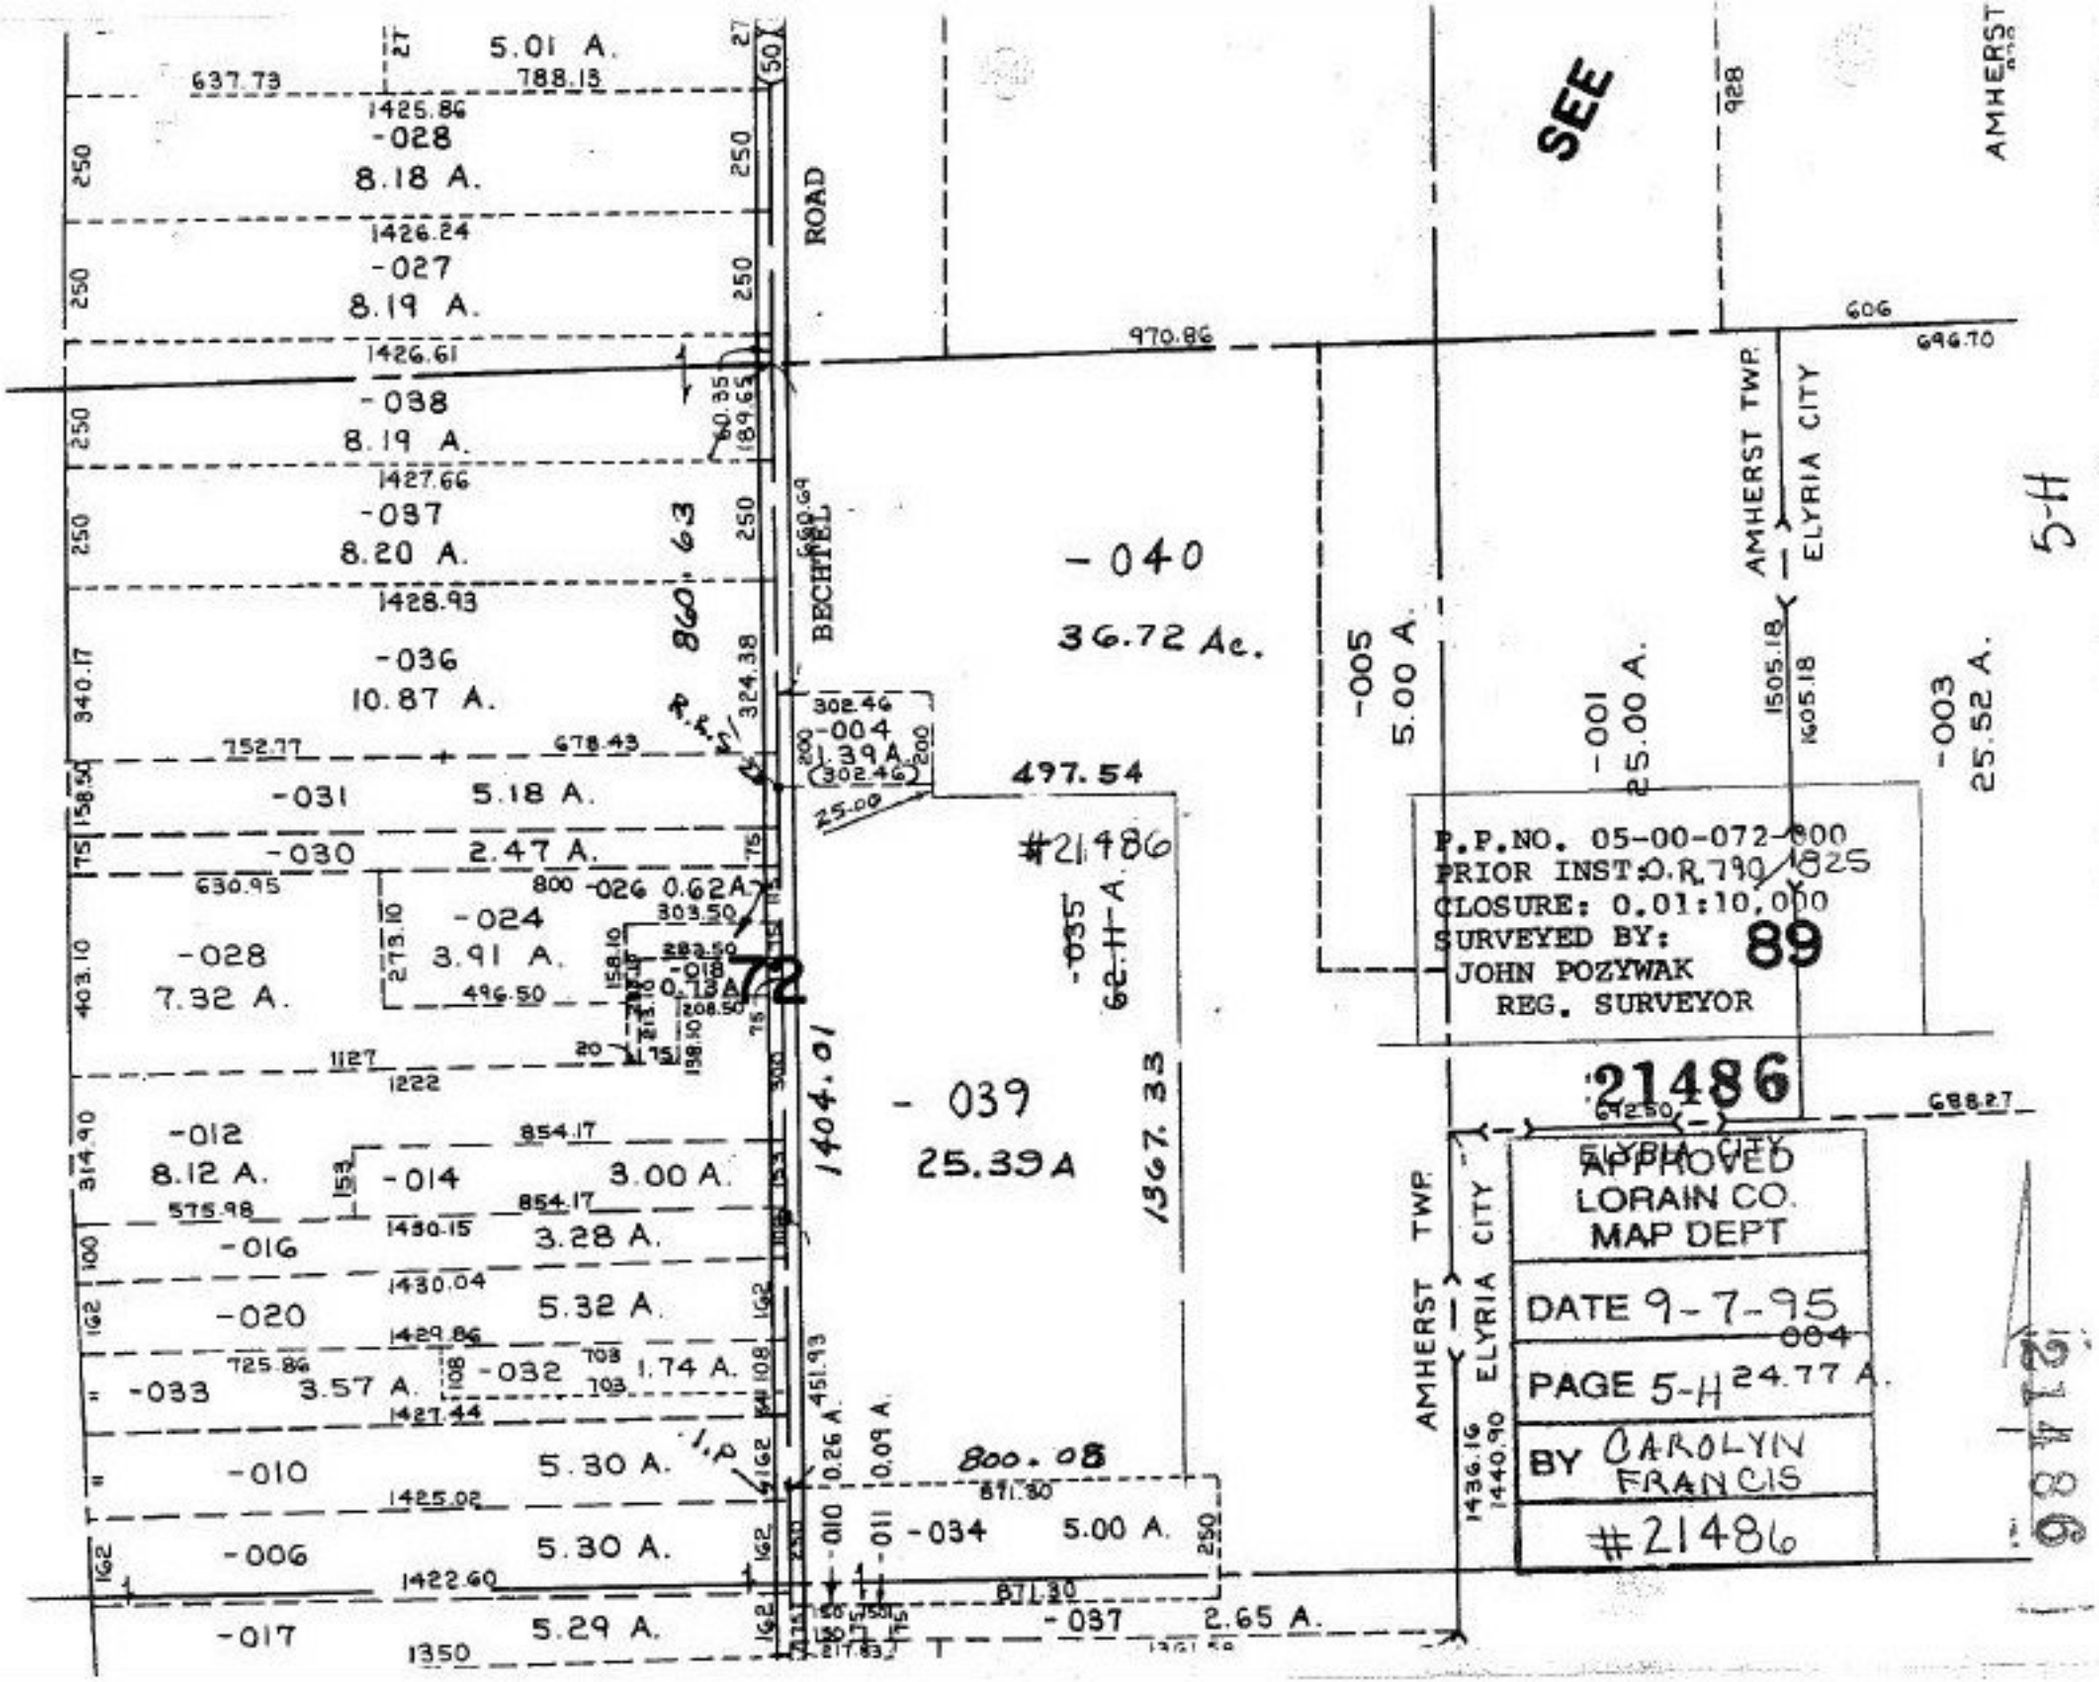

SEE
AMHERST
ROAD
BECHTEL
AMHERST TWP.
ELYRIA CITY
5-H
-040
36.72 Ac.
-005
5.00 A.
-001
25.00 A.
-003
25.52 A.
-004
1.39 A.
497.54
#21486
-035
62.11 A.
-039
25.39 A
1367.33
1404.01
860.63
72
-028
7.32 A.
-024
3.91 A.
-026 0.62 A.
-018
0.73 A.
-031
5.18 A.
-030
2.47 A.
-012
8.12 A.
-014
3.00 A.
-016
3.28 A.
-020
5.32 A.
-033
3.57 A.
-032
1.74 A.
-010
5.30 A.
-006
5.30 A.
-017
5.29 A.
-034
5.00 A.
-037
2.65 A.
800.08
-028
8.18 A.
-027
8.19 A.
-038
8.19 A.
-037
8.20 A.
-036
10.87 A.
P.P.NO. 05-00-072-000
PRIOR INST: O.R. 790/825
CLOSURE: 0.01:10,000
SURVEYED BY:
JOHN POZYWAK
REG. SURVEYOR
89
21486
APPROVED
LORAIN CO.
MAP DEPT
DATE 9-7-95
PAGE 5-H
BY CAROLYN FRANCIS
#21486