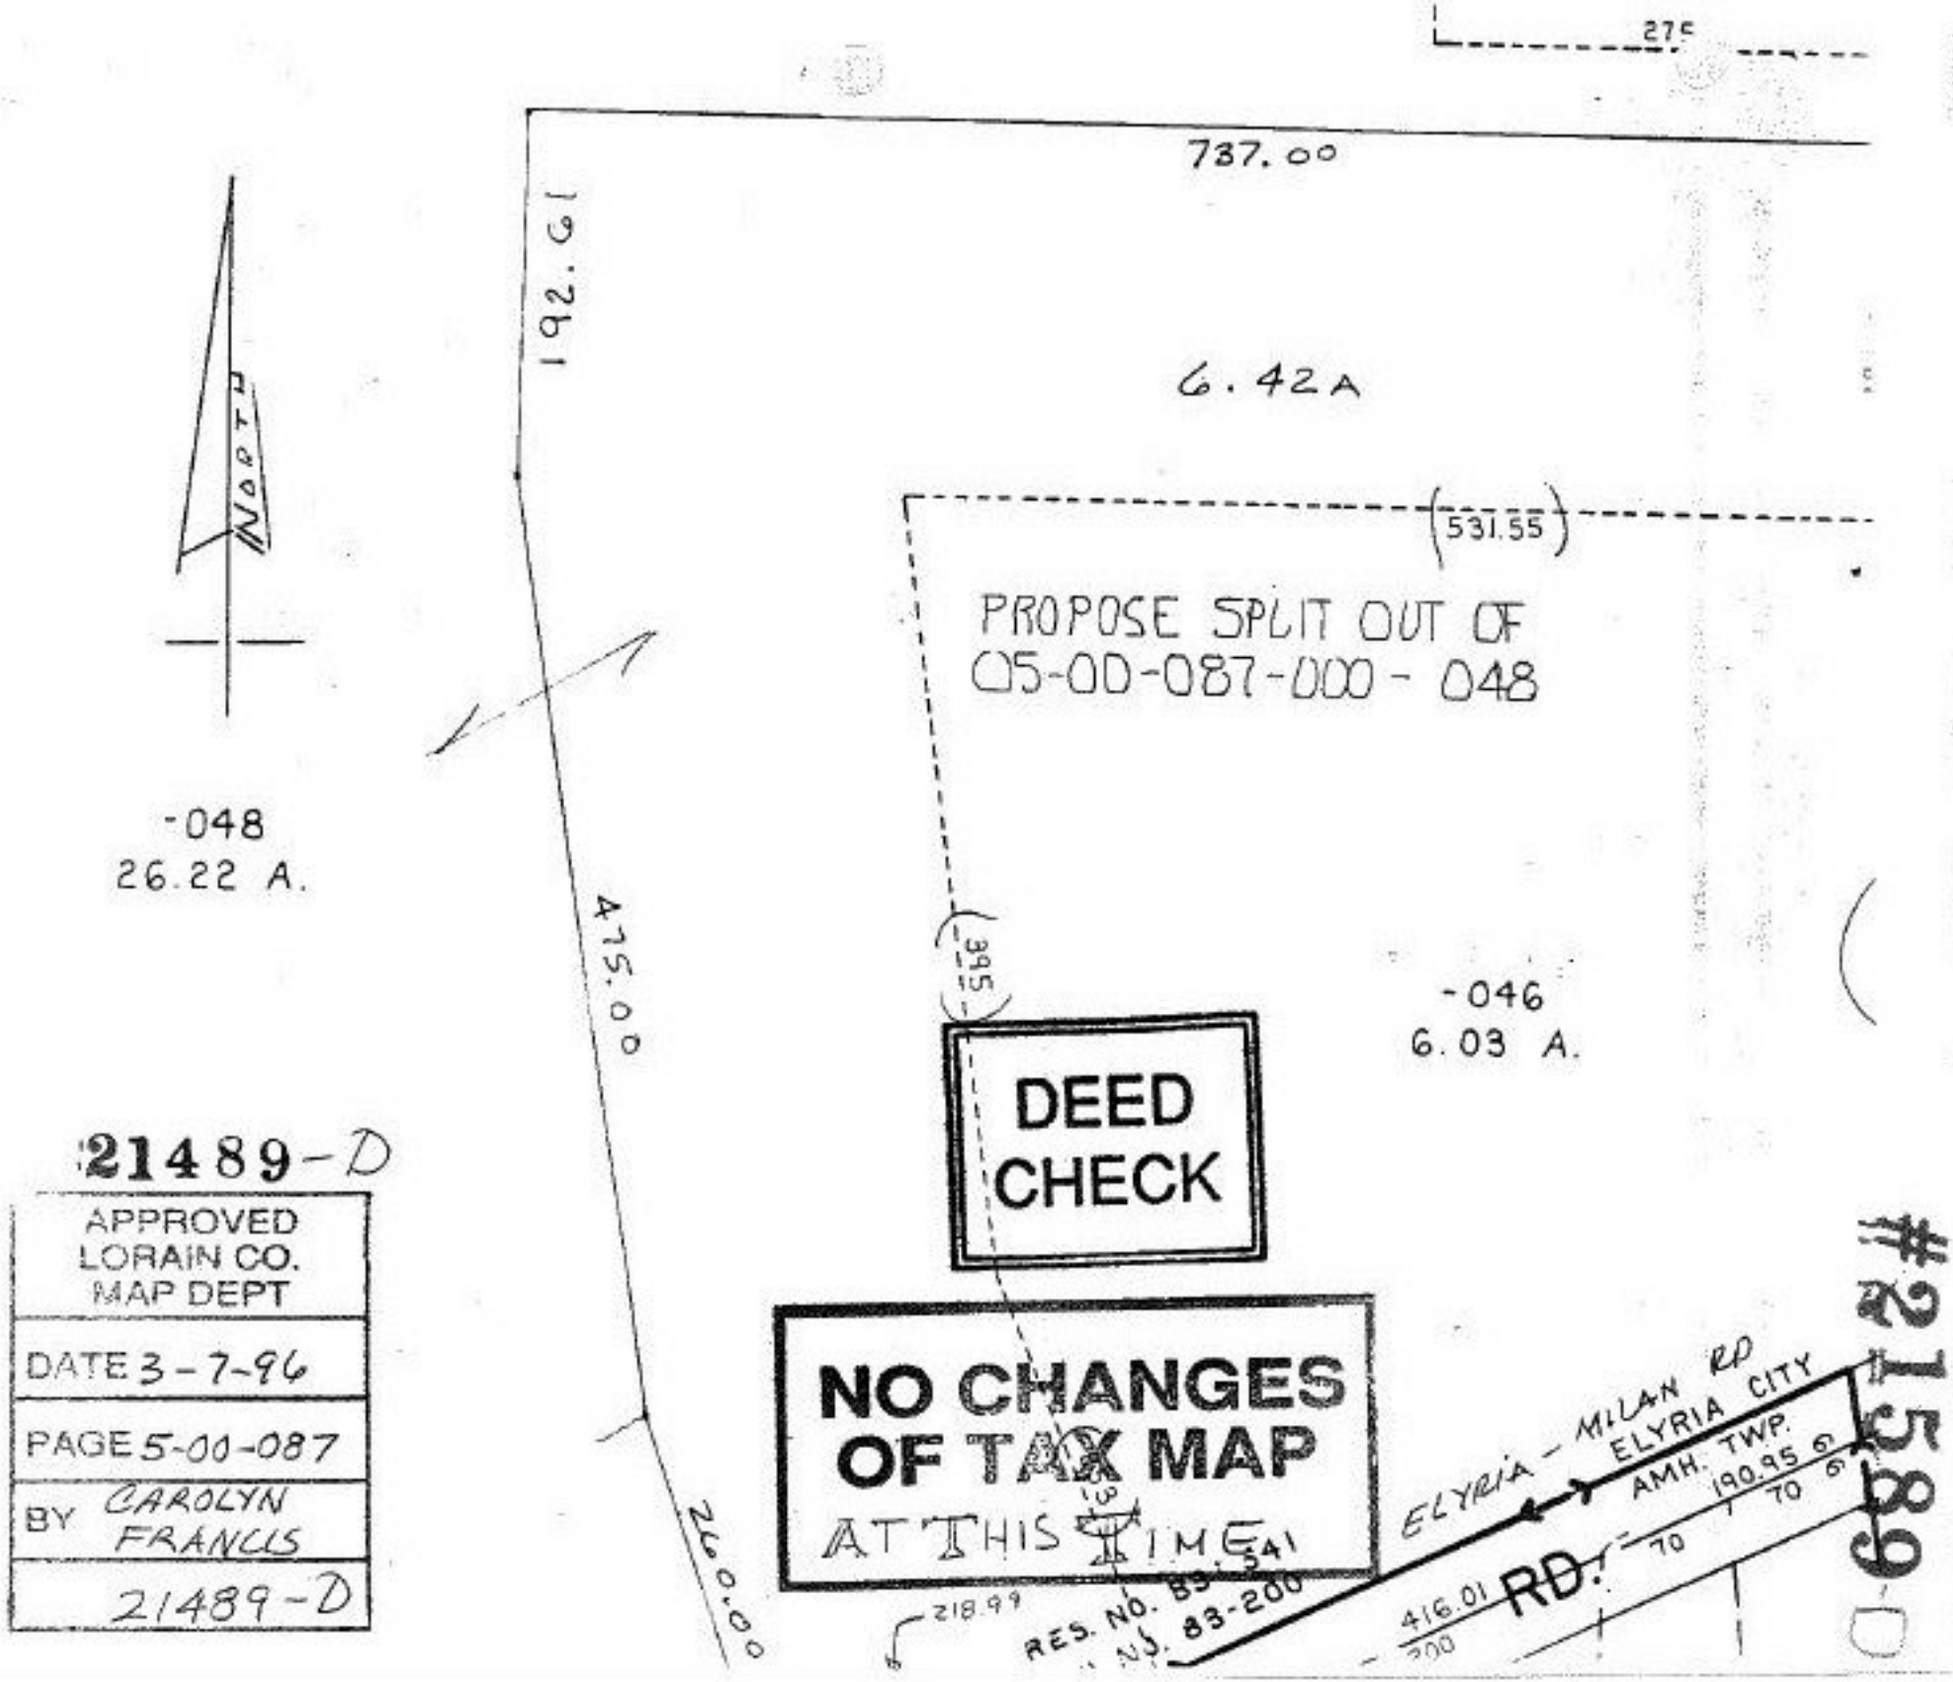

737.00
192.61
6.42A
NORTH
531.55
PROPOSE SPLIT OUT OF
05-00-087-000-048
-048
26.22 A.
475.00
395
-046
6.03 A.
DEED CHECK
NO CHANGES OF TAX MAP AT THIS TIME
ELYRIA - MILAN RD
ELYRIA CITY
AMH. TWP.
190.95
70
416.01
RD.
RES. NO. 83-541
NO. 83-200
218.99
260.00
21489-D
APPROVED LORAIN CO. MAP DEPT
DATE 3-7-96
PAGE 5-00-087
BY CAROLYN FRANCIS
21489-D
#21589-D