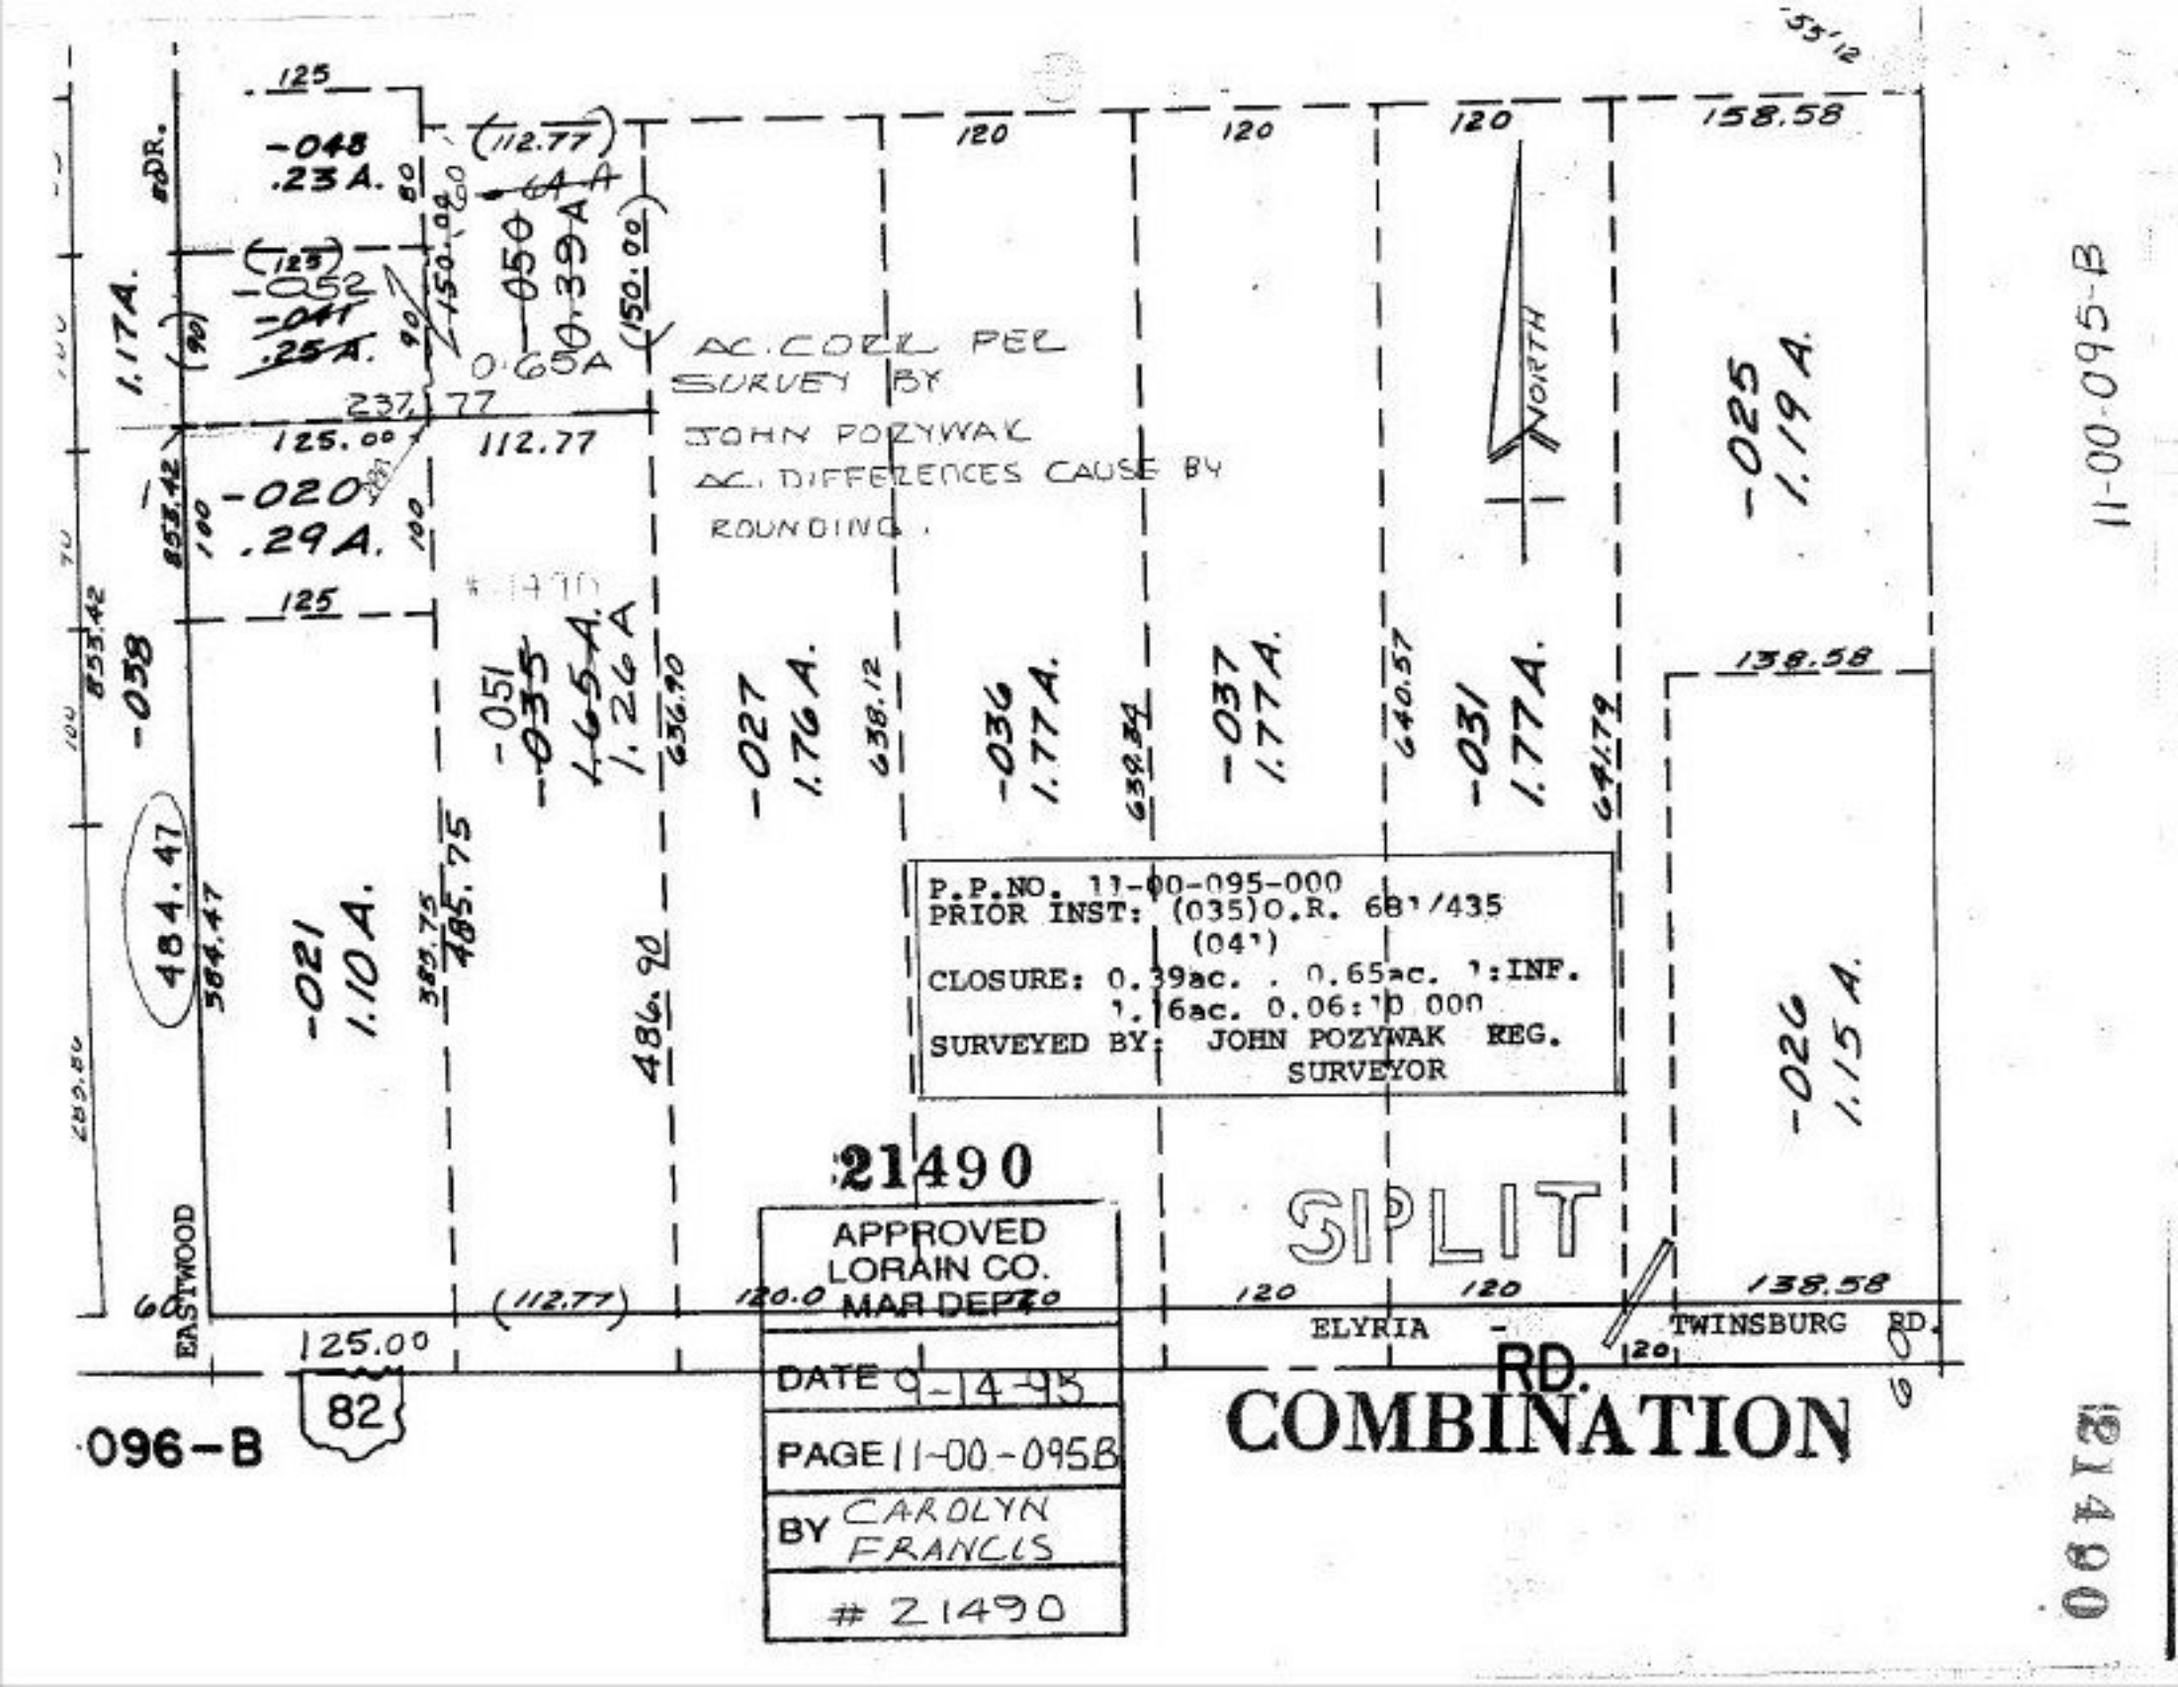
-048
.23 A.
-052
-041
.25 A.
-050
0.39 A
0.65 A
1.17 A.
-020
.29 A.
AC. CORR PER SURVEY BY JOHN POZYWAK AC. DIFFERENCES CAUSE BY ROUNDING.
-058
-021
1.10 A.
-051
-035
1.65 A.
1.24 A
-027
1.76 A.
-036
1.77 A.
-037
1.77 A.
-031
1.77 A.
-025
1.19 A.
-026
1.15 A.
NORTH
P.P.NO. 11-00-095-000
PRIOR INST: (035)O.R. 681/435
(041)
CLOSURE: 0.39ac. . 0.65ac. 1:INF.
1.16ac. 0.06:10 000
SURVEYED BY: JOHN POZYWAK REG. SURVEYOR
21490
APPROVED LORAIN CO. MAR DEPT
DATE 9-14-95
PAGE 11-00-095B
BY CAROLYN FRANCIS
21490
SPLIT
COMBINATION
EASTWOOD
ELYRIA - TWINSBURG RD.
RD.
82
096-B
11-00-095-B
21490