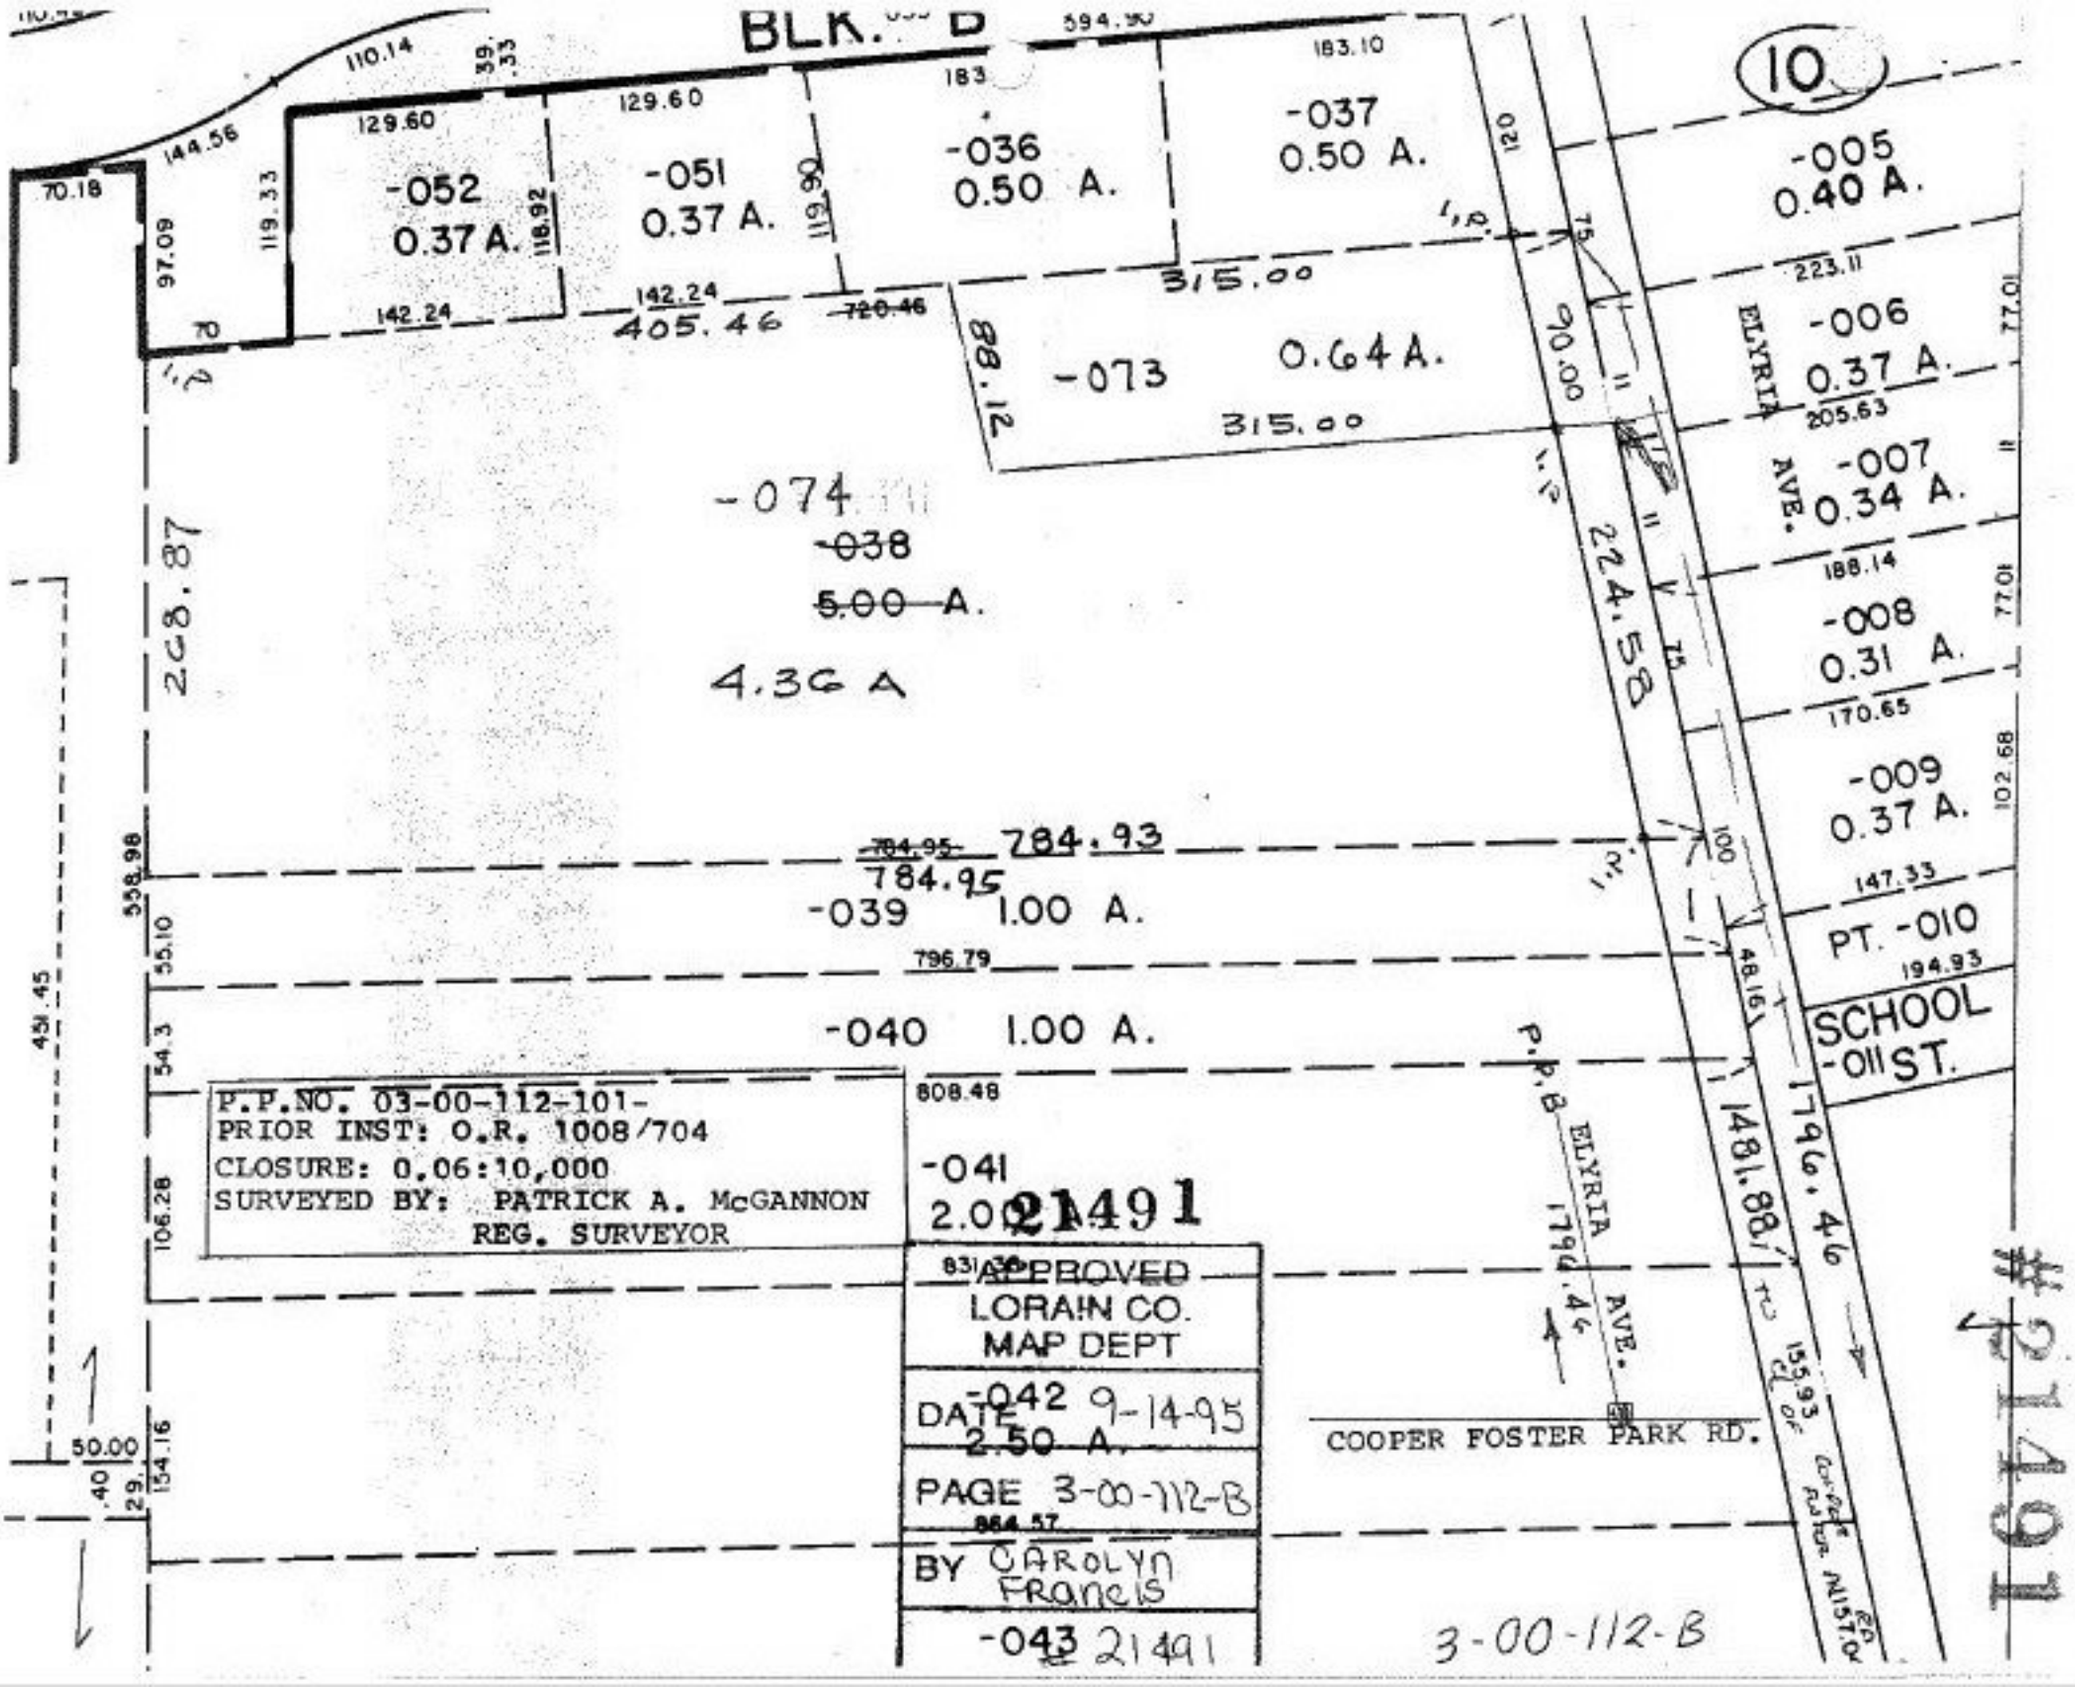
BLK. B
10
-052
0.37 A.
-051
0.37 A.
-036
0.50 A.
-037
0.50 A.
-005
0.40 A.
-006
0.37 A.
-007
0.34 A.
-008
0.31 A.
-009
0.37 A.
PT. -010
SCHOOL
-011 ST.
-073
0.64 A.
315.00
405.46
88.12
90.00
224.58
ELYRIA AVE.
-074
-038
5.00 A.
4.36 A
268.87
784.93
784.95
-039 1.00 A.
796.79
-040 1.00 A.
808.48
-041
2.00
831.36
-042
2.50 A.
864.57
-043
P.P.NO. 03-00-112-101-
PRIOR INST: O.R. 1008/704
CLOSURE: 0.06:10,000
SURVEYED BY: PATRICK A. McGANNON
REG. SURVEYOR
21491
APPROVED
LORAIN CO.
MAP DEPT
DATE 9-14-95
PAGE 3-00-112-B
BY CAROLYN FRANCIS
COOPER FOSTER PARK RD.
1481.88
1796.46
3-00-112-B
#21491