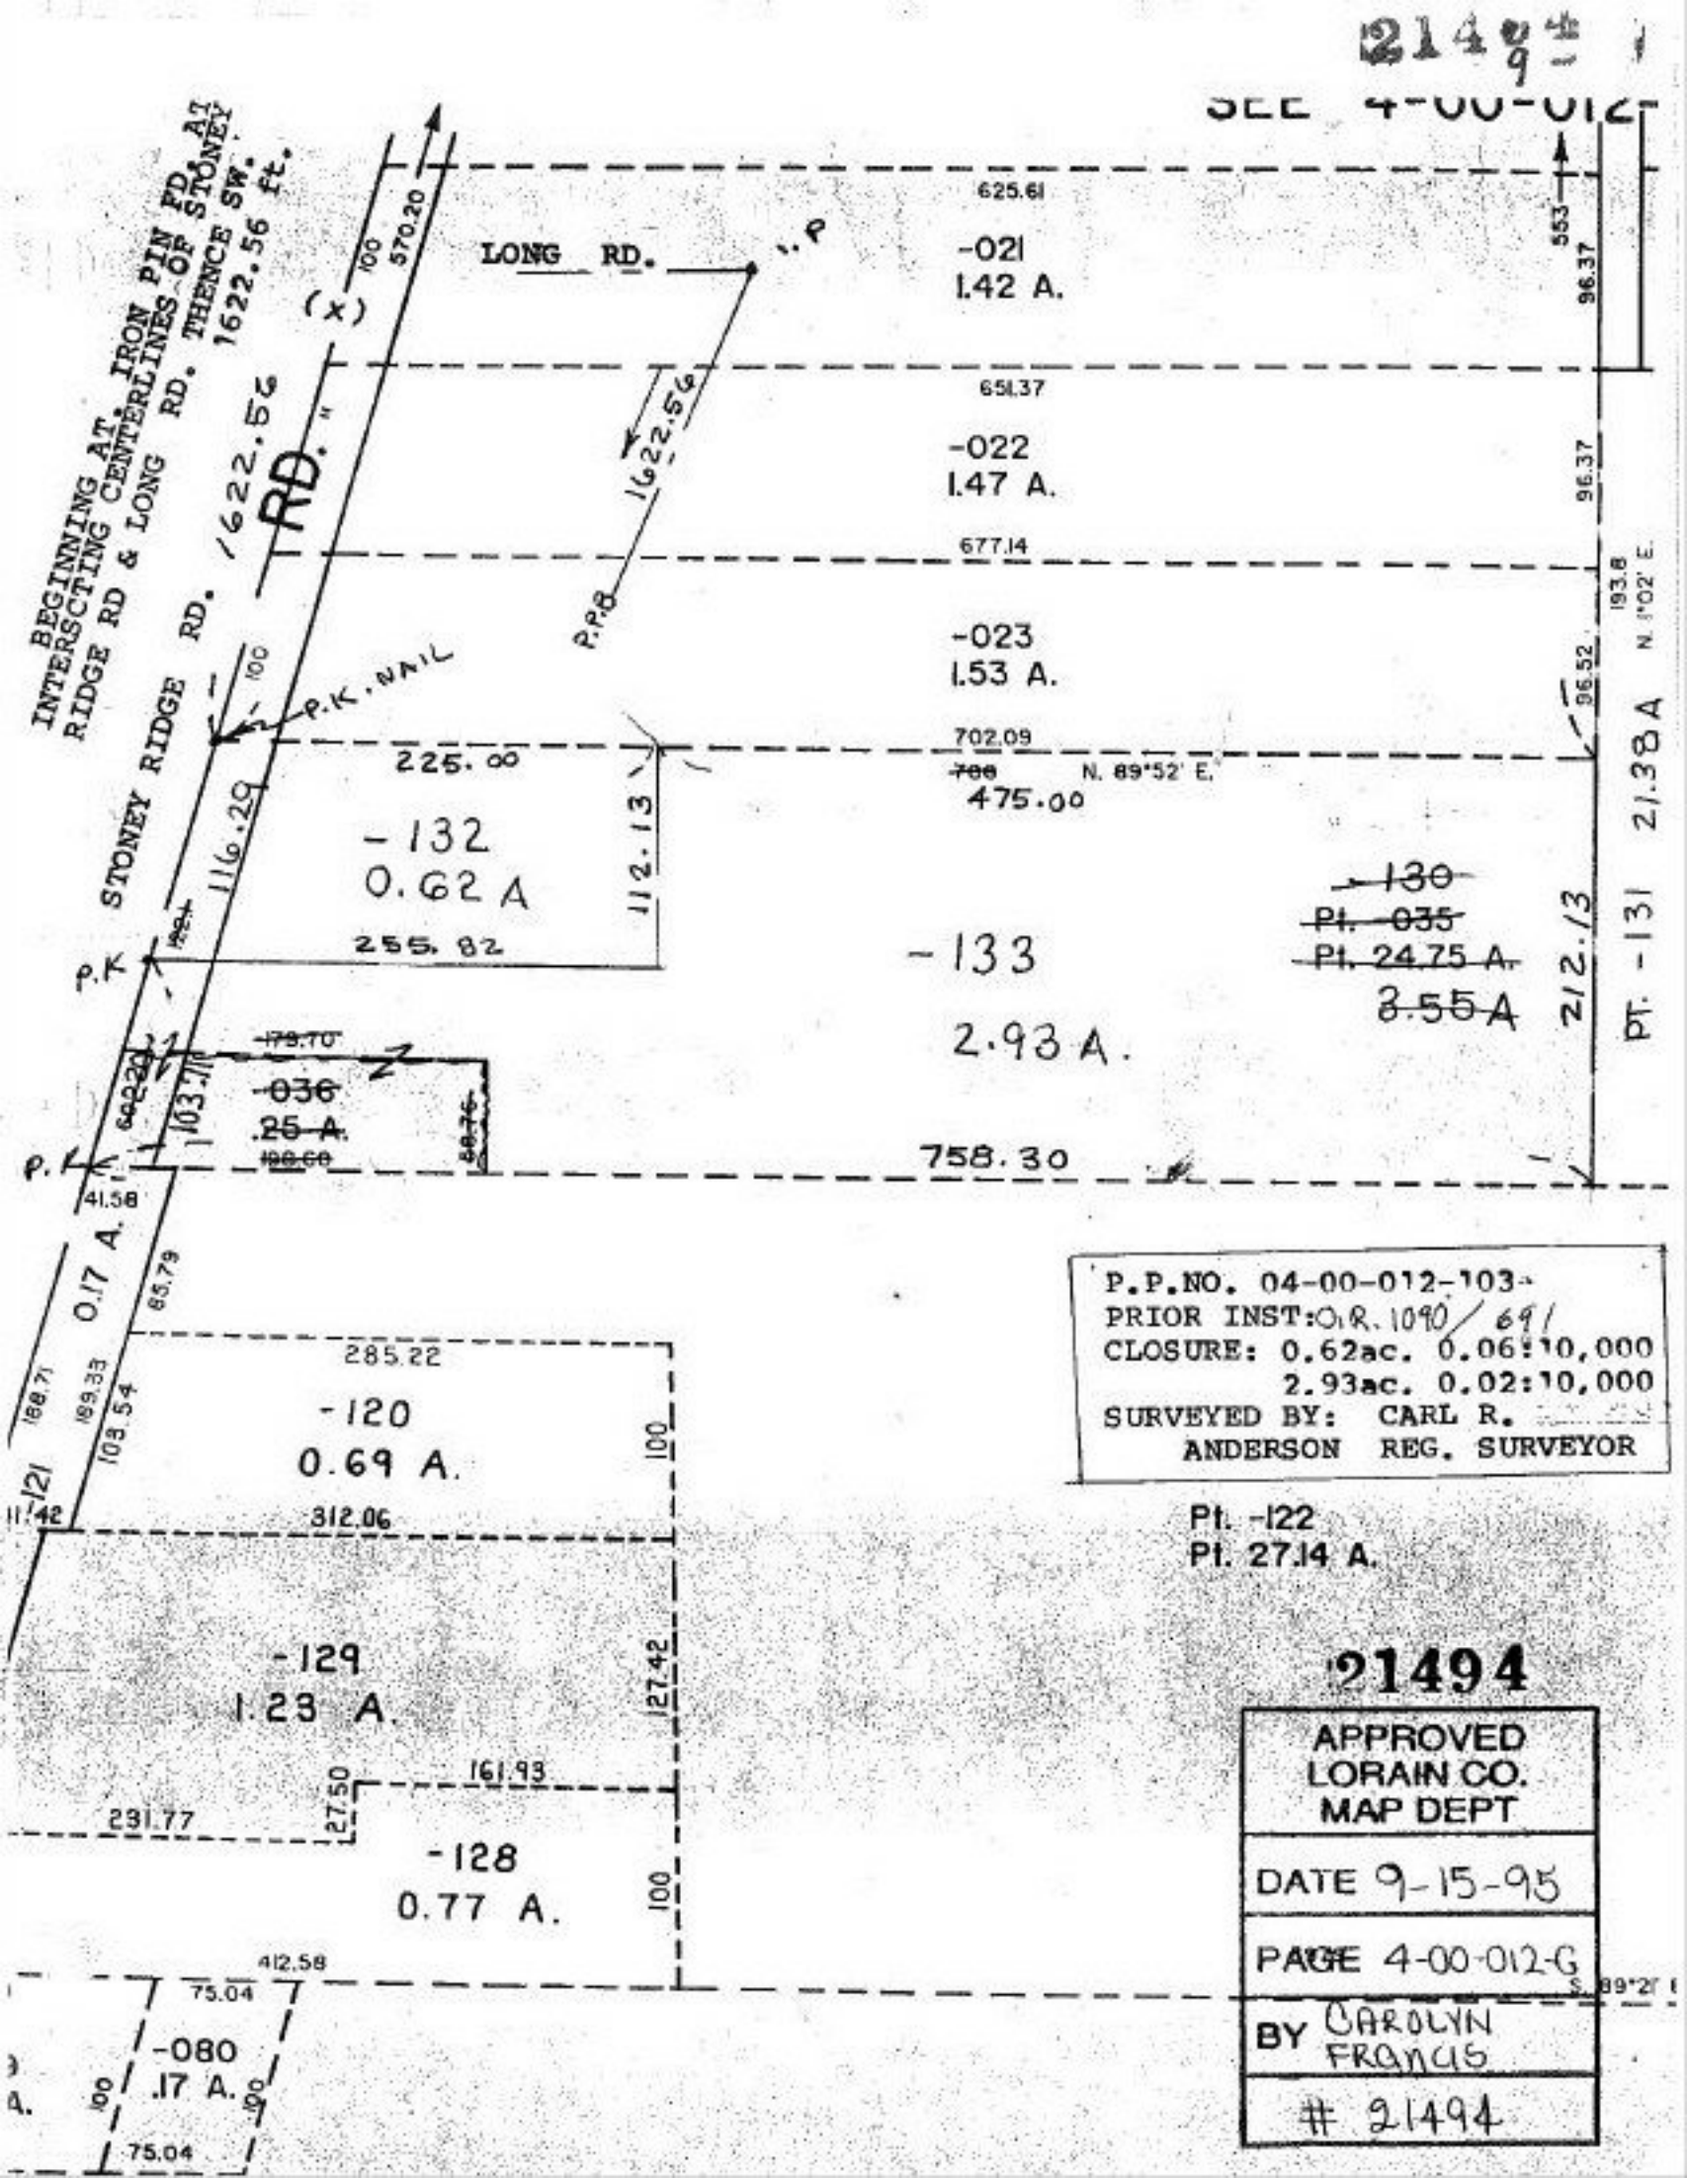
21494
SEE 4-00-012
BEGINNING AT IRON PIN FD. AT INTERSCTING CENTERLINES OF STONEY RIDGE RD & LONG RD. THENCE SW. 1622.56 ft.
STONEY RIDGE RD.
LONG RD.
625.61
-021
1.42 A.
651.37
-022
1.47 A.
677.14
-023
1.53 A.
702.09
N. 89°52' E.
475.00
193.8
N. 1°02' E.
21.38 A
PT. -131
212.13
96.37
96.52
1622.56
570.20
100
(x)
P.K. NAIL
225.80
116.29
112.13
-132
0.62 A
255.82
P.K.
-133
2.93 A.
-130
Pt. 035
Pt. 24.75 A.
3.55 A
179.70
-036
.25 A.
103.71
758.30
41.58
0.17 A.
65.79
285.22
-120
0.69 A.
312.06
100
-121
-122
Pt. 27.14 A.
-129
1.23 A.
127.42
161.93
27.50
231.77
-128
0.77 A.
412.58
75.04
-080
.17 A.
P.P.NO. 04-00-012-103
PRIOR INST: O.R. 1090/691
CLOSURE: 0.62ac. 0.06:10,000
2.93ac. 0.02:10,000
SURVEYED BY: CARL R. ANDERSON REG. SURVEYOR
21494
APPROVED LORAIN CO. MAP DEPT
DATE 9-15-95
PAGE 4-00-012-G
BY CAROLYN FRANCIS
21494