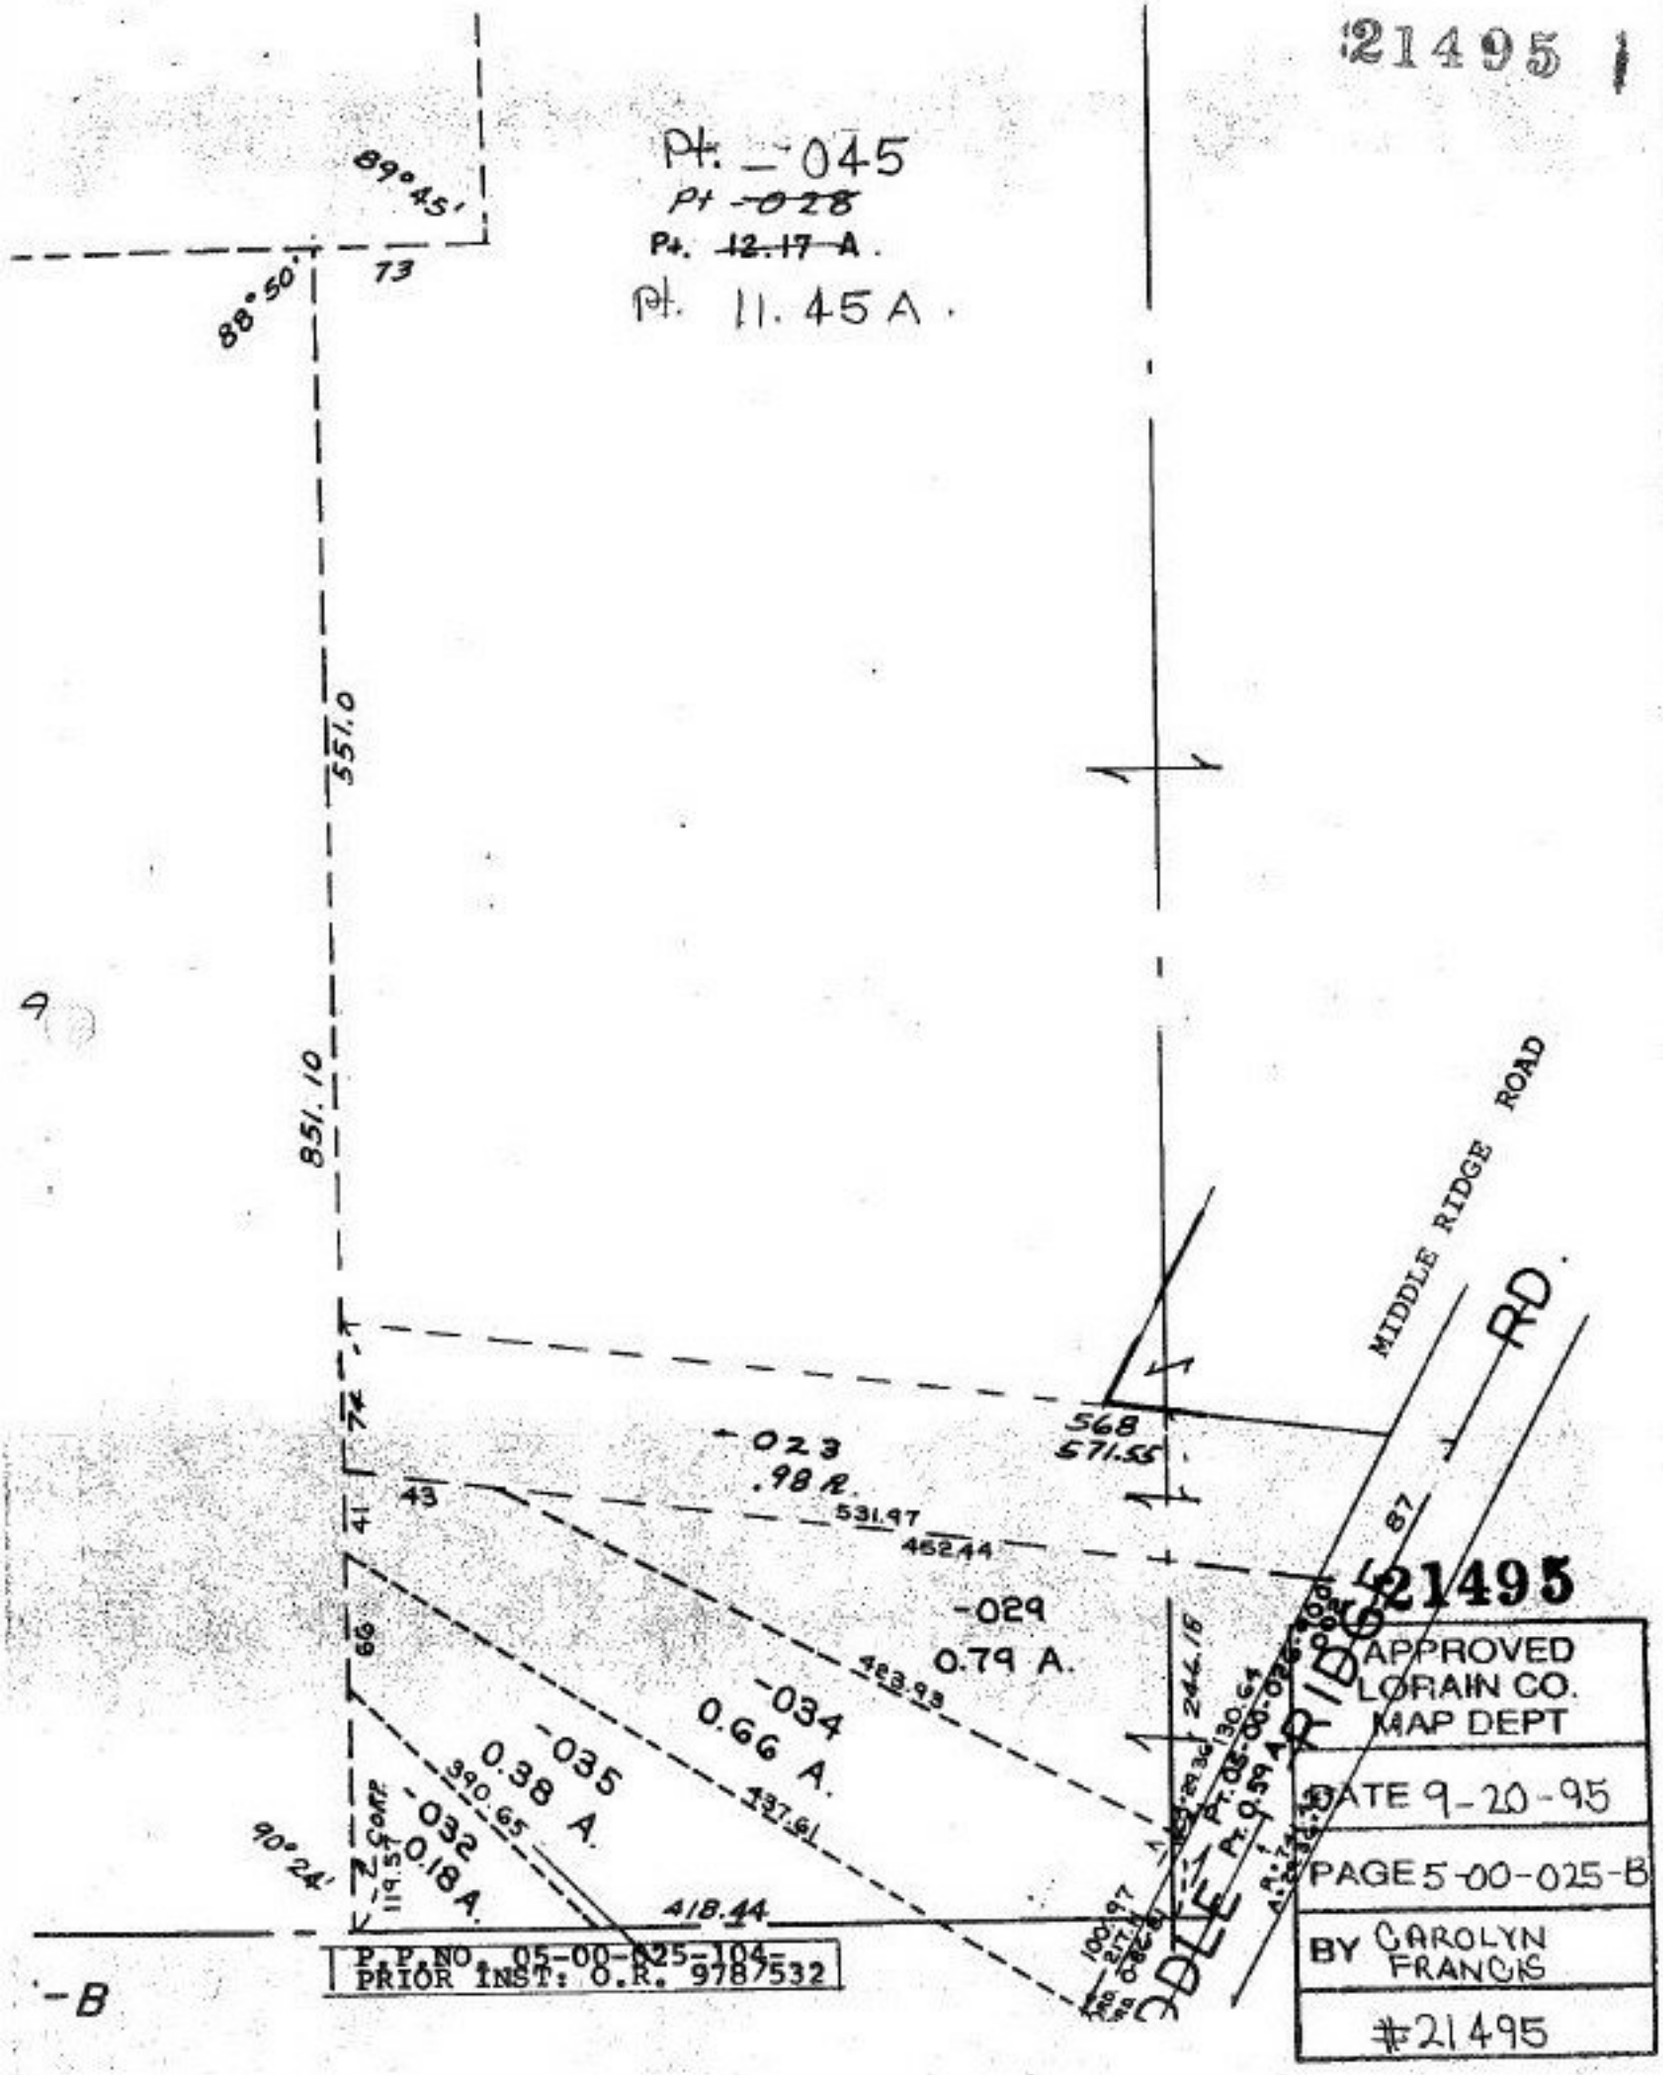
21495
Pt. -045
Pt ~~-028~~
Pt. ~~12.17 A~~.
Pt. 11.45 A.
89°45'
88°50'
73
551.0
851.10
74
41
43
66
90°24'
119.57
-023
.98 A.
531.97
452.44
568
571.55
-029
0.79 A.
423.93
-034
0.66 A.
437.61
-035
0.38 A.
390.65
-032
0.18 A.
418.44
244.18
MIDDLE RIDGE ROAD
RD.
87
21495
APPROVED
LORAIN CO.
MAP DEPT
DATE 9-20-95
PAGE 5-00-025-B
BY CAROLYN FRANCIS
#21495
P.P.NO. 05-00-025-104-
PRIOR INST: O.R. 9787532
-B