21495

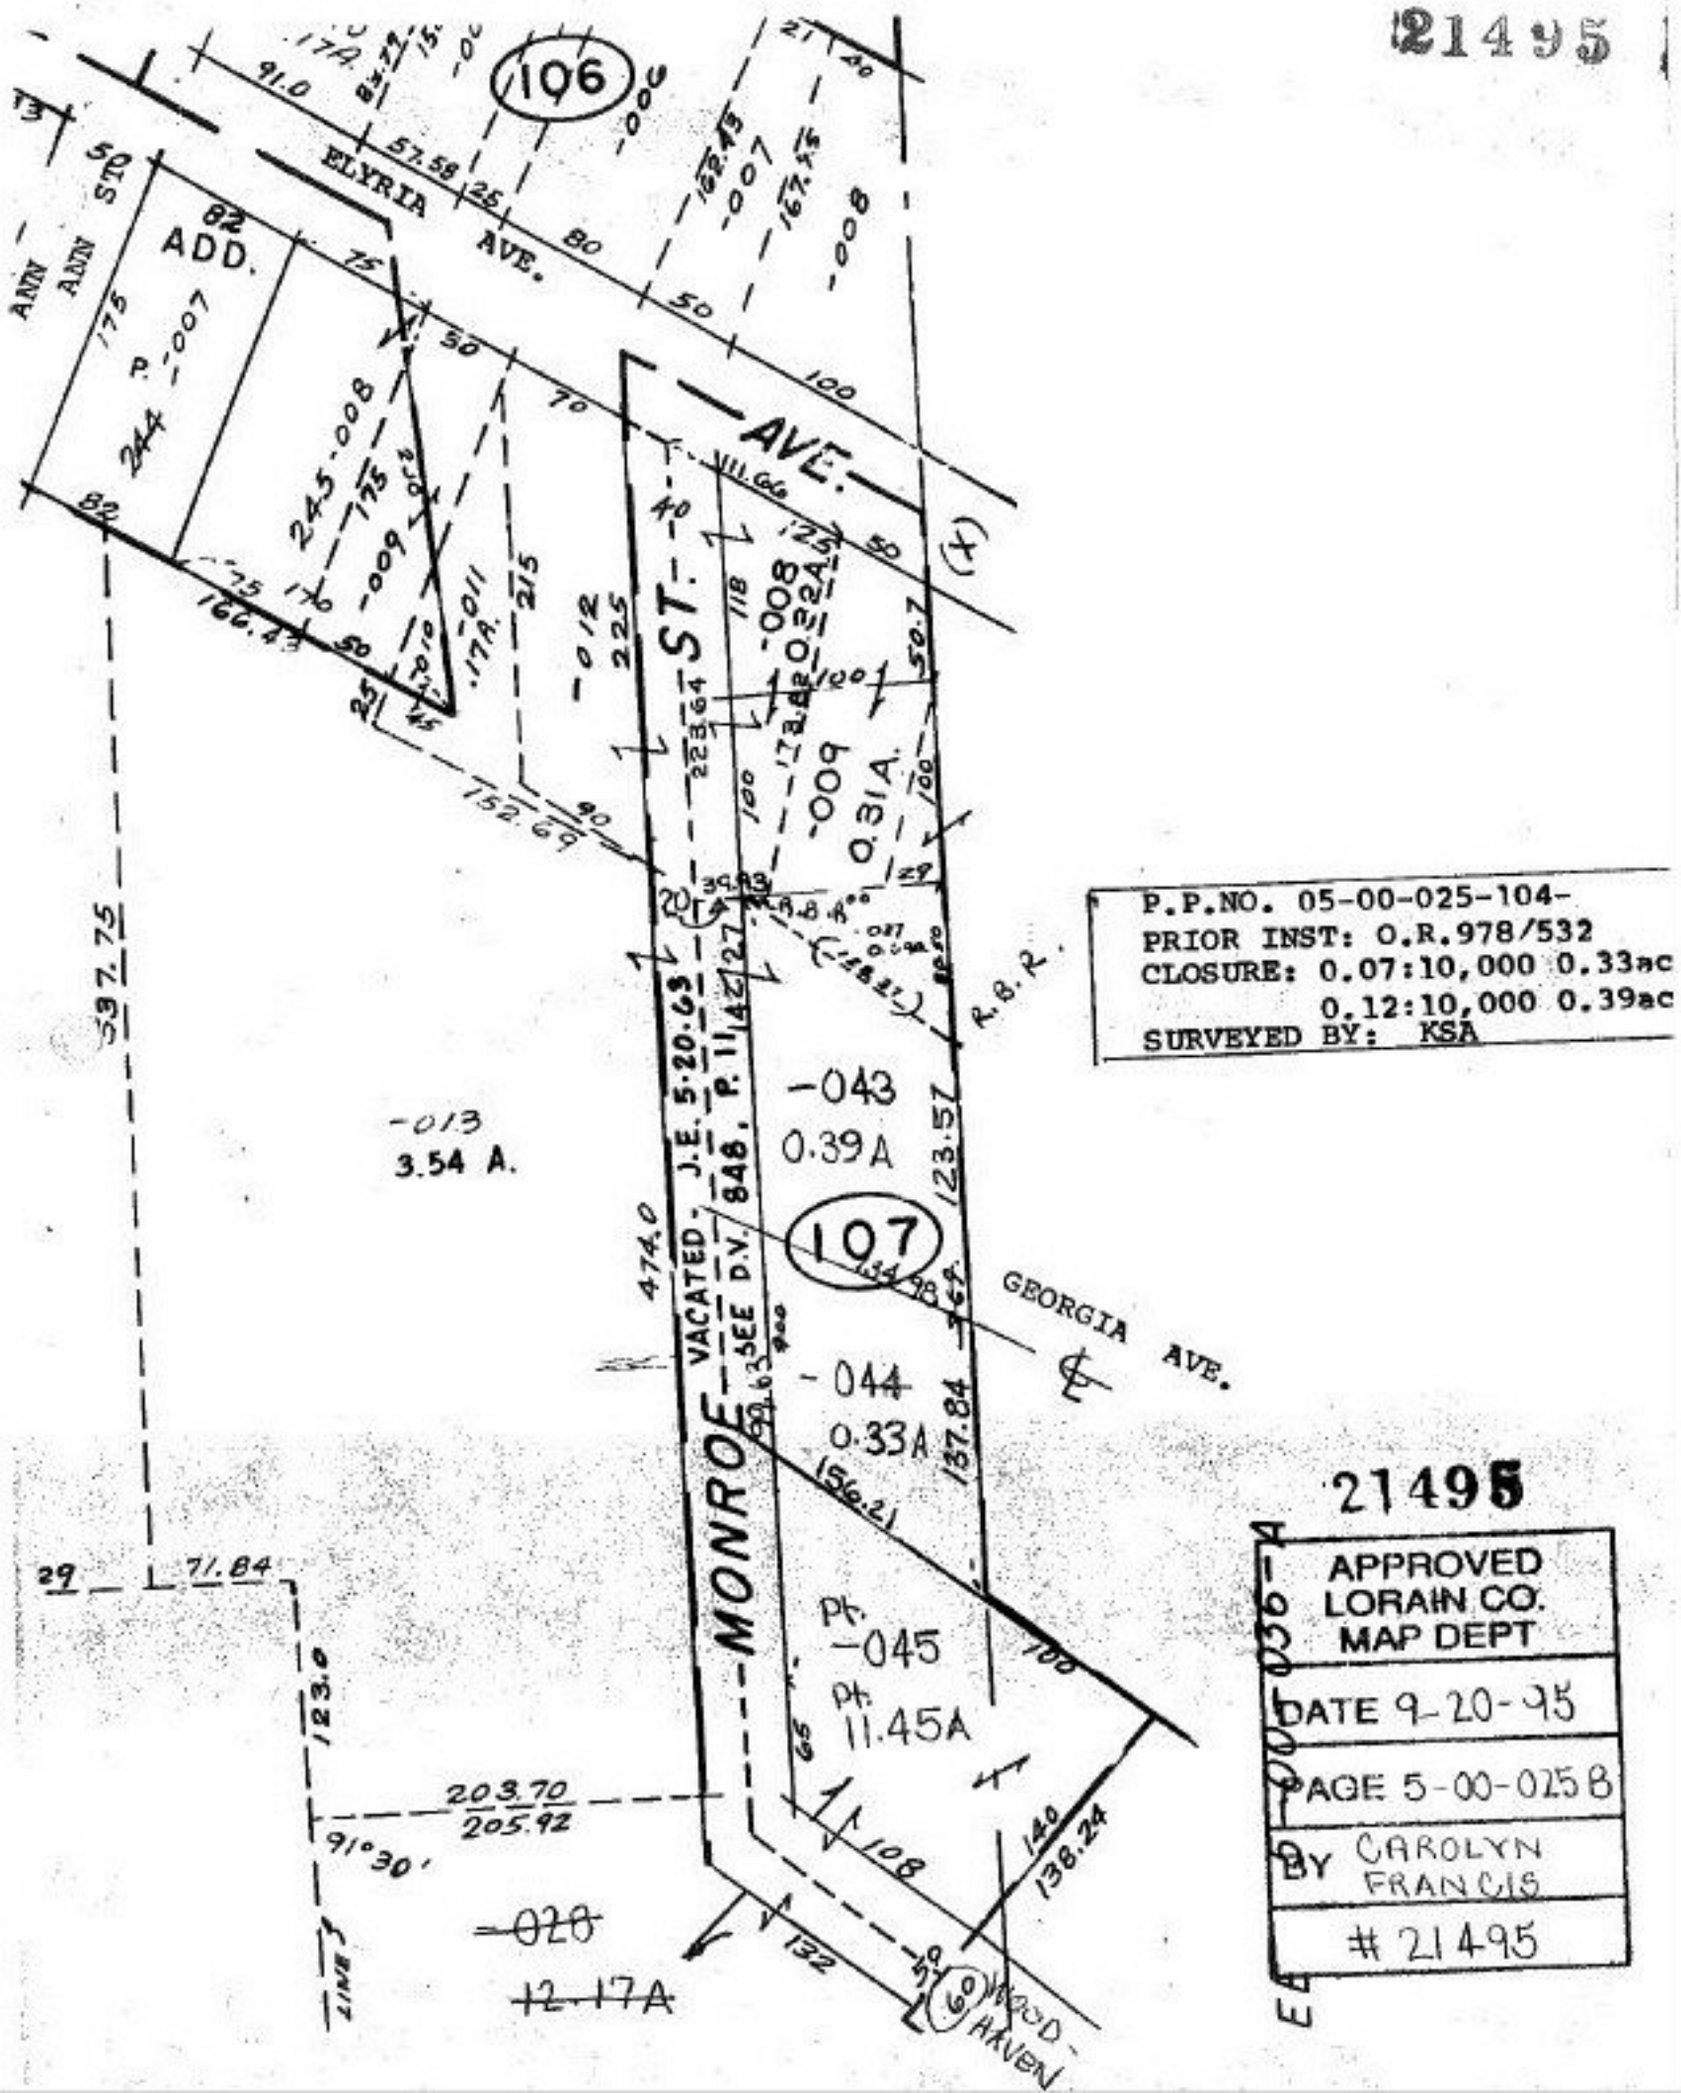

P.P.NO. 05-00-025-104-
PRIOR INST: O.R.978/532
CLOSURE: 0.07:10,000 0.33ac
0.12:10,000 0.39ac
SURVEYED BY: KSA

21495

APPROVED
LORAIN CO.
MAP DEPT

DATE 9-20-95

PAGE 5-00-025 B

BY CAROLYN FRANCIS

21495

EA 005-036-04