21498

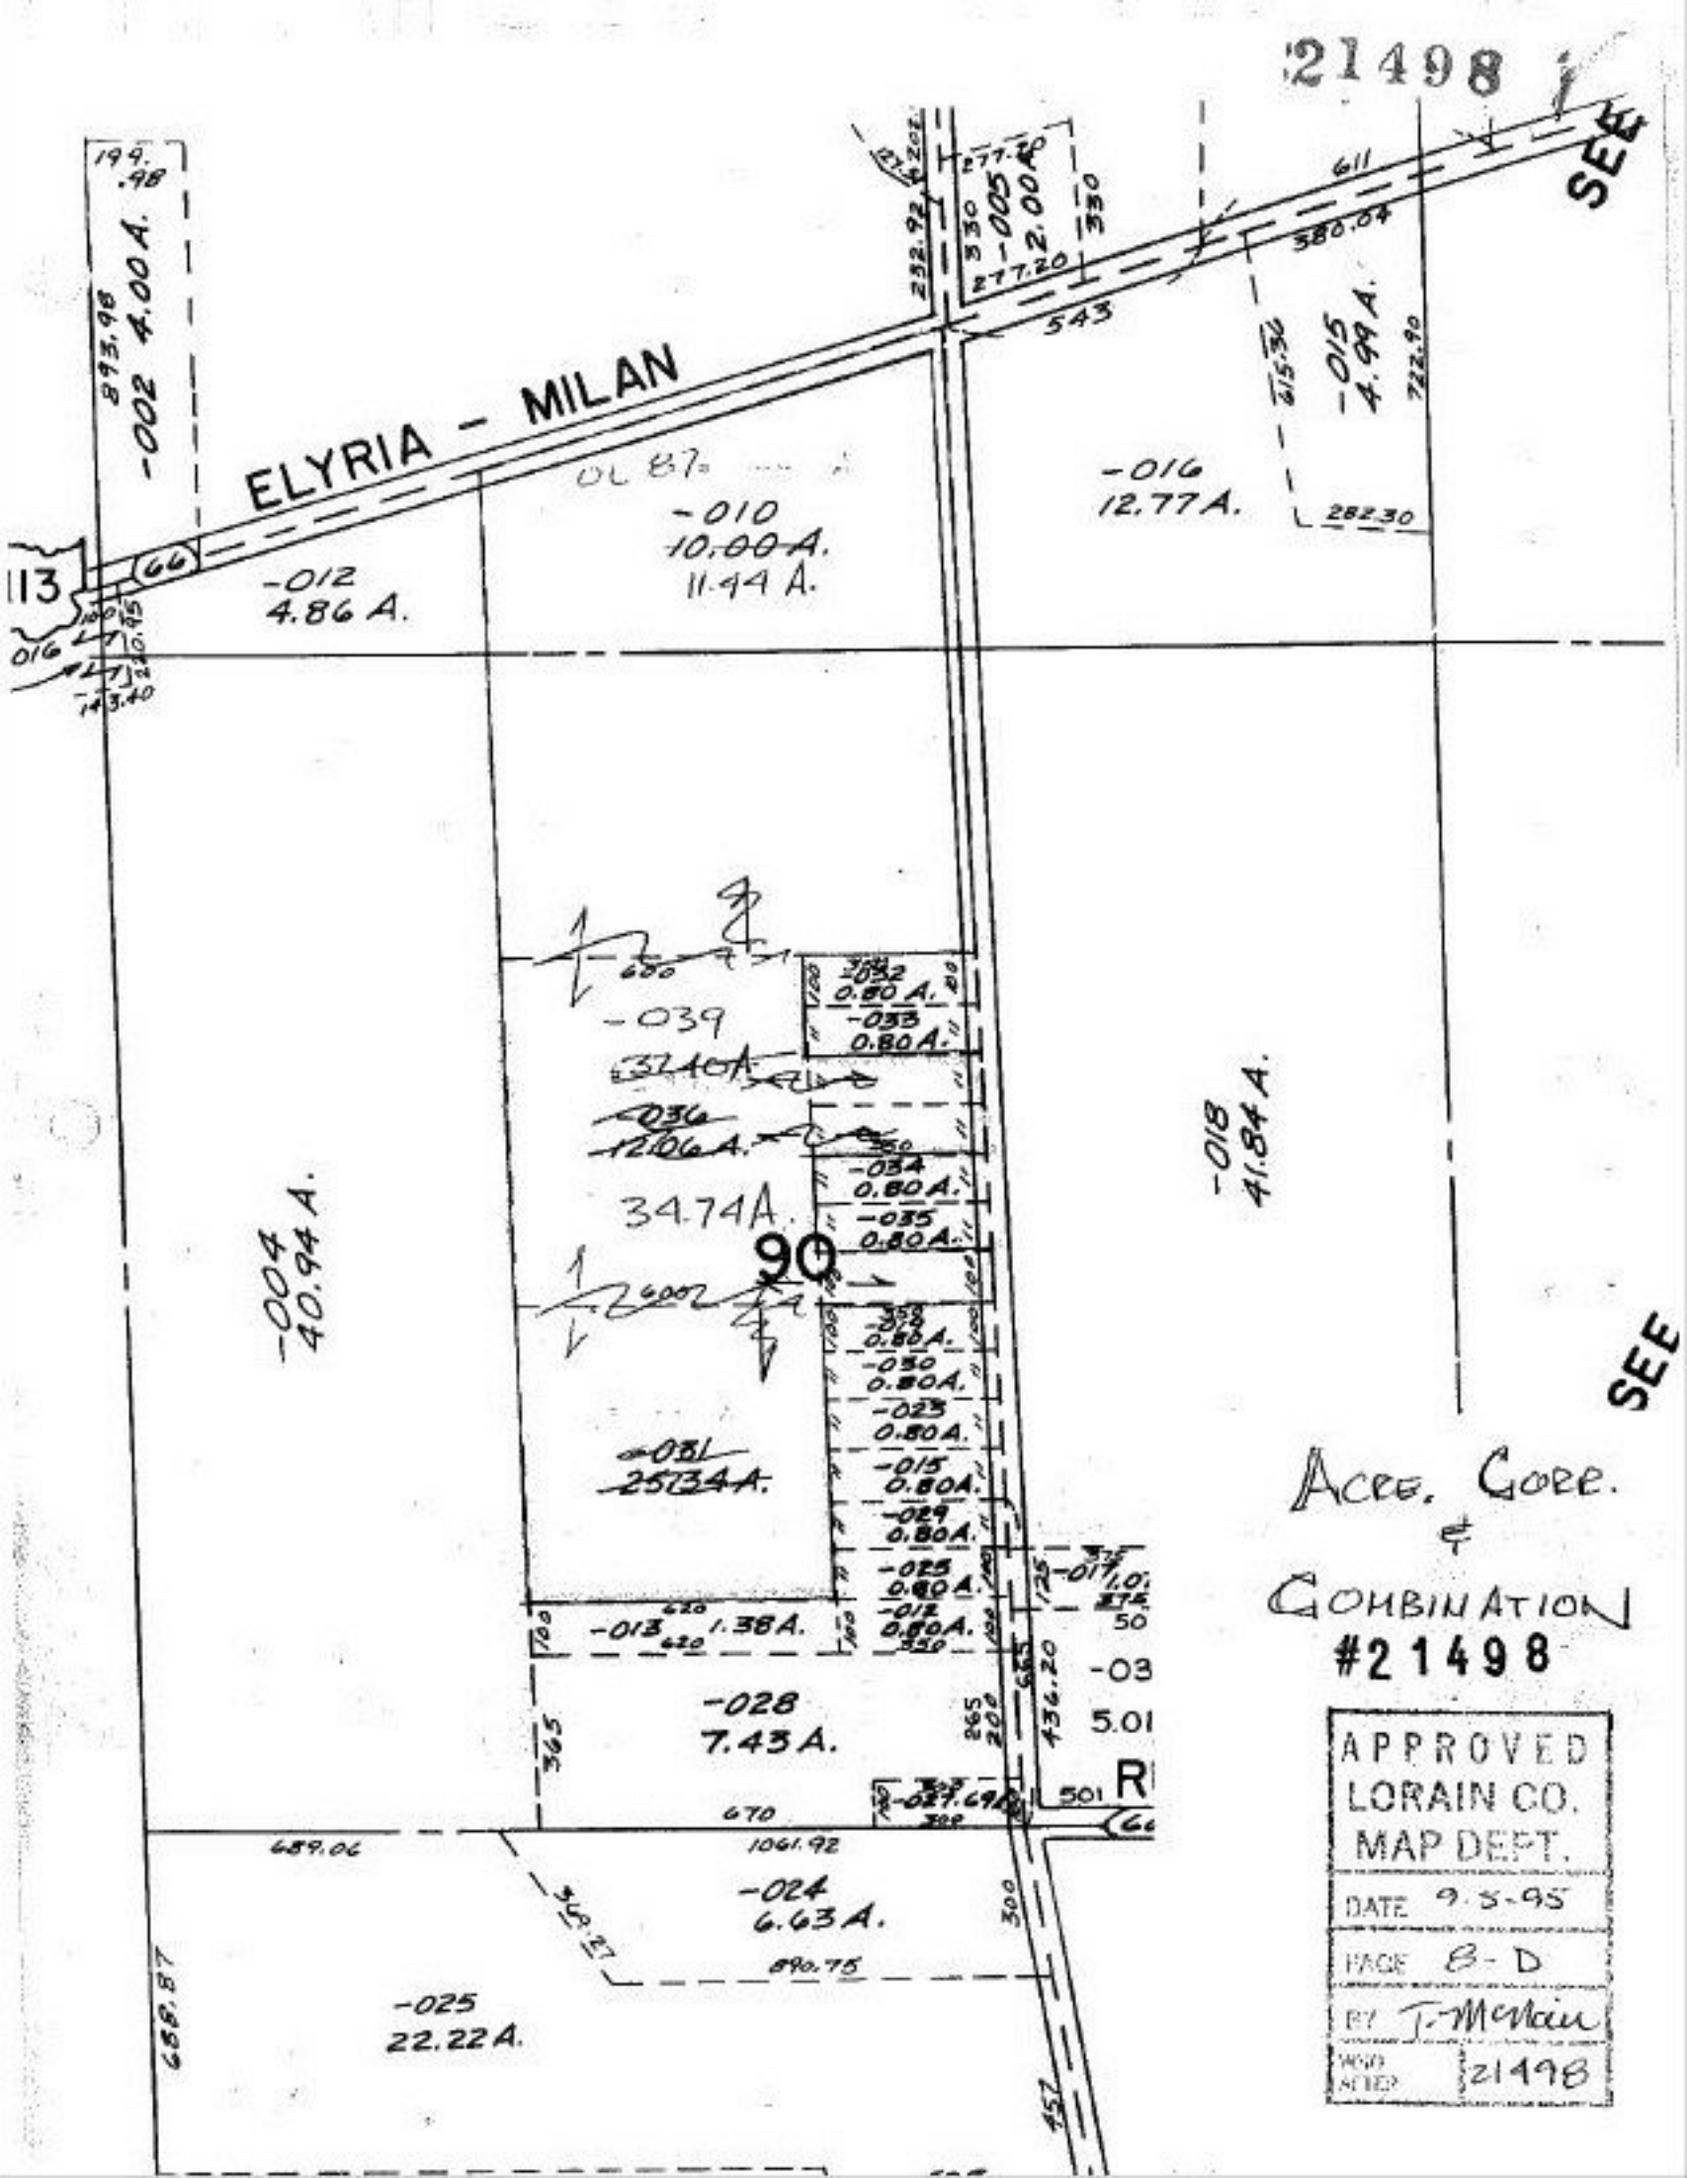

ACRE. CORR. & COMBINATION #21498

APPROVED LORAIN CO. MAP DEPT.	
DATE	9-5-95
PAGE	B-D
BY	J. McClain
MAP NO. REF.	21498