21504

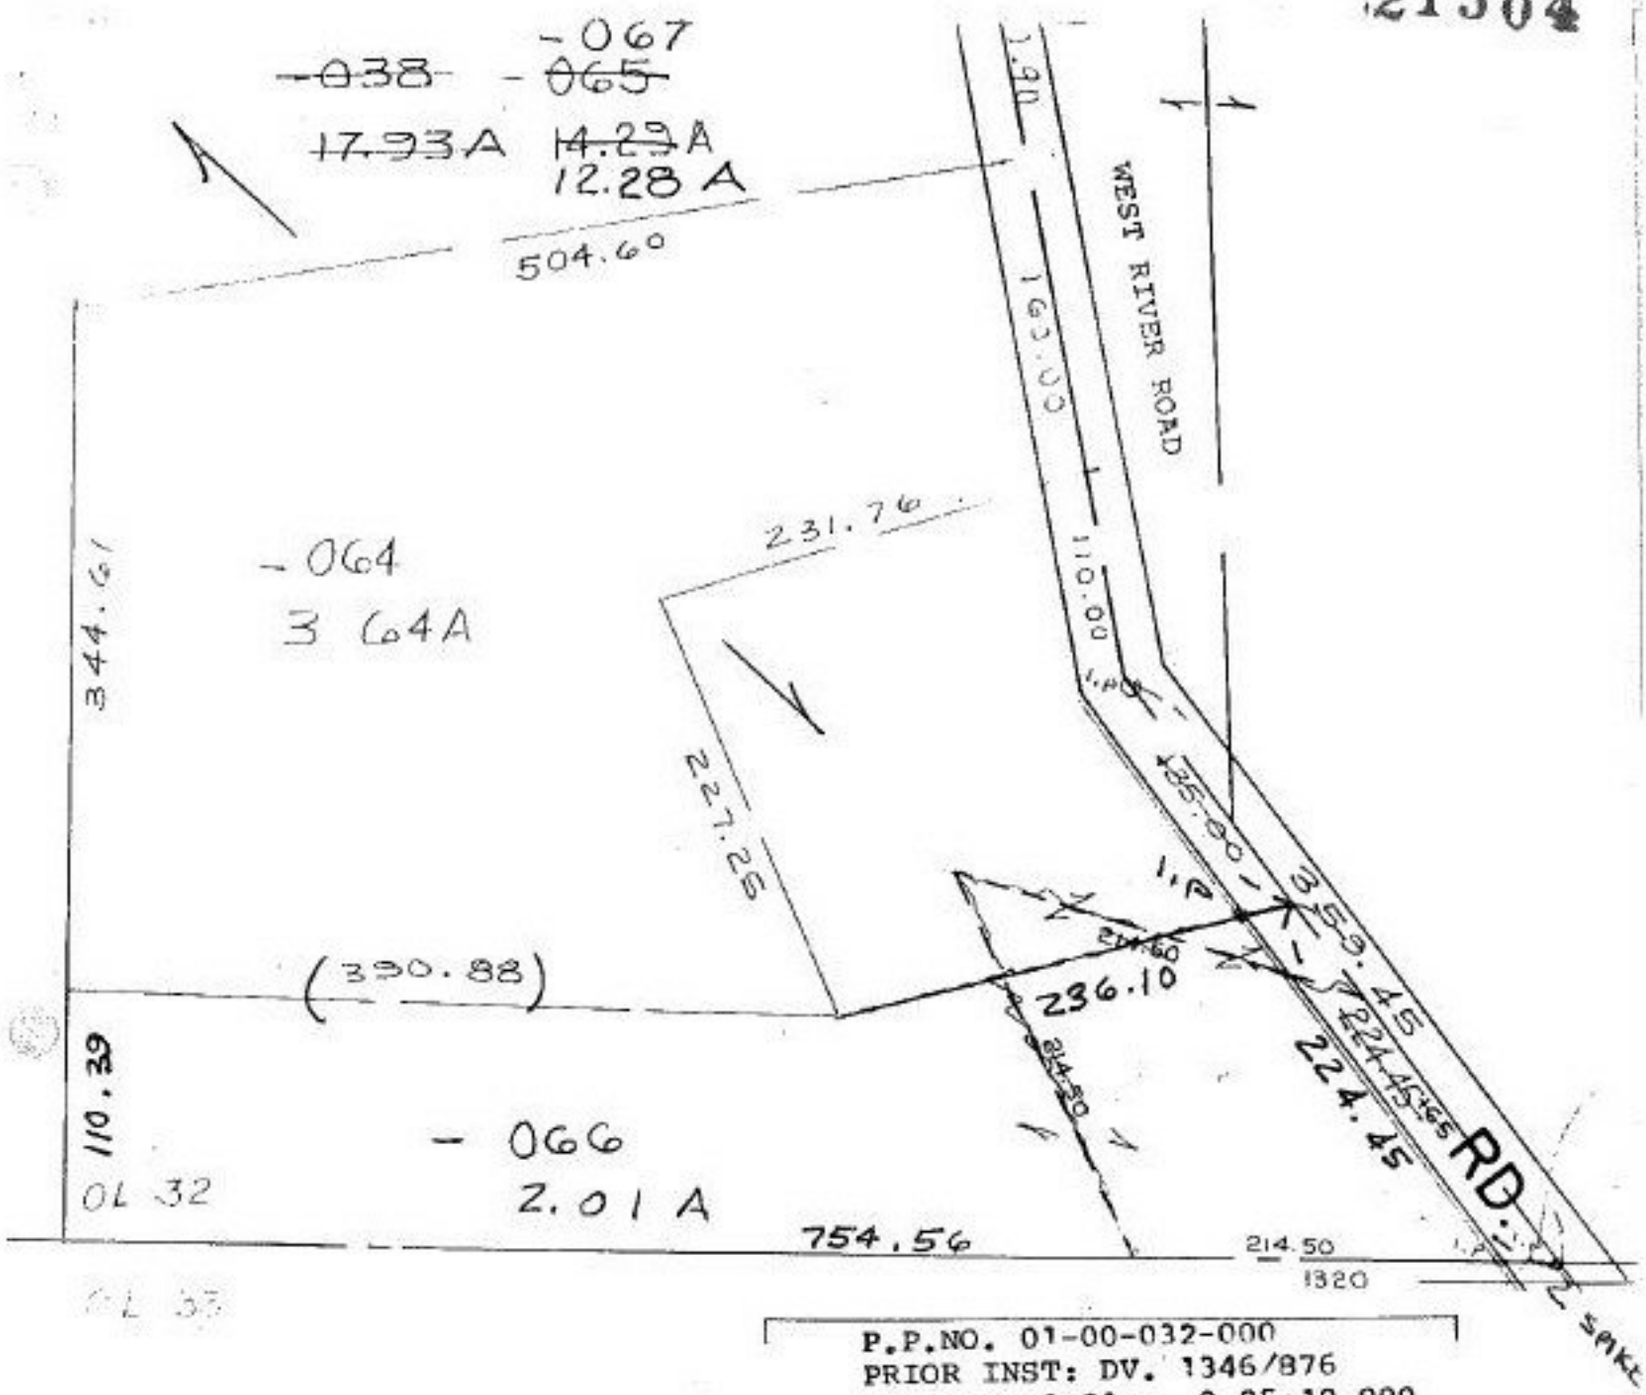


P.P.NO. 01-00-032-000
PRIOR INST: DV. 1346/876
CLOSURE: 2.01ac. 0.05:10,000
SURVEYED BY: N.R. HURA
REG. SURVEYOR

21504

| APPROVED LORAIN CO. MAP DEPT |
|---|
| DATE 9-29-95 |
| PAGE 1-00-032A |
| BY CAROLYN FRANCIS |
| #21504 |

# NHELM TWP.

00'