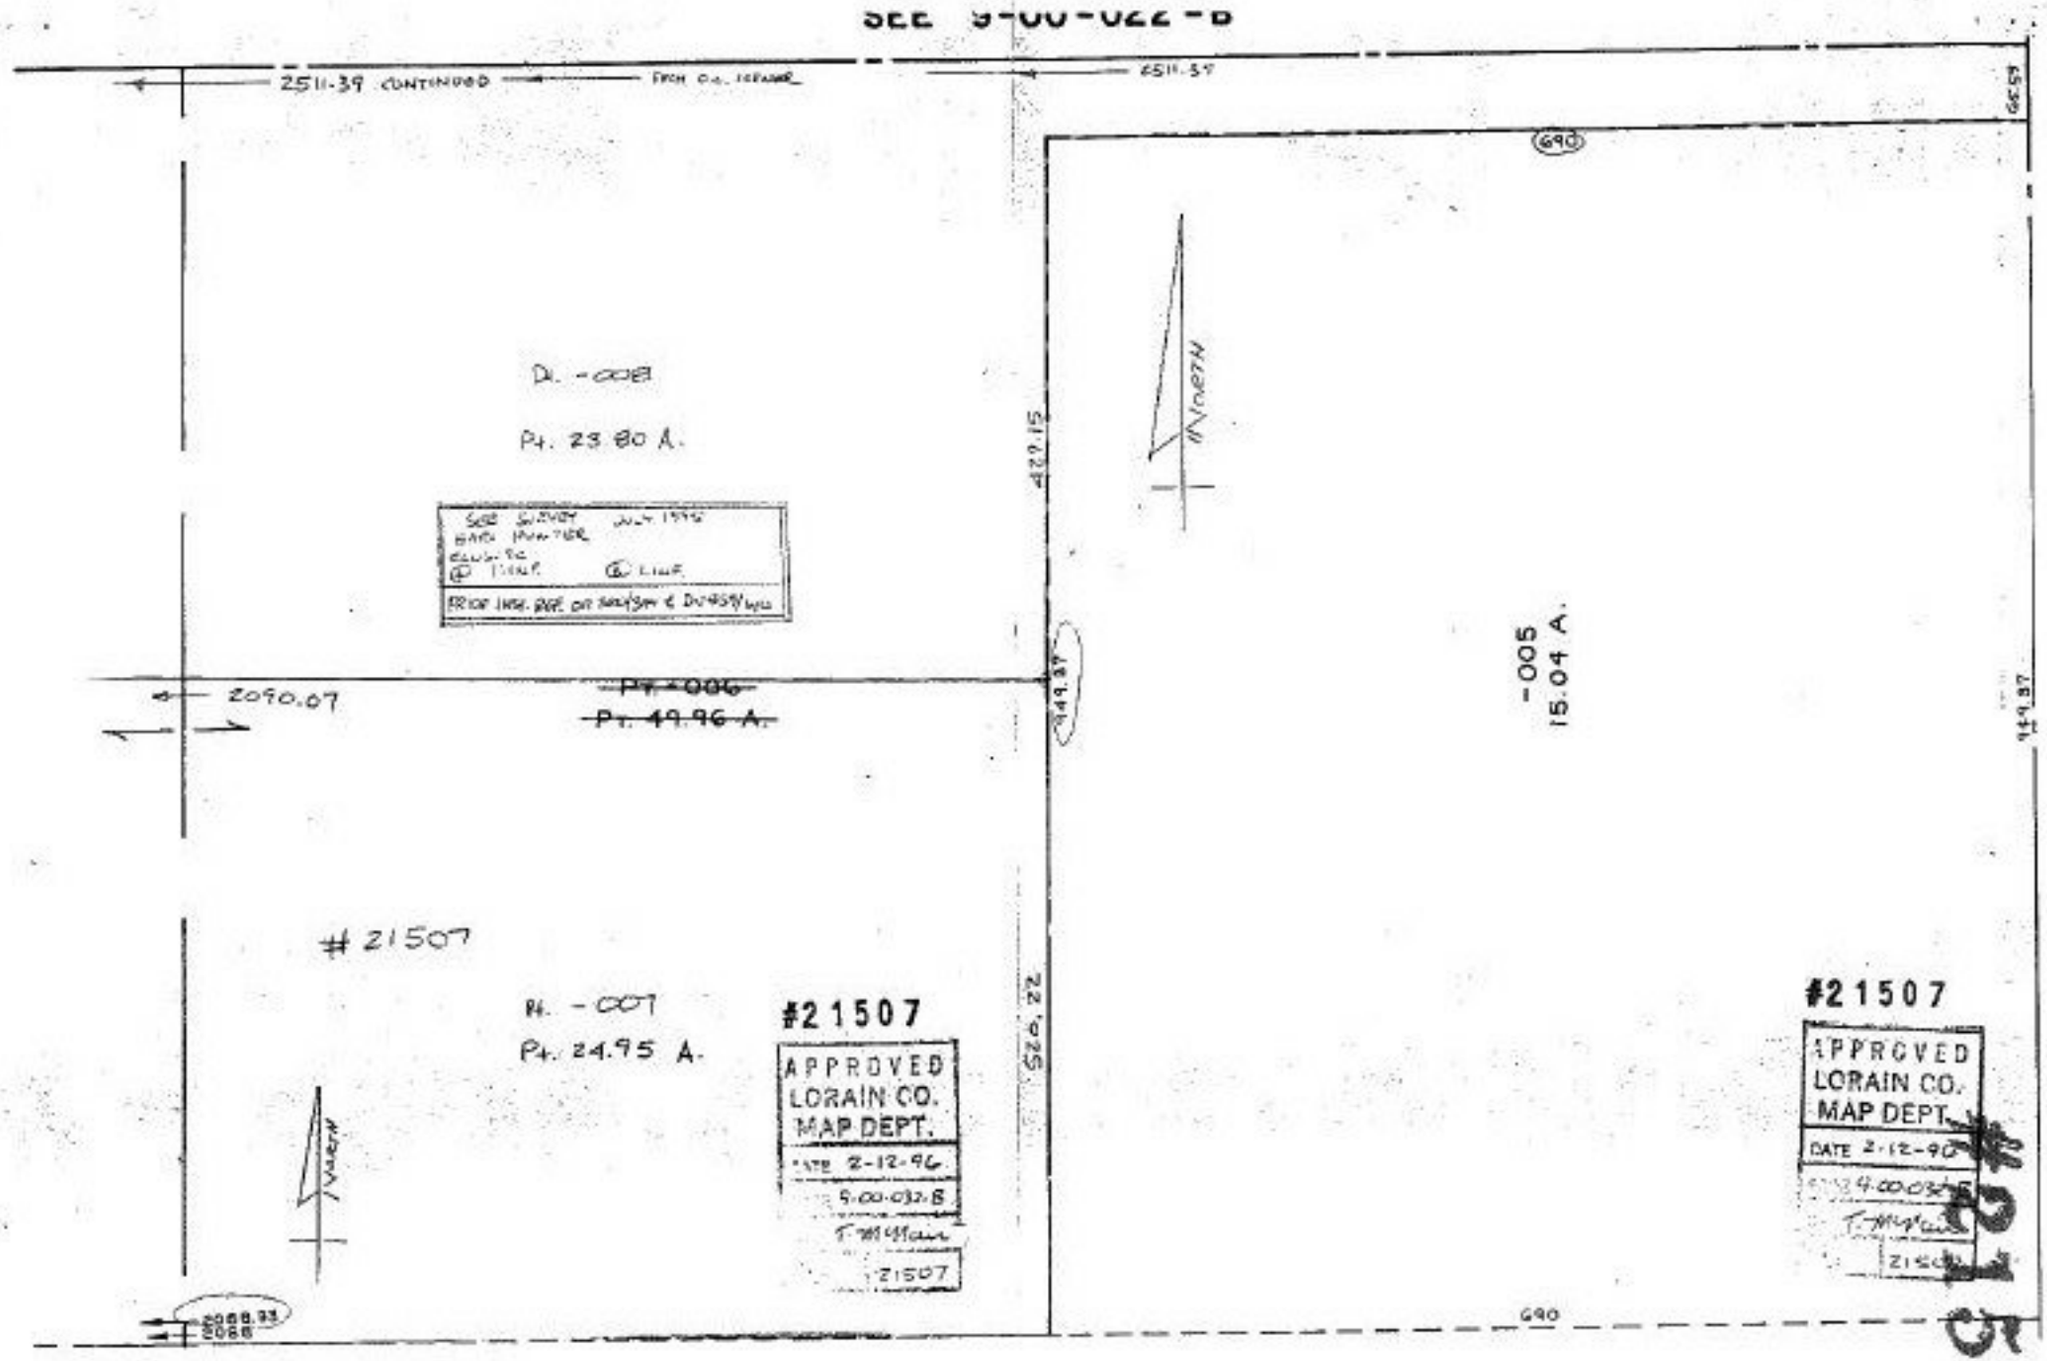
SEE 9-00-022-B
2511.39 CONTINUED
2511.39
690
Pt. -008
Pt. 23.80 A.
NORTH
429.15
2090.07
~~Pt. -006~~
~~Pt. 49.96 A.~~
949.87
-005
15.04 A.
949.87
21507
Pt. -007
Pt. 24.95 A.
#21507
APPROVED
LORAIN CO.
MAP DEPT.
DATE 2-12-96
9-00-032-B
21507
520.22
#21507
APPROVED
LORAIN CO.
MAP DEPT.
DATE 2-12-96
2088.93
2088
690

#21507