#21512D

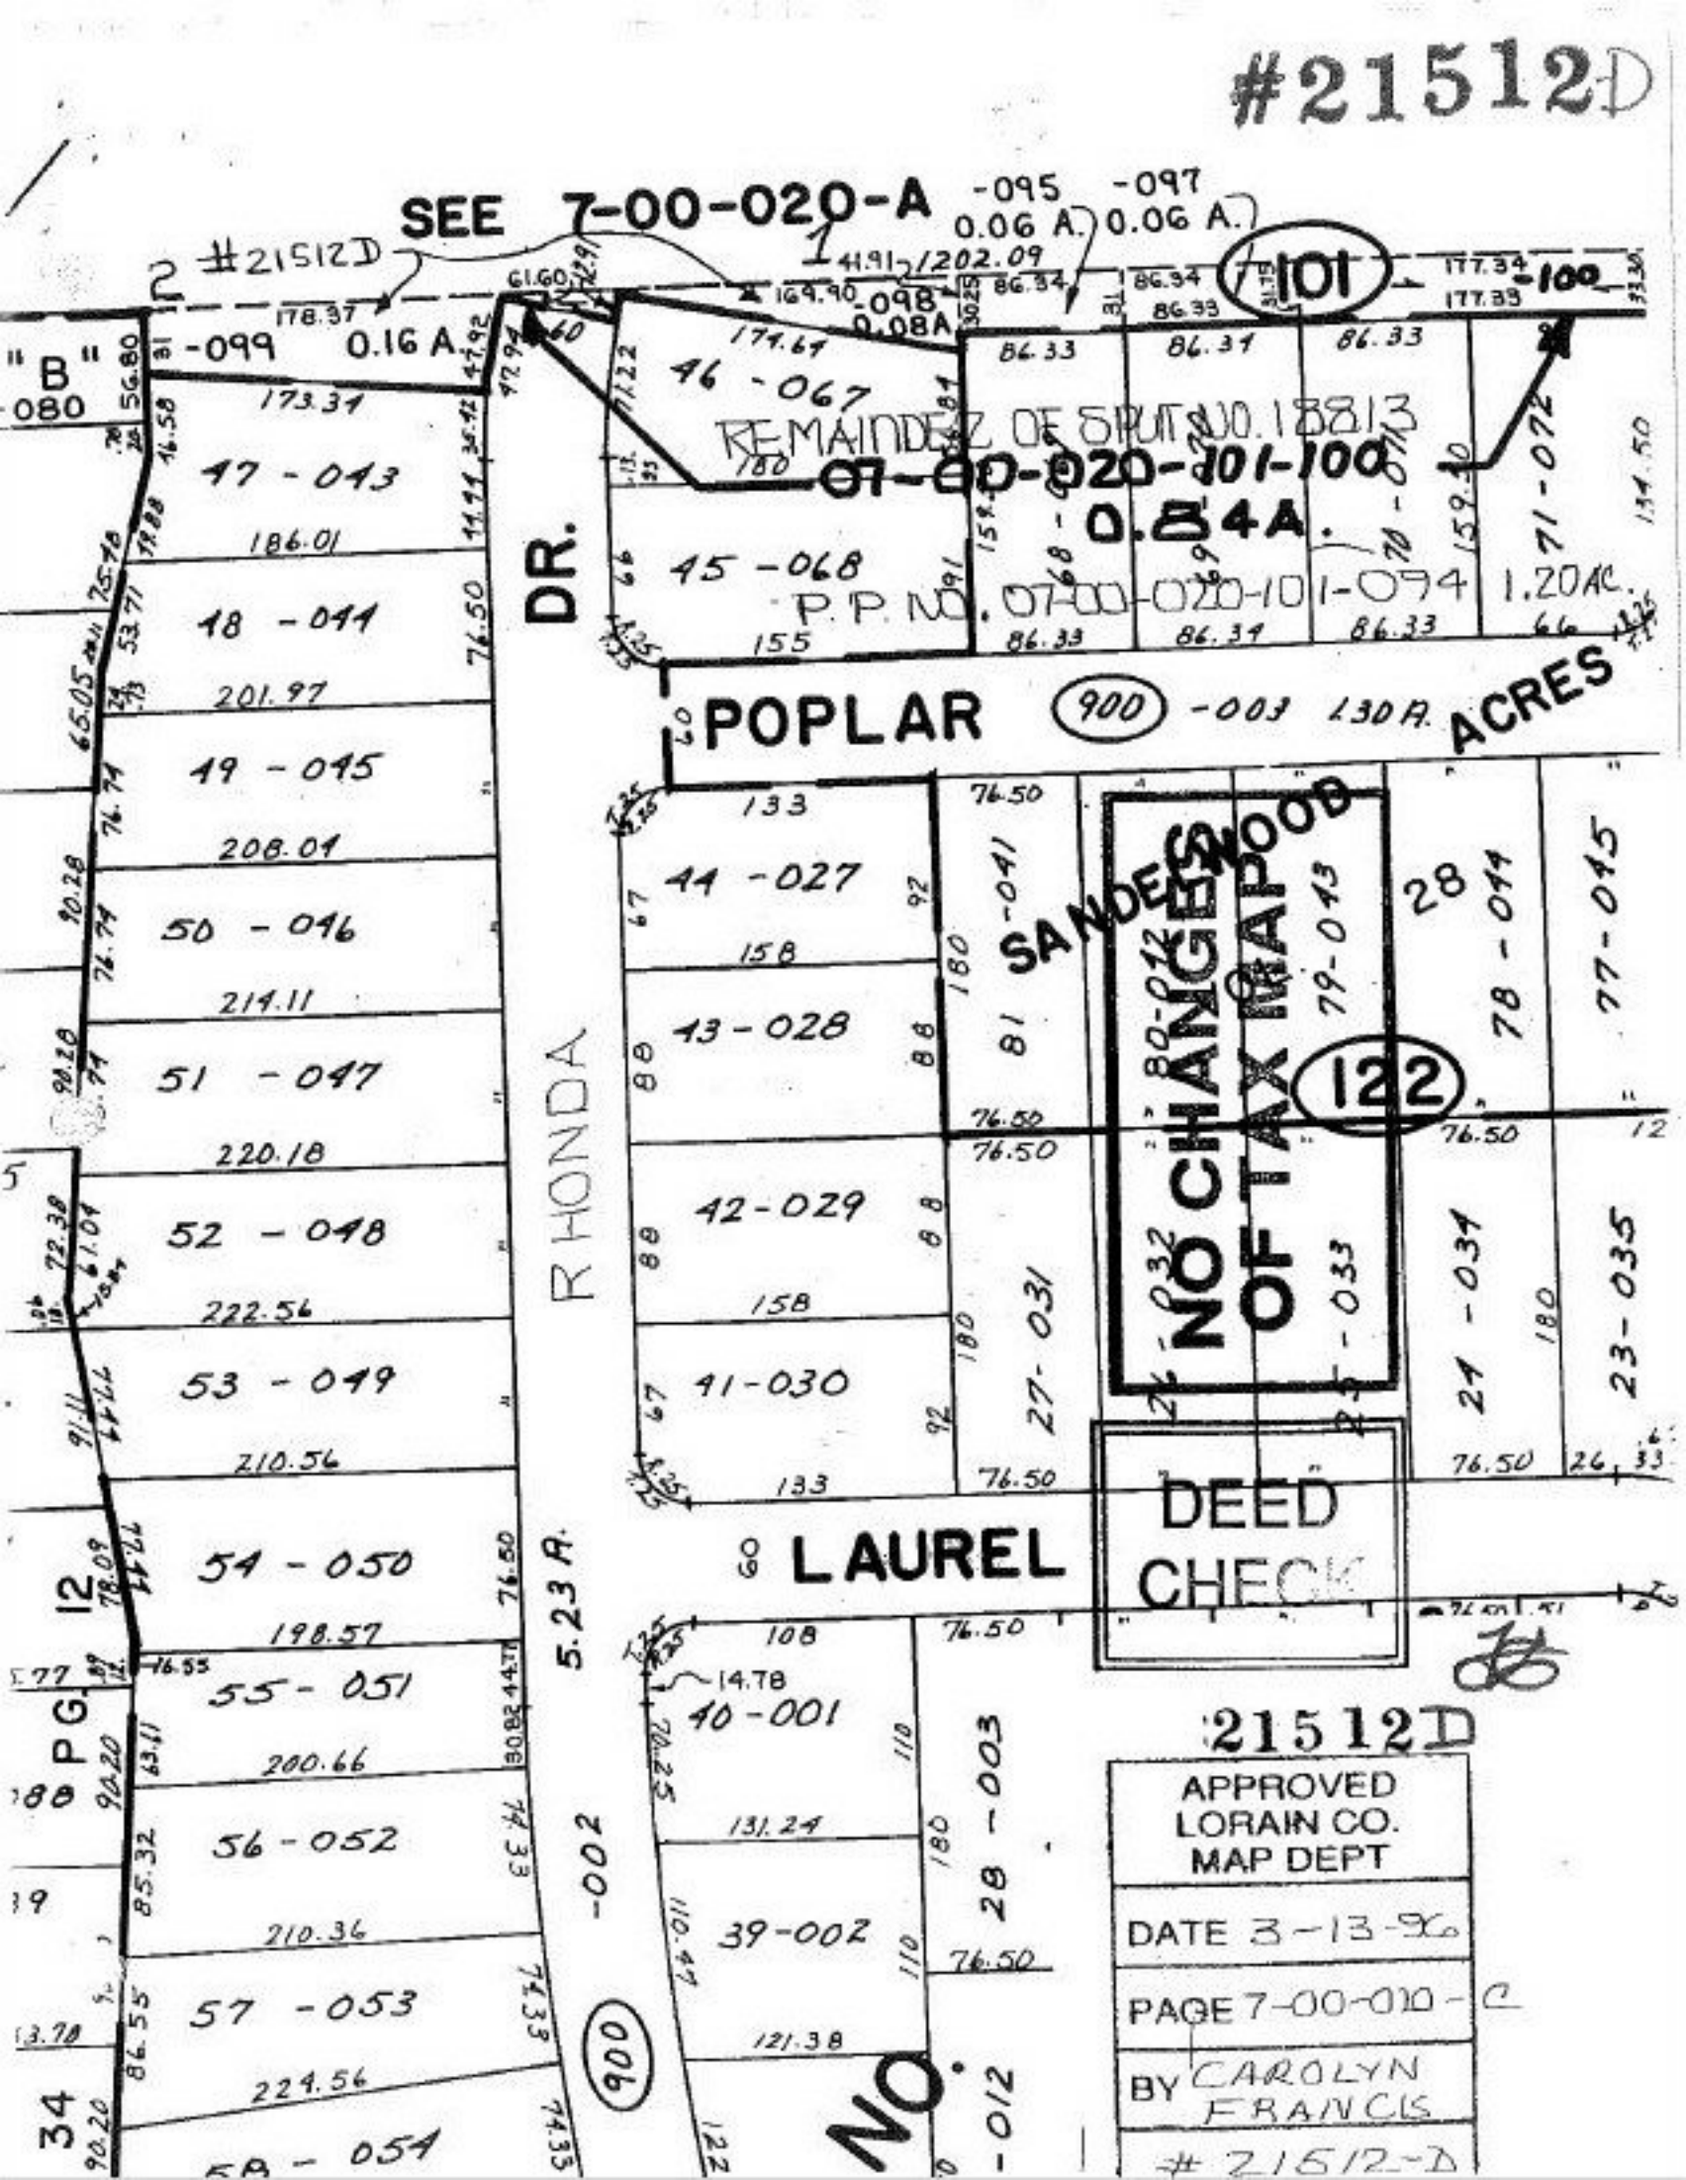
SEE 7-00-020-A
-095 0.06 A.
-097 0.06 A.
#21512D
178.37
-099 0.16 A.
-098 0.08A
101
100
177.34
177.33
86.34
86.33
86.31
86.33
41.91
202.09
169.90
174.67
46 -067
REMAINDER OF SPLIT NO. 138813
07-00-020-101-100
0.84A.
47 - 043
186.01
45 -068
P.P. NO. 07-00-020-101-094
1.20AC.
155
18 - 044
201.97
49 - 045
208.01
50 - 046
214.11
51 - 047
220.18
52 - 048
222.56
53 - 049
210.56
54 - 050
198.57
55 - 051
200.66
56 - 052
210.36
57 - 053
224.56
58 - 054
POPLAR
900
-003 1.30A.
ACRES
133
44 -027
158
43 -028
42 -029
158
41 -030
158
81
SANDERS
NO CHANGES
OF TAX MAPOOB
79-013
78 - 044
77 - 015
122
28
27- 031
-033
21 - 031
23 - 035
180
76.50
DEED
CHECK
LAUREL
108
14.78
40 -001
131.24
39 -002
121.38
28 - 003
-002
-012
5.23 A.
R HONDA
DR.
900
NO.
12
34
PG
21512D
APPROVED
LORAIN CO.
MAP DEPT
DATE 3-13-96
PAGE 7-00-010 - C
BY CAROLYN FRANCIS
#21512-D