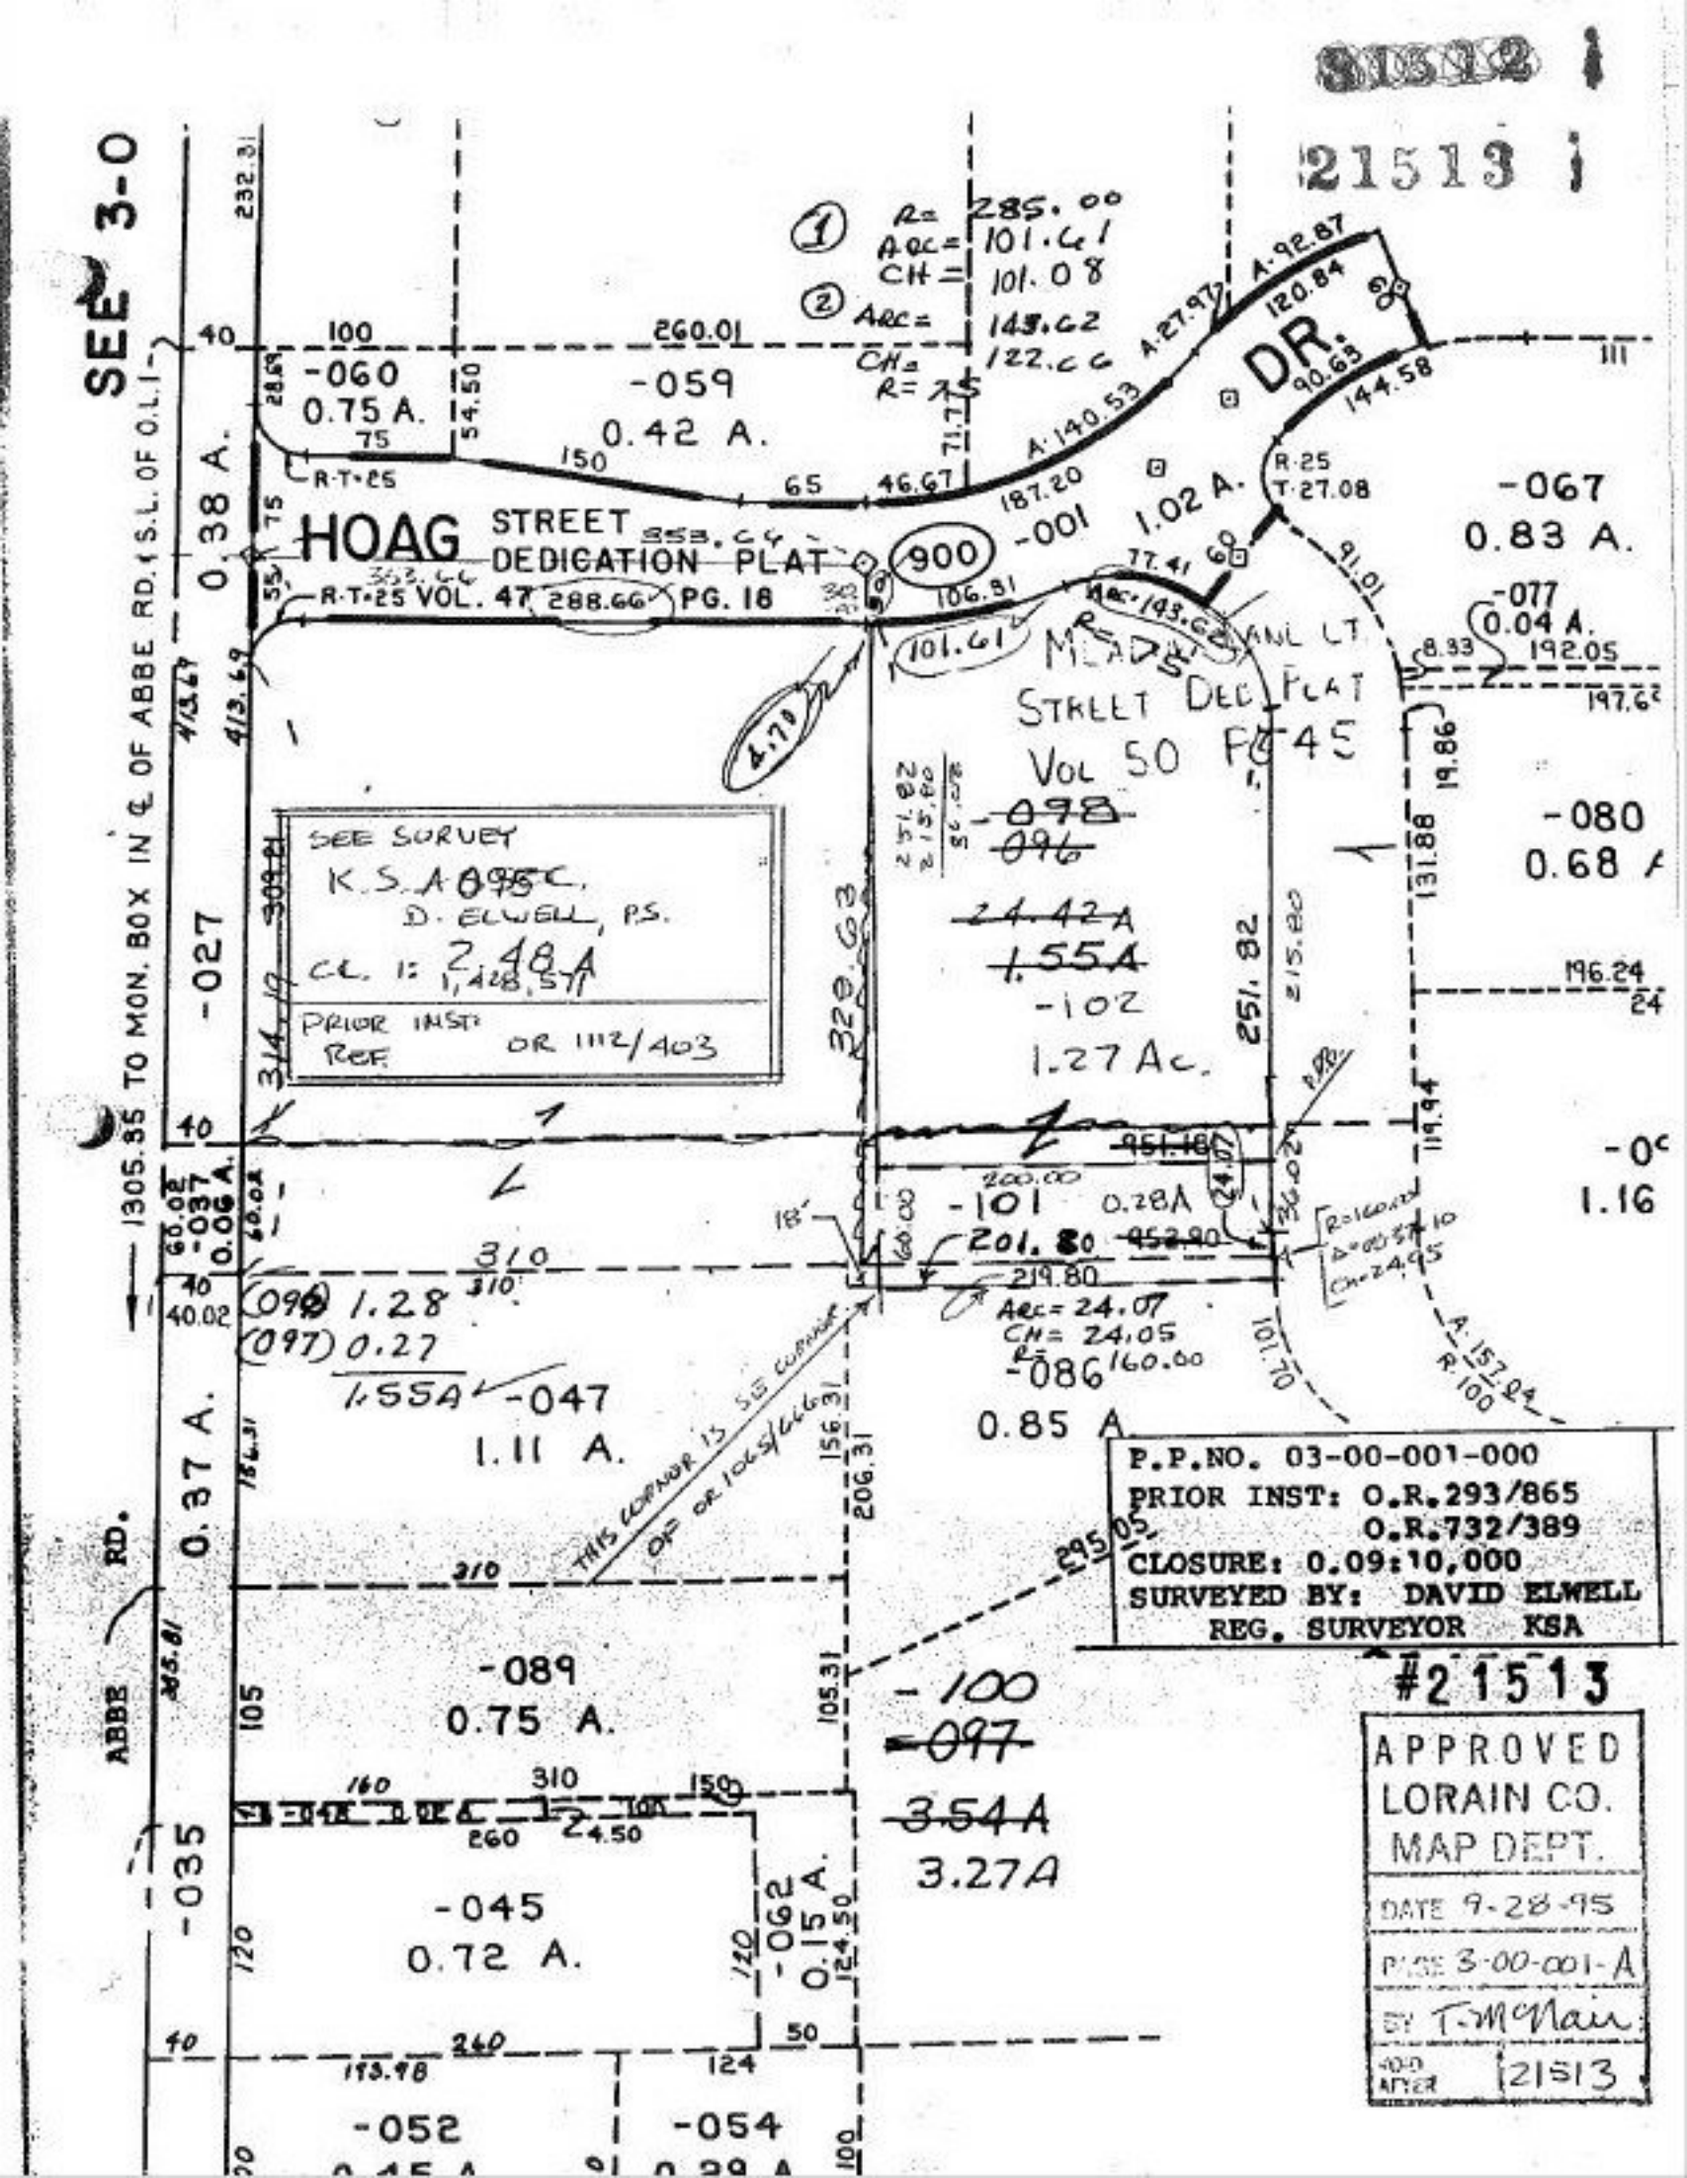

21513
SEE 3-0
HOAG STREET DEDICATION PLAT
R-T-25 VOL. 47 288.66 PG. 18
900
-001
1.02 A.
DR.
R-25 T-27.08
-060
0.75 A.
-059
0.42 A.
-067
0.83 A.
-077
0.04 A.
-080
0.68 A
-027
0.38 A.
-037
0.06 A.
-035
0.37 A.
-089
0.75 A.
-045
0.72 A.
-062
0.15 A.
-052
-054
-100
-097
3.54 A
3.27A
-086
0.85 A
-101
0.28A
-102
1.27 Ac.
-098
-096
24.42 A
1.55A
-047
1.11 A.
(098) 1.28
(097) 0.27
1.55A
SEE SURVEY
K.S.A. 095C.
D. ELWELL, P.S.
CL. 1: 2.48 A
1,428,571
PRIOR INST. REF. OR 1112/403
THIS CORNER IS SE CORNER OF OR 1065/666
1305.35 TO MON. BOX IN ℄ OF ABBE RD. (S.L. OF O.L.)
ABBE RD.
P.P.NO. 03-00-001-000
PRIOR INST: O.R.293/865
O.R.732/389
CLOSURE: 0.09:10,000
SURVEYED BY: DAVID ELWELL
REG. SURVEYOR KSA
#21513
APPROVED
LORAIN CO.
MAP DEPT.
DATE 9-28-95
PAGE 3-00-001-A
BY T. McNair
21513