21518

627/424

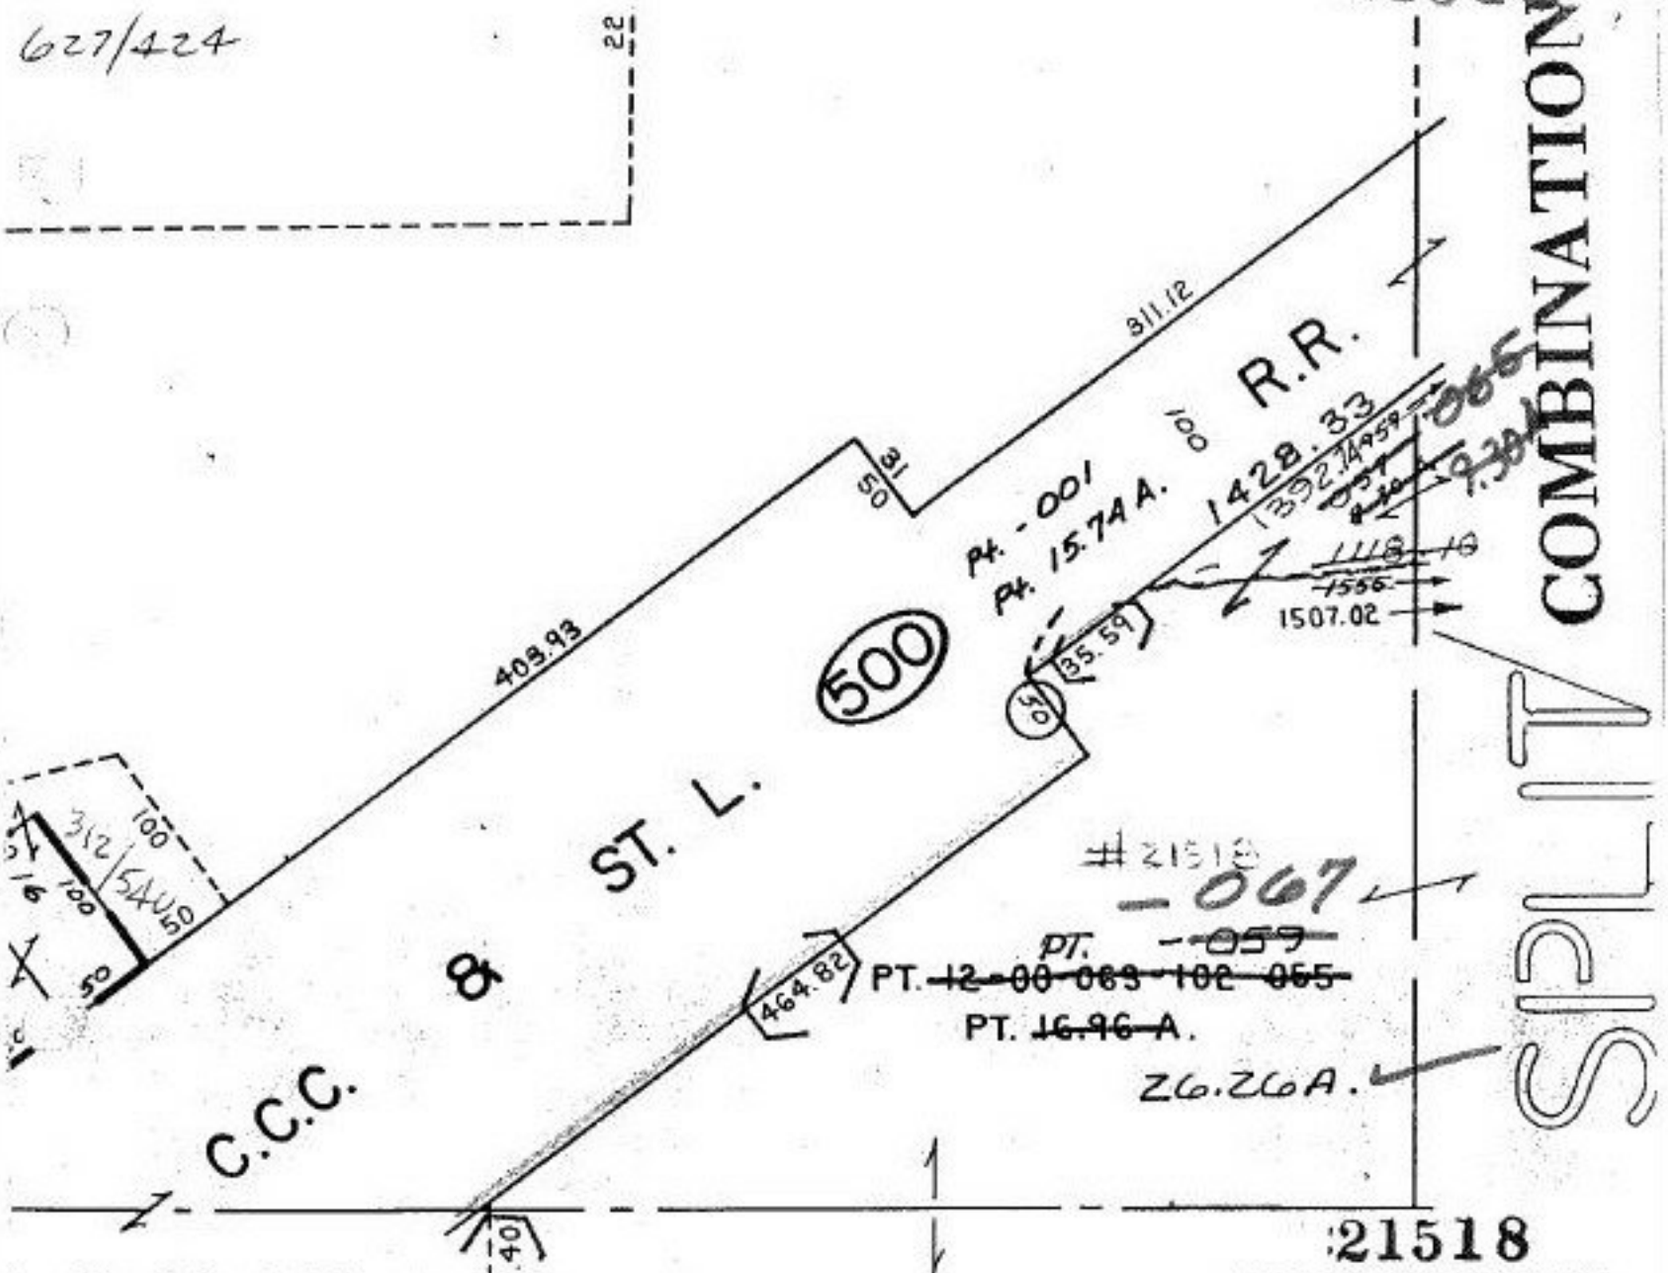

21518

12-00-063-A

P.P.NO. 12-00-062-000 12-00-063-102-
PRIOR INST: (037)O.R. 361/766 767
(055)O.R. 698/81
SPLIT CLOSURE: 9.30ac. 0.35:10,000
SURVEYED BY: RONALD D. ROBISON REG. SURVEYOR

COMB: 12-00-062-000-057 9.30ac.
12-00-063-102-055 16.96ac.
COMB. INTO: 12-00-062-000-059 26.26ac.

APPROVED LORAIN CO. MAP DEPT
DATE 10-5-95
PAGE 12-00-062A
BY CAROLYN FRANCIS
21518

100 200

COLUMBIA TWP.

SCALE 1" = 100'

CORRECTED P.P. NO MAP

12-00-062-A