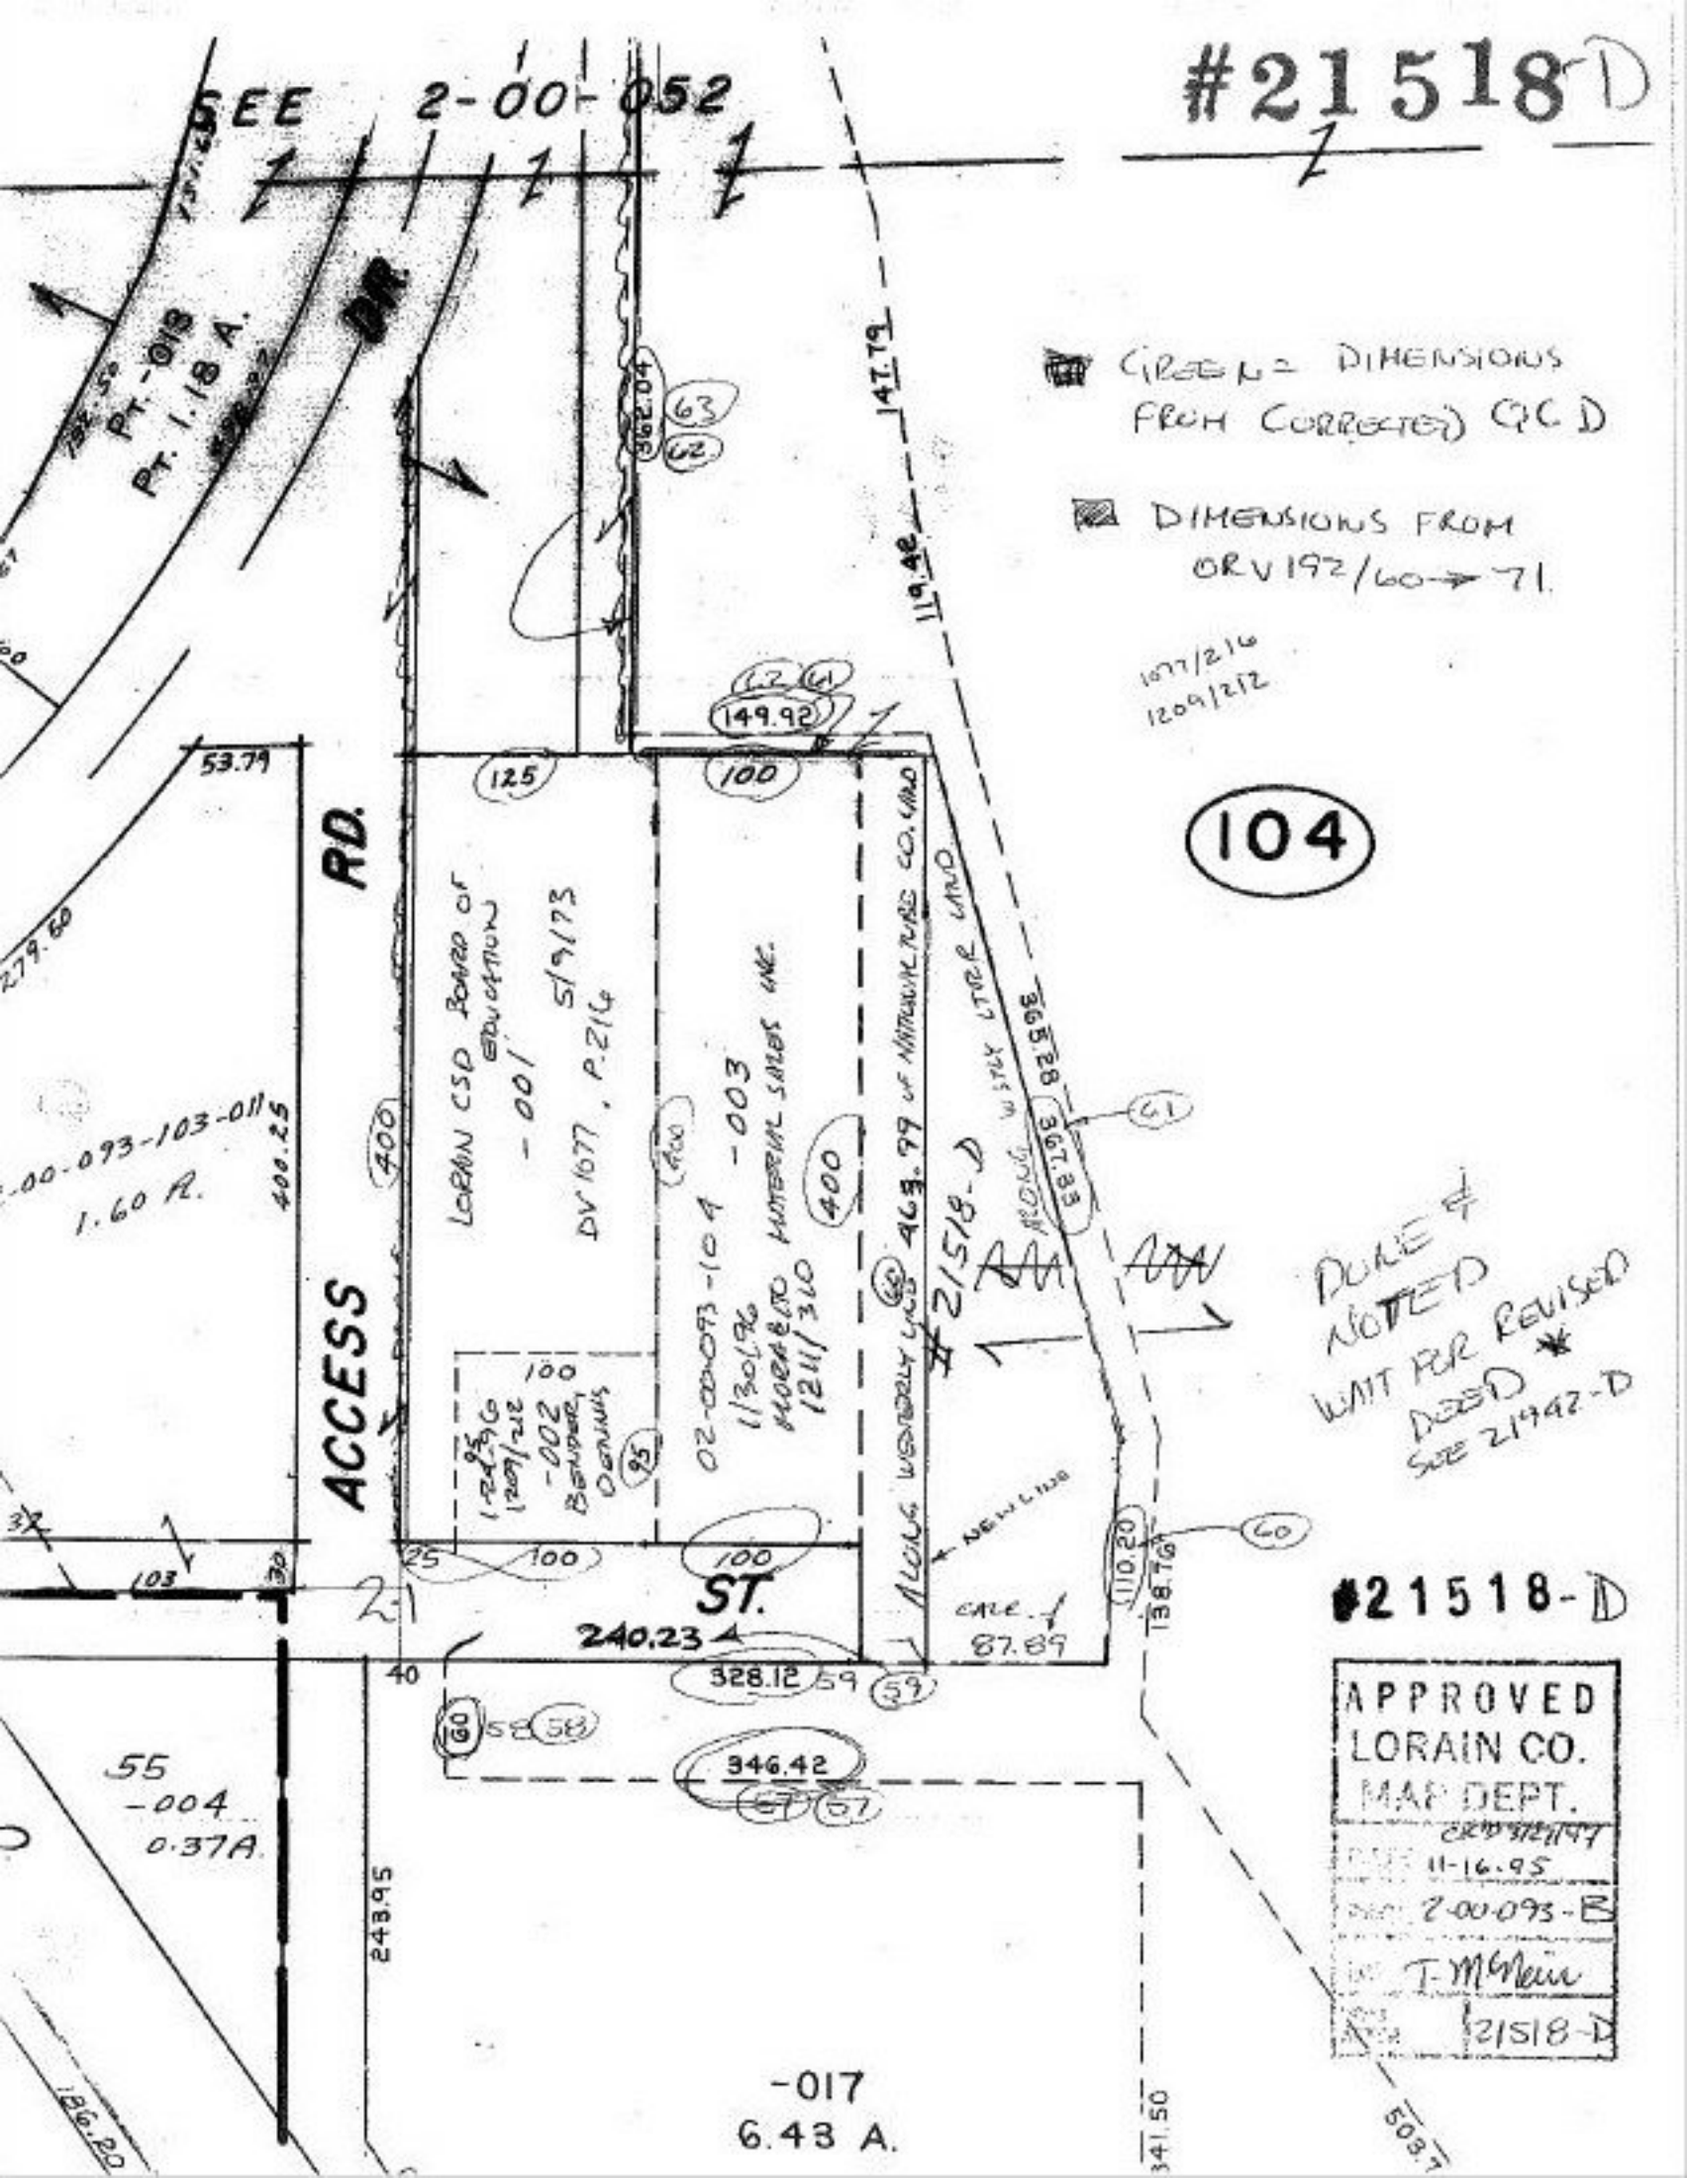
#21518-D
SEE 2-00-052
PT. -018
PT. 1.18 A.
ORR
362.04
63
62
147.79
119.48
GREEN = DIMENSIONS FROM CORRECTED QC D
DIMENSIONS FROM ORV 192/60 → 71.
1077/216
1209/212
149.92
125
100
104
53.79
RD.
279.60
00-093-103-011
1.60 A.
400.25
400
LORAIN CSD BOARD OF EDUCATION
-001
5/9/73
DV 1077, P. 216
02-00-093-104
-003
11/30/96
1211/310
463.79
#21518-D
ALONG WESTERLY LINE OF NATIONAL RES CO. LAND
C1
DUKE # NOTED WAIT FOR REVISED DEED * SEE 21942-D
ACCESS
1.24 AC
1209/212
-002
BERNARD DENNIS
95
100
25
103
30
ST.
240.23
NEW LINE
CALC. 87.89
110.20
138.76
C0
#21518-D
APPROVED
LORAIN CO.
MAP DEPT.
11-16-95
2-00-093-B
T. McNeil
21518-D
40
328.12
59
60
58
346.42
67
55
-004
0.37A.
243.95
-017
6.43 A.
341.50
509.7
126.20