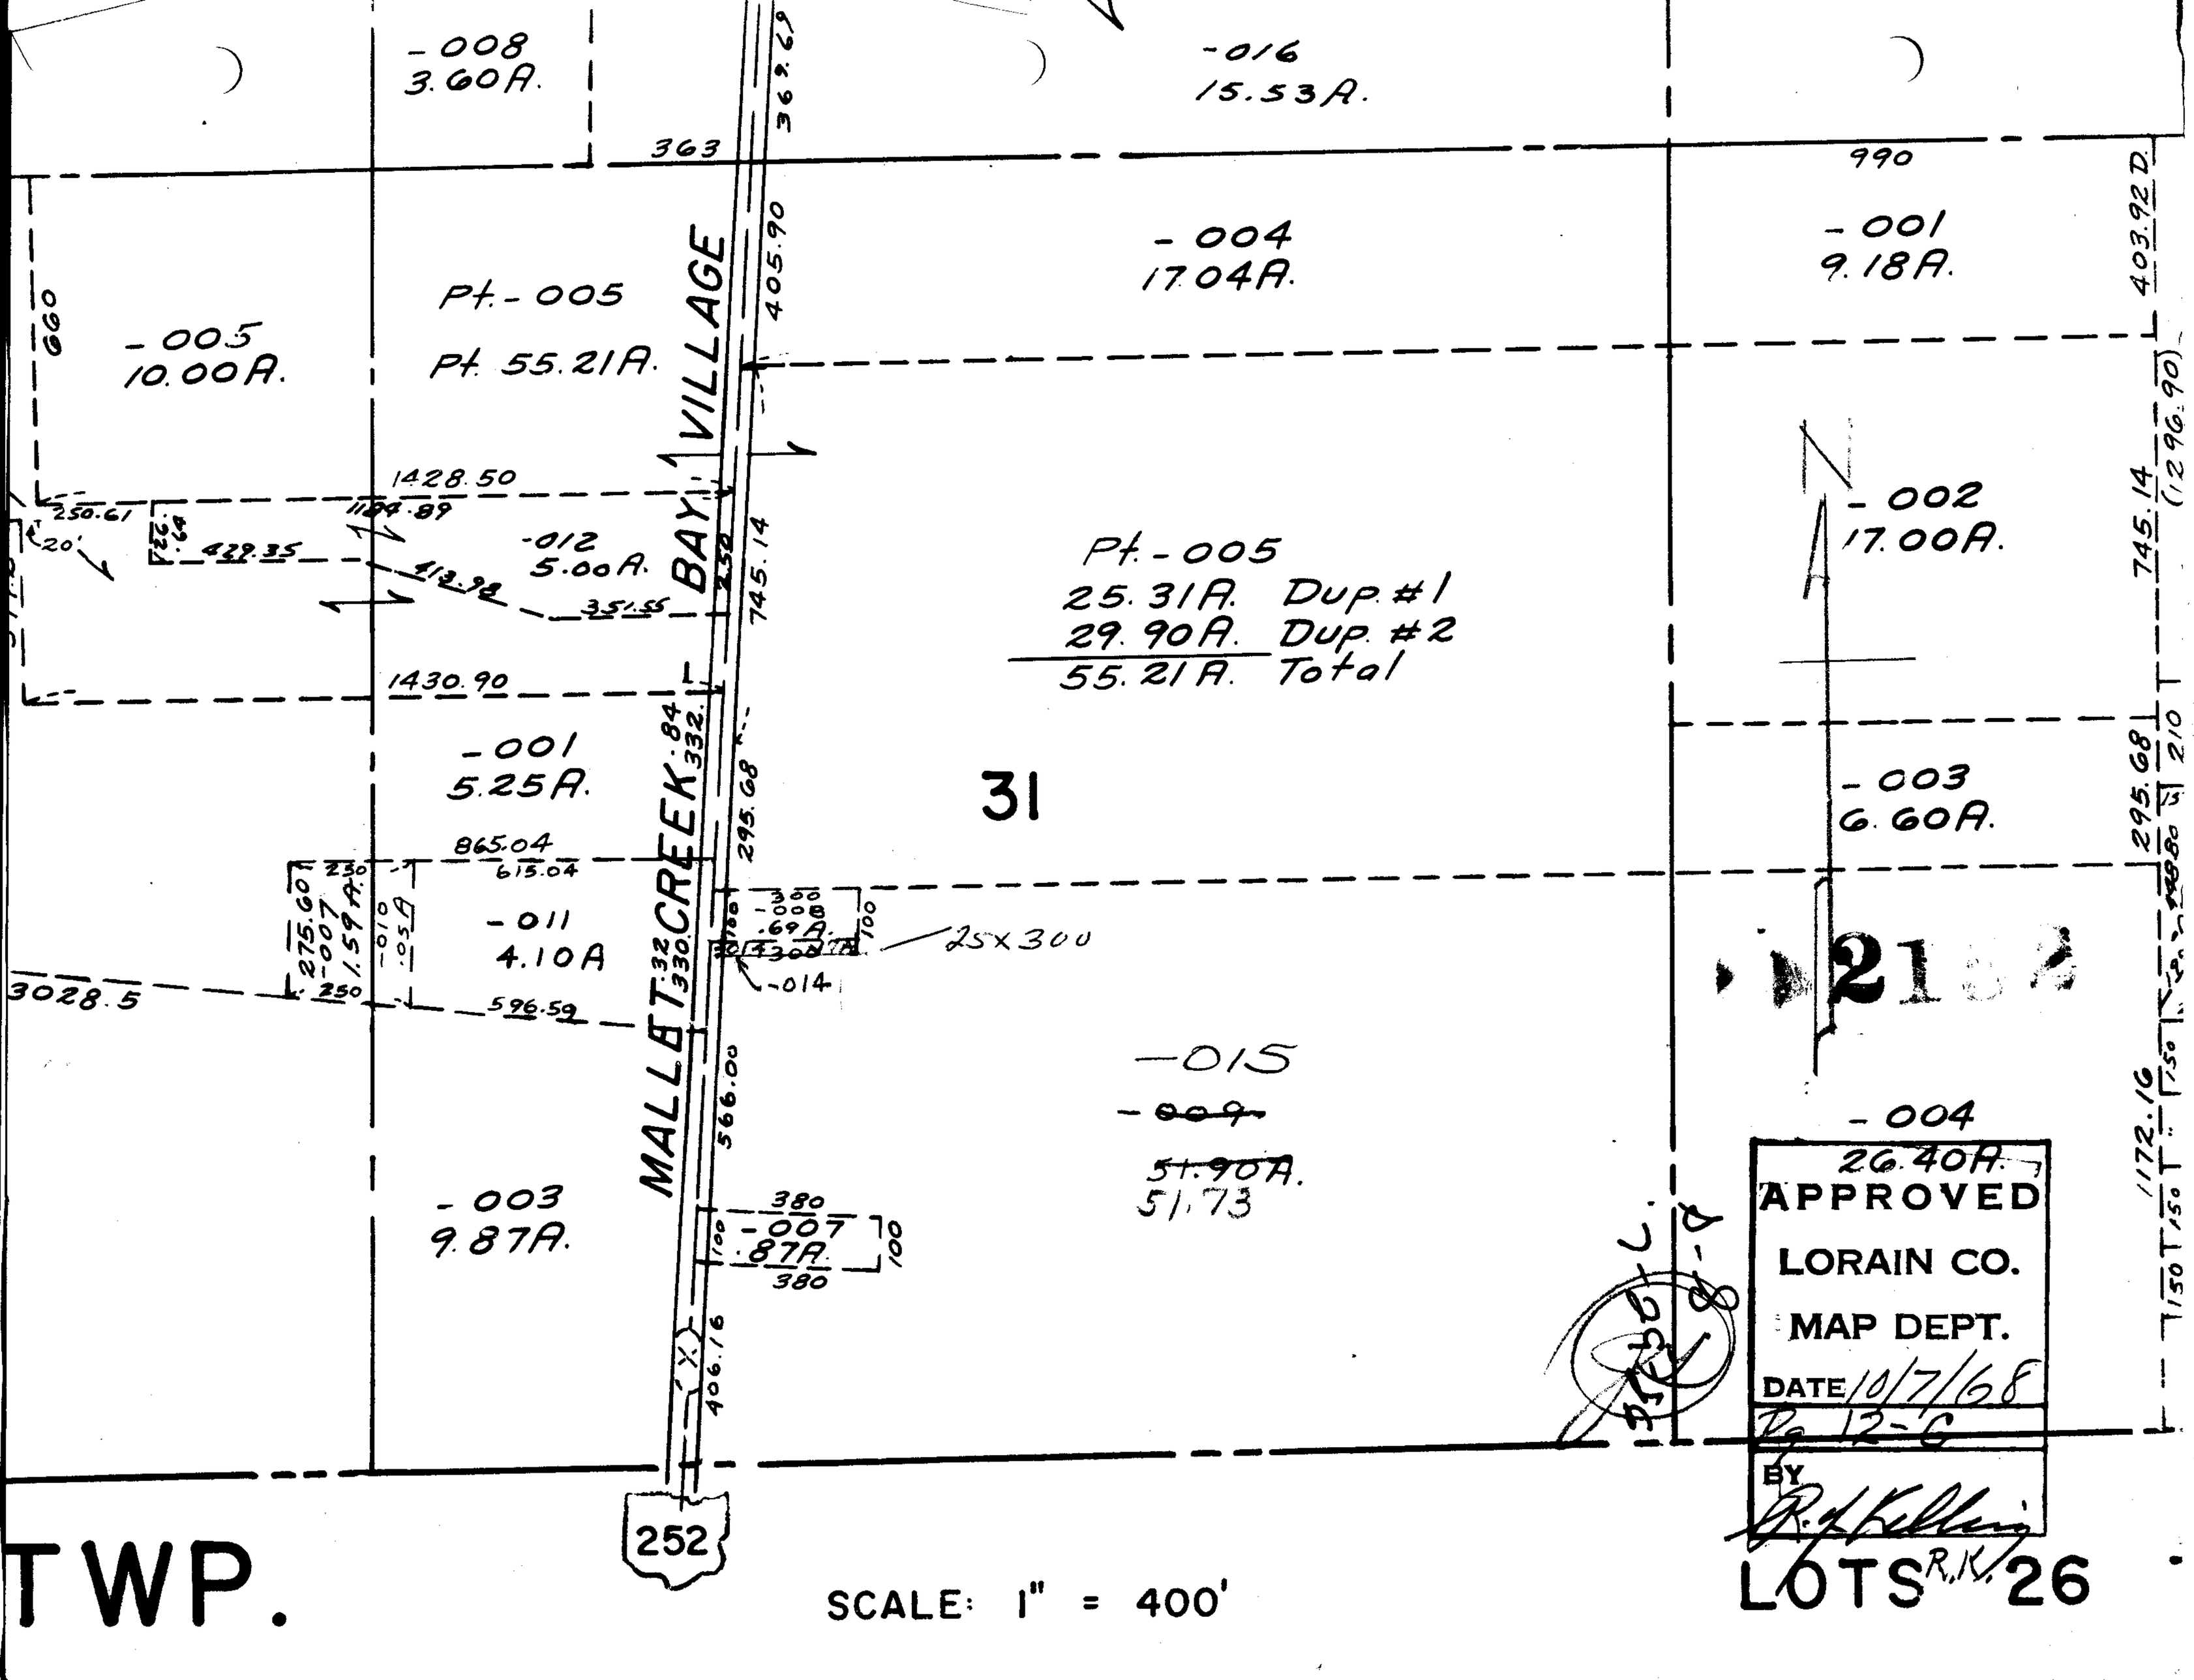

-008
3.60A.
-016
15.53A.
363
369.69
990
-004
17.04A.
-001
9.18A.
403.92 D.
-005
10.00A.
Pt.-005
Pt. 55.21A.
405.90
BAY VILLAGE
1428.50
250.61
429.35
413.98
351.55
-012
5.00A.
745.14
Pt.-005
25.31A. Dup. #1
29.90A. Dup. #2
55.21A. Total
-002
17.00A.
745.14
(1296.90)
1430.90
-001
5.25A.
MALLET CREEK
332.84
295.68
31
-003
6.60A.
295.68
210
865.04
615.04
-011
4.10A
-300
-008
.69A.
25x300
-014
3028.5
596.59
566.00
-015
-009
51.90A.
51.73
-004
26.40A.
1172.16
-003
9.87A.
380
-007
.87A.
380
406.16
252
APPROVED
LORAIN CO.
MAP DEPT.
DATE 10/7/68
Pg. 12-C
BY
R.K.
TWP.
SCALE: 1" = 400'
LOTS 26