21520
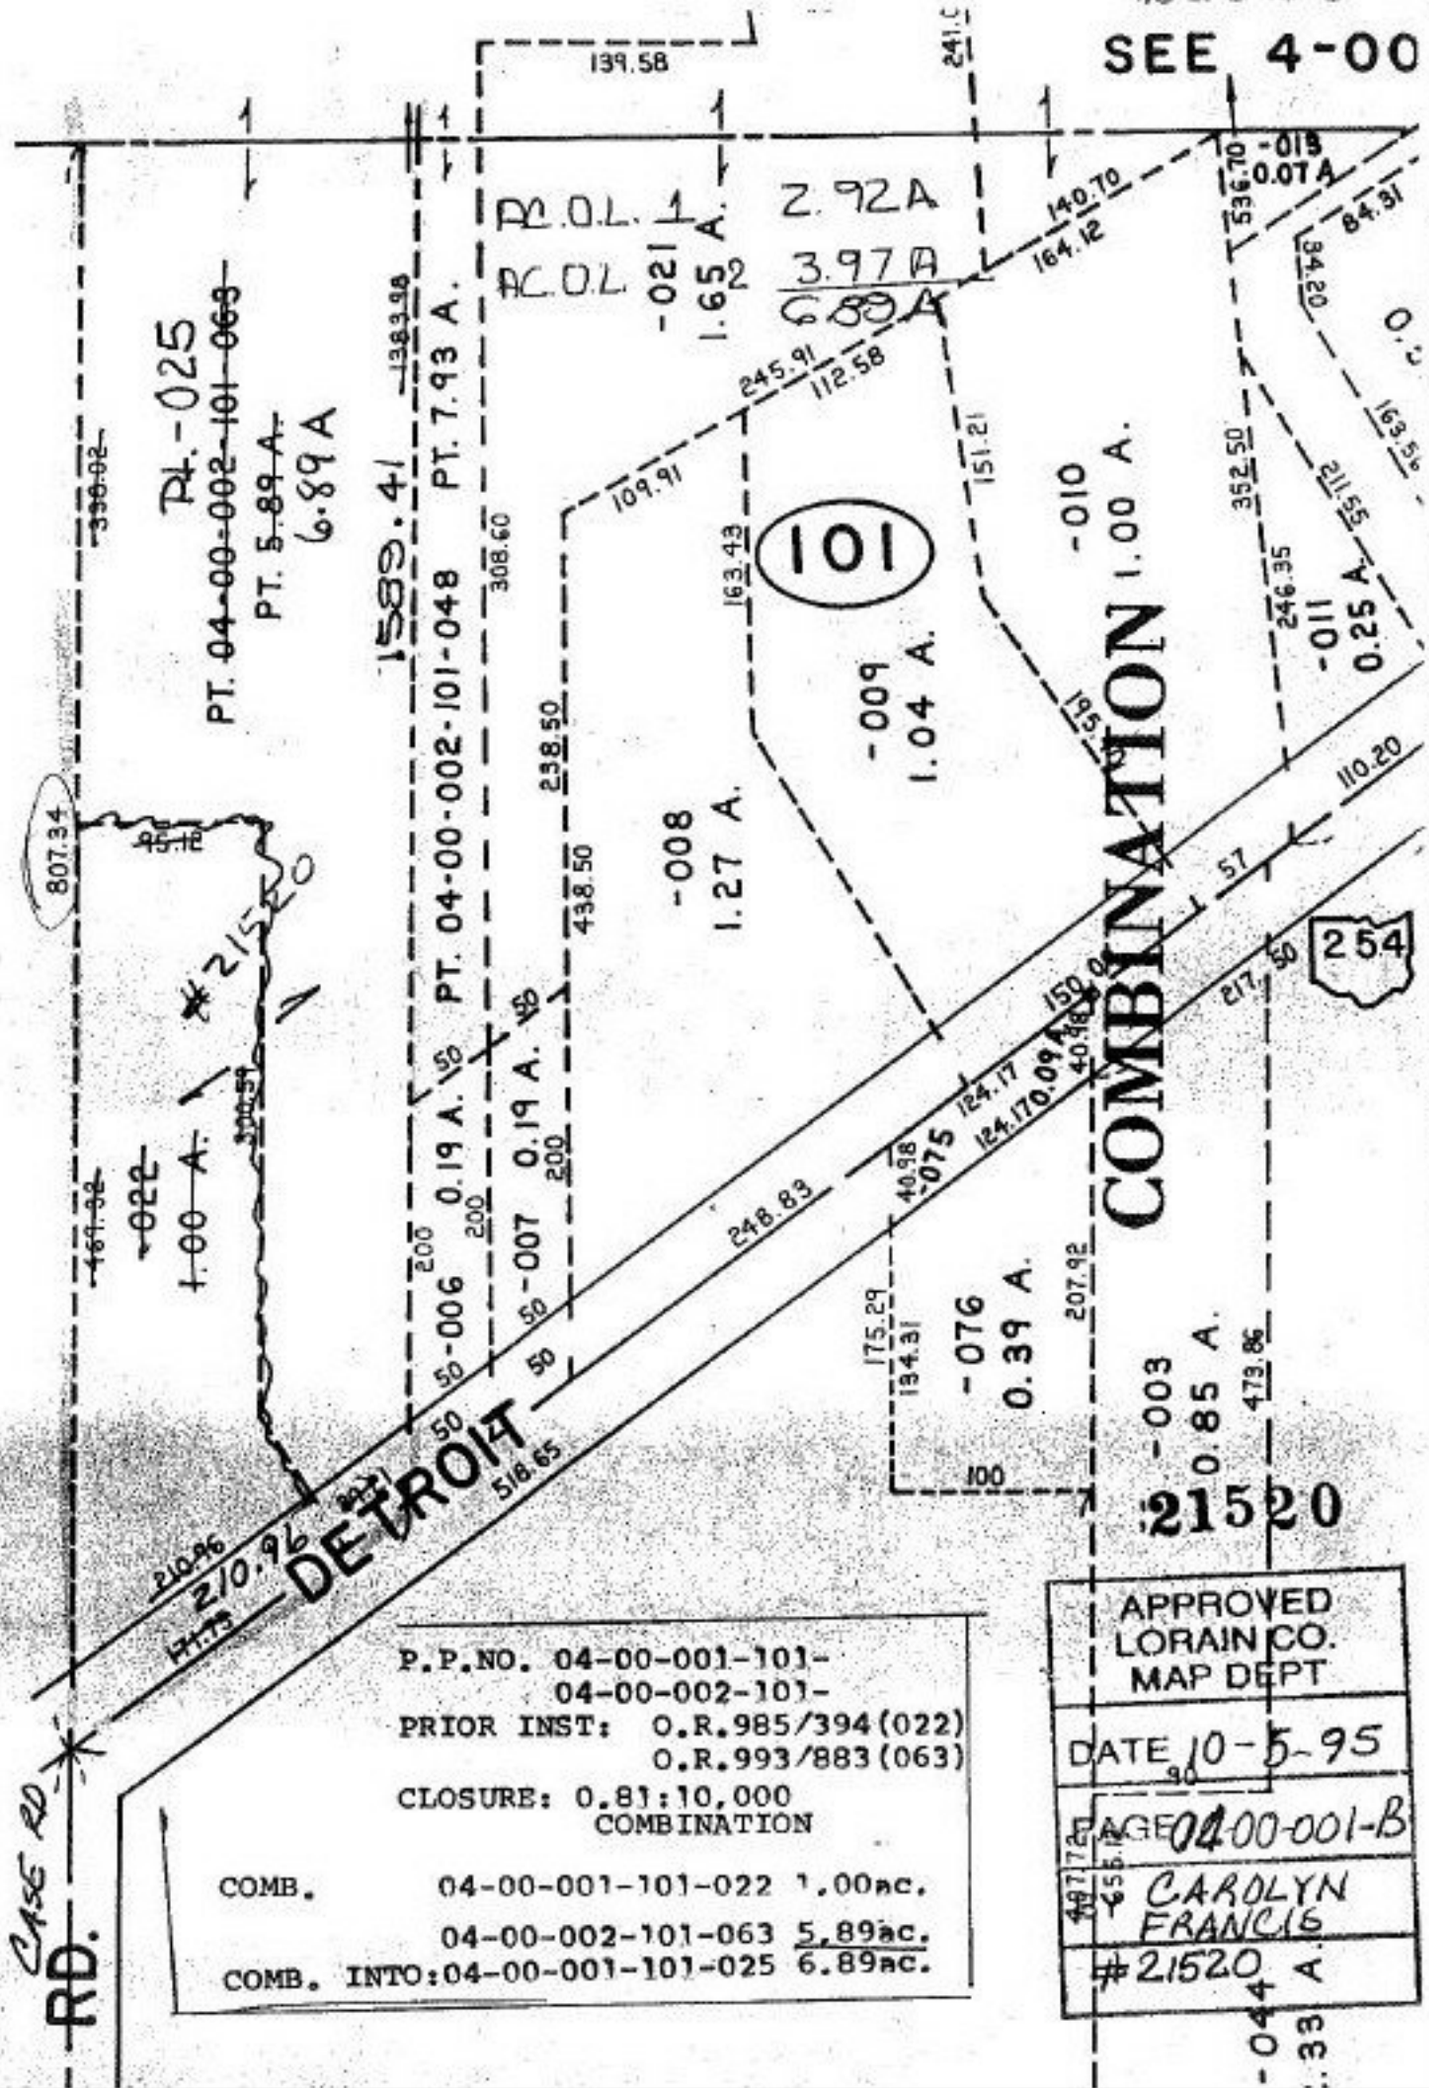
SEE 4-00