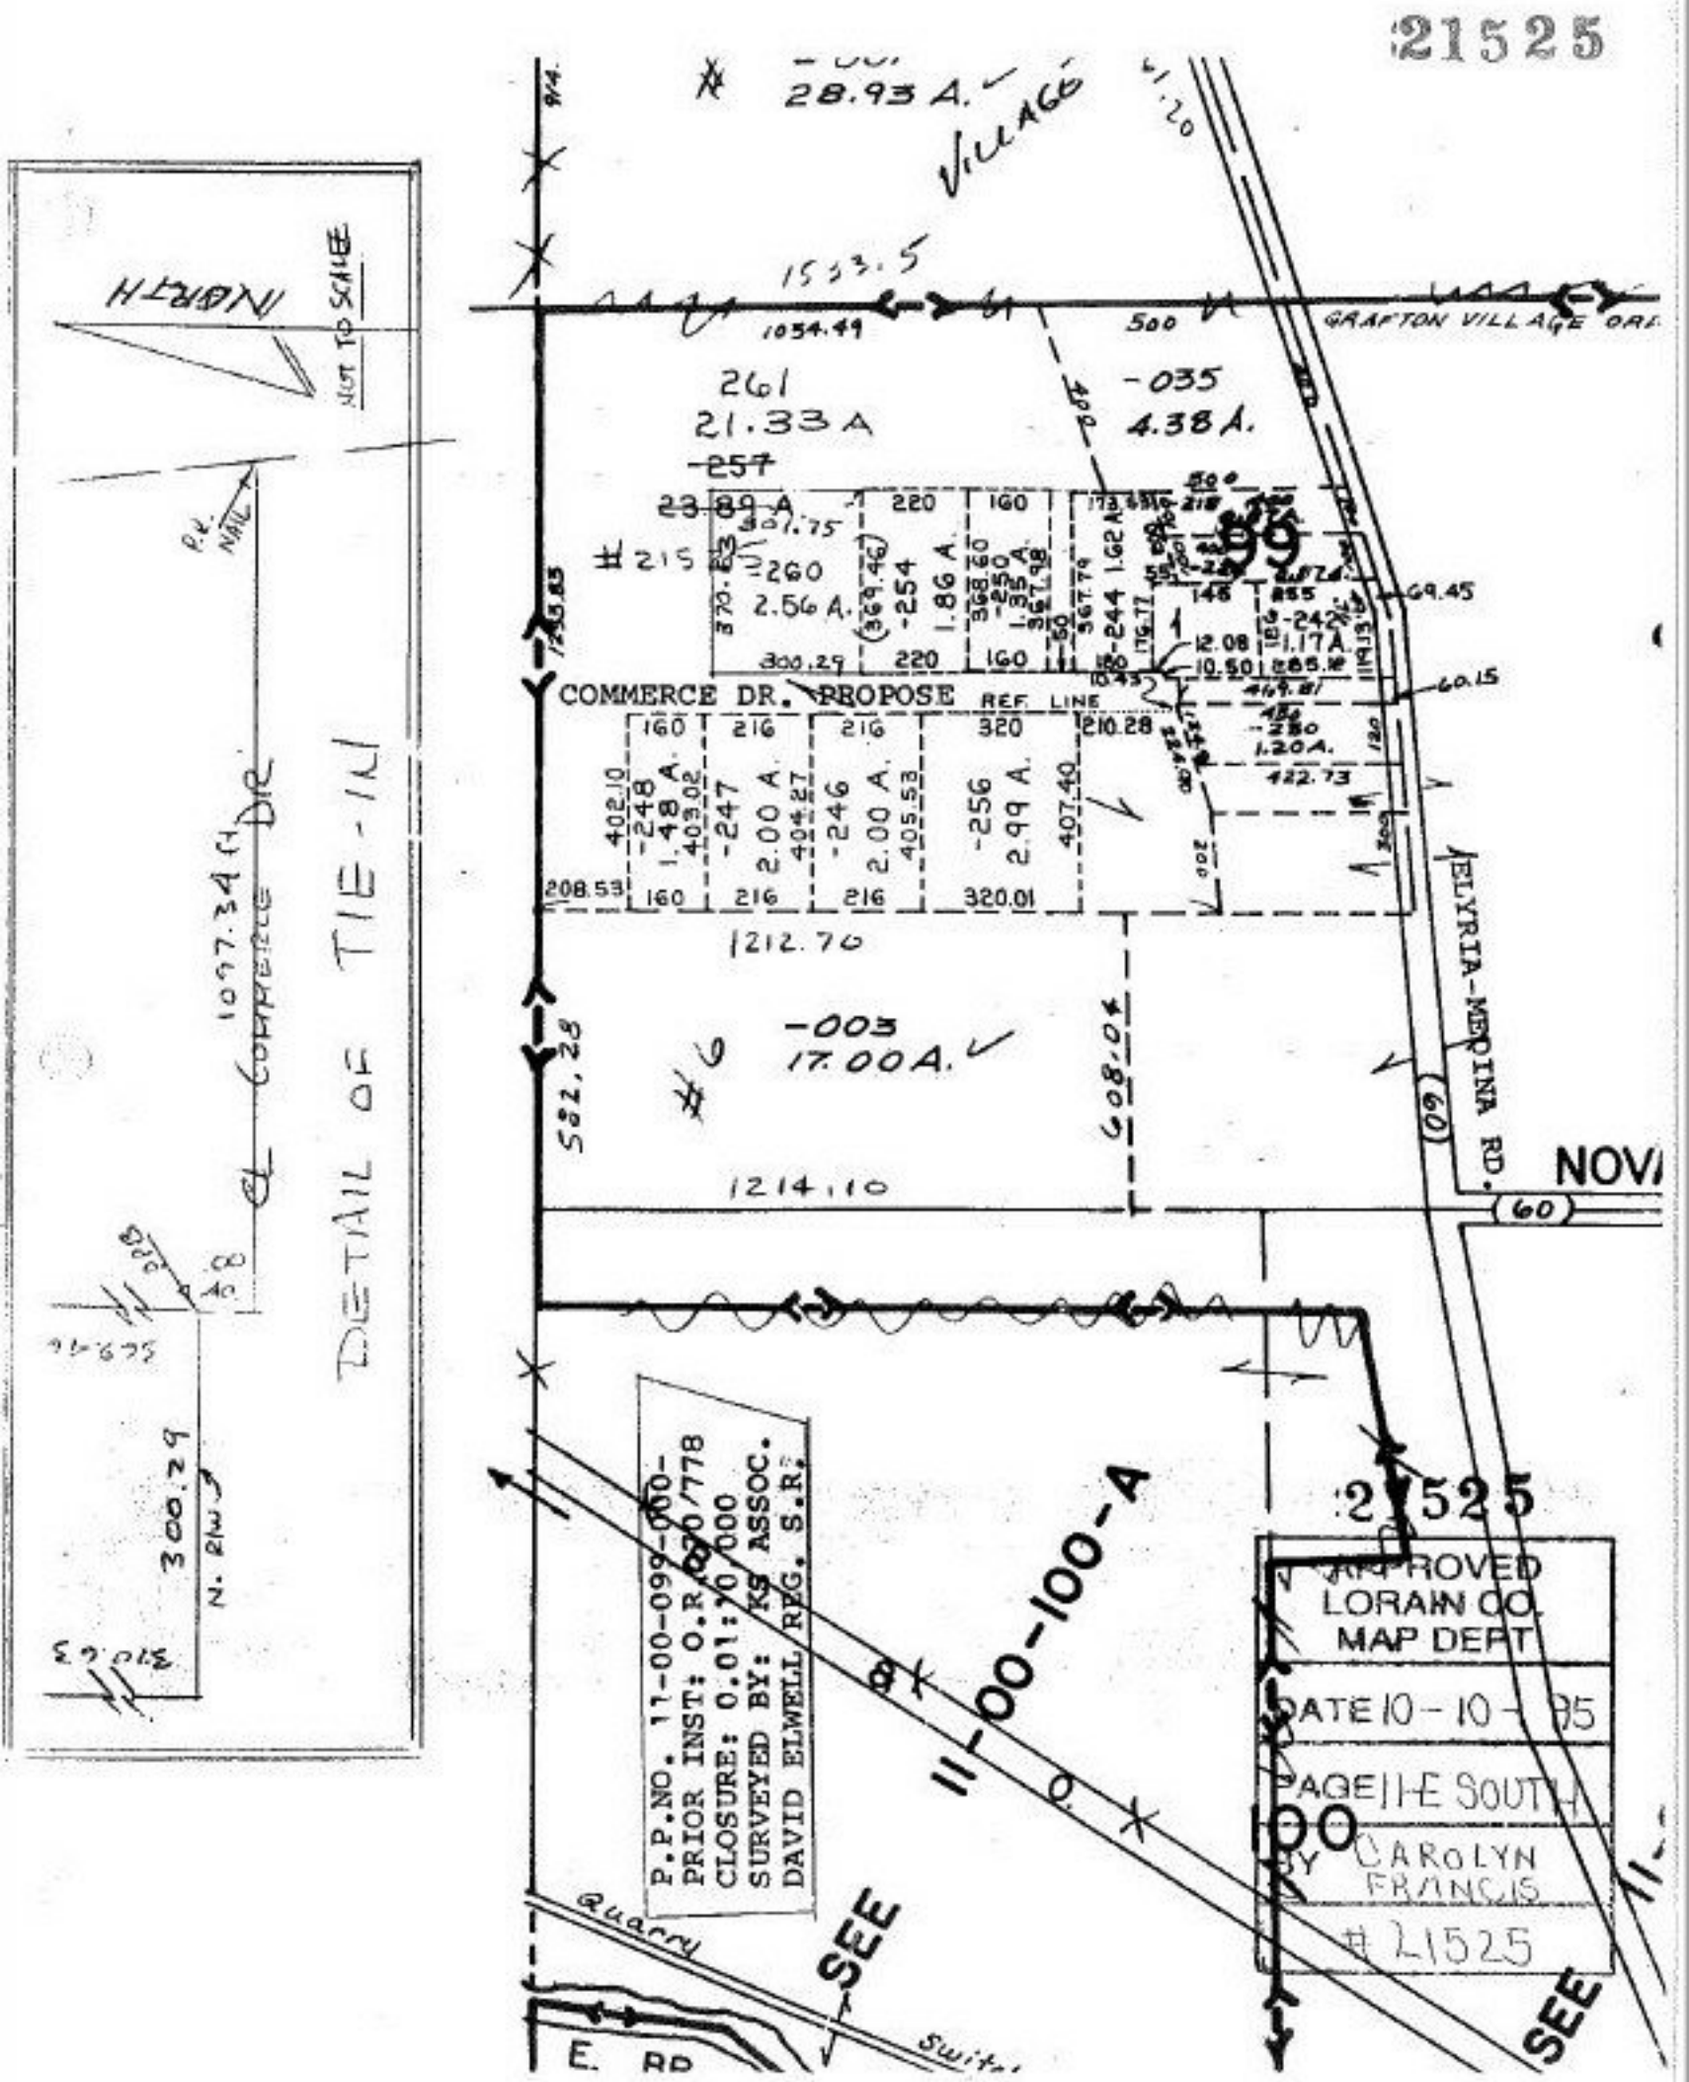
21525
28.93 A.
VILLAGE
1533.5
1054.49
500
GRAFTON VILLAGE ORD
261
21.33 A
-035
4.38 A.
-257
23.89 A
#215
-260
2.56 A.
-254
1.86 A.
-244
1.62 A.
-242
1.17 A.
COMMERCE DR. PROPOSE
REF. LINE
-248
1.48 A.
-247
2.00 A.
-246
2.00 A.
-256
2.99 A.
1212.70
-003
17.00 A.
#6
608.04
582.28
1214.10
ELYRIA-MEDINA RD.
NOV
60
P.P.NO. 11-00-099-000-
PRIOR INST: O.R. 070/778
CLOSURE: 0.01:10 000
SURVEYED BY: KS ASSOC.
DAVID ELWELL REG. S.R.
11-00-100-A
21525
APPROVED
LORAIN CO.
MAP DEPT
DATE 10-10-95
PAGE 11-E SOUTH
BY CAROLYN FRANCIS
#21525
Quarry
SEE
E. RD
NORTH
NOT TO SCALE
P.K. NAIL
1097.34 ft
COMMERCE DR
DETAIL OF TIE-IN
300.29
N. R/W
310.63