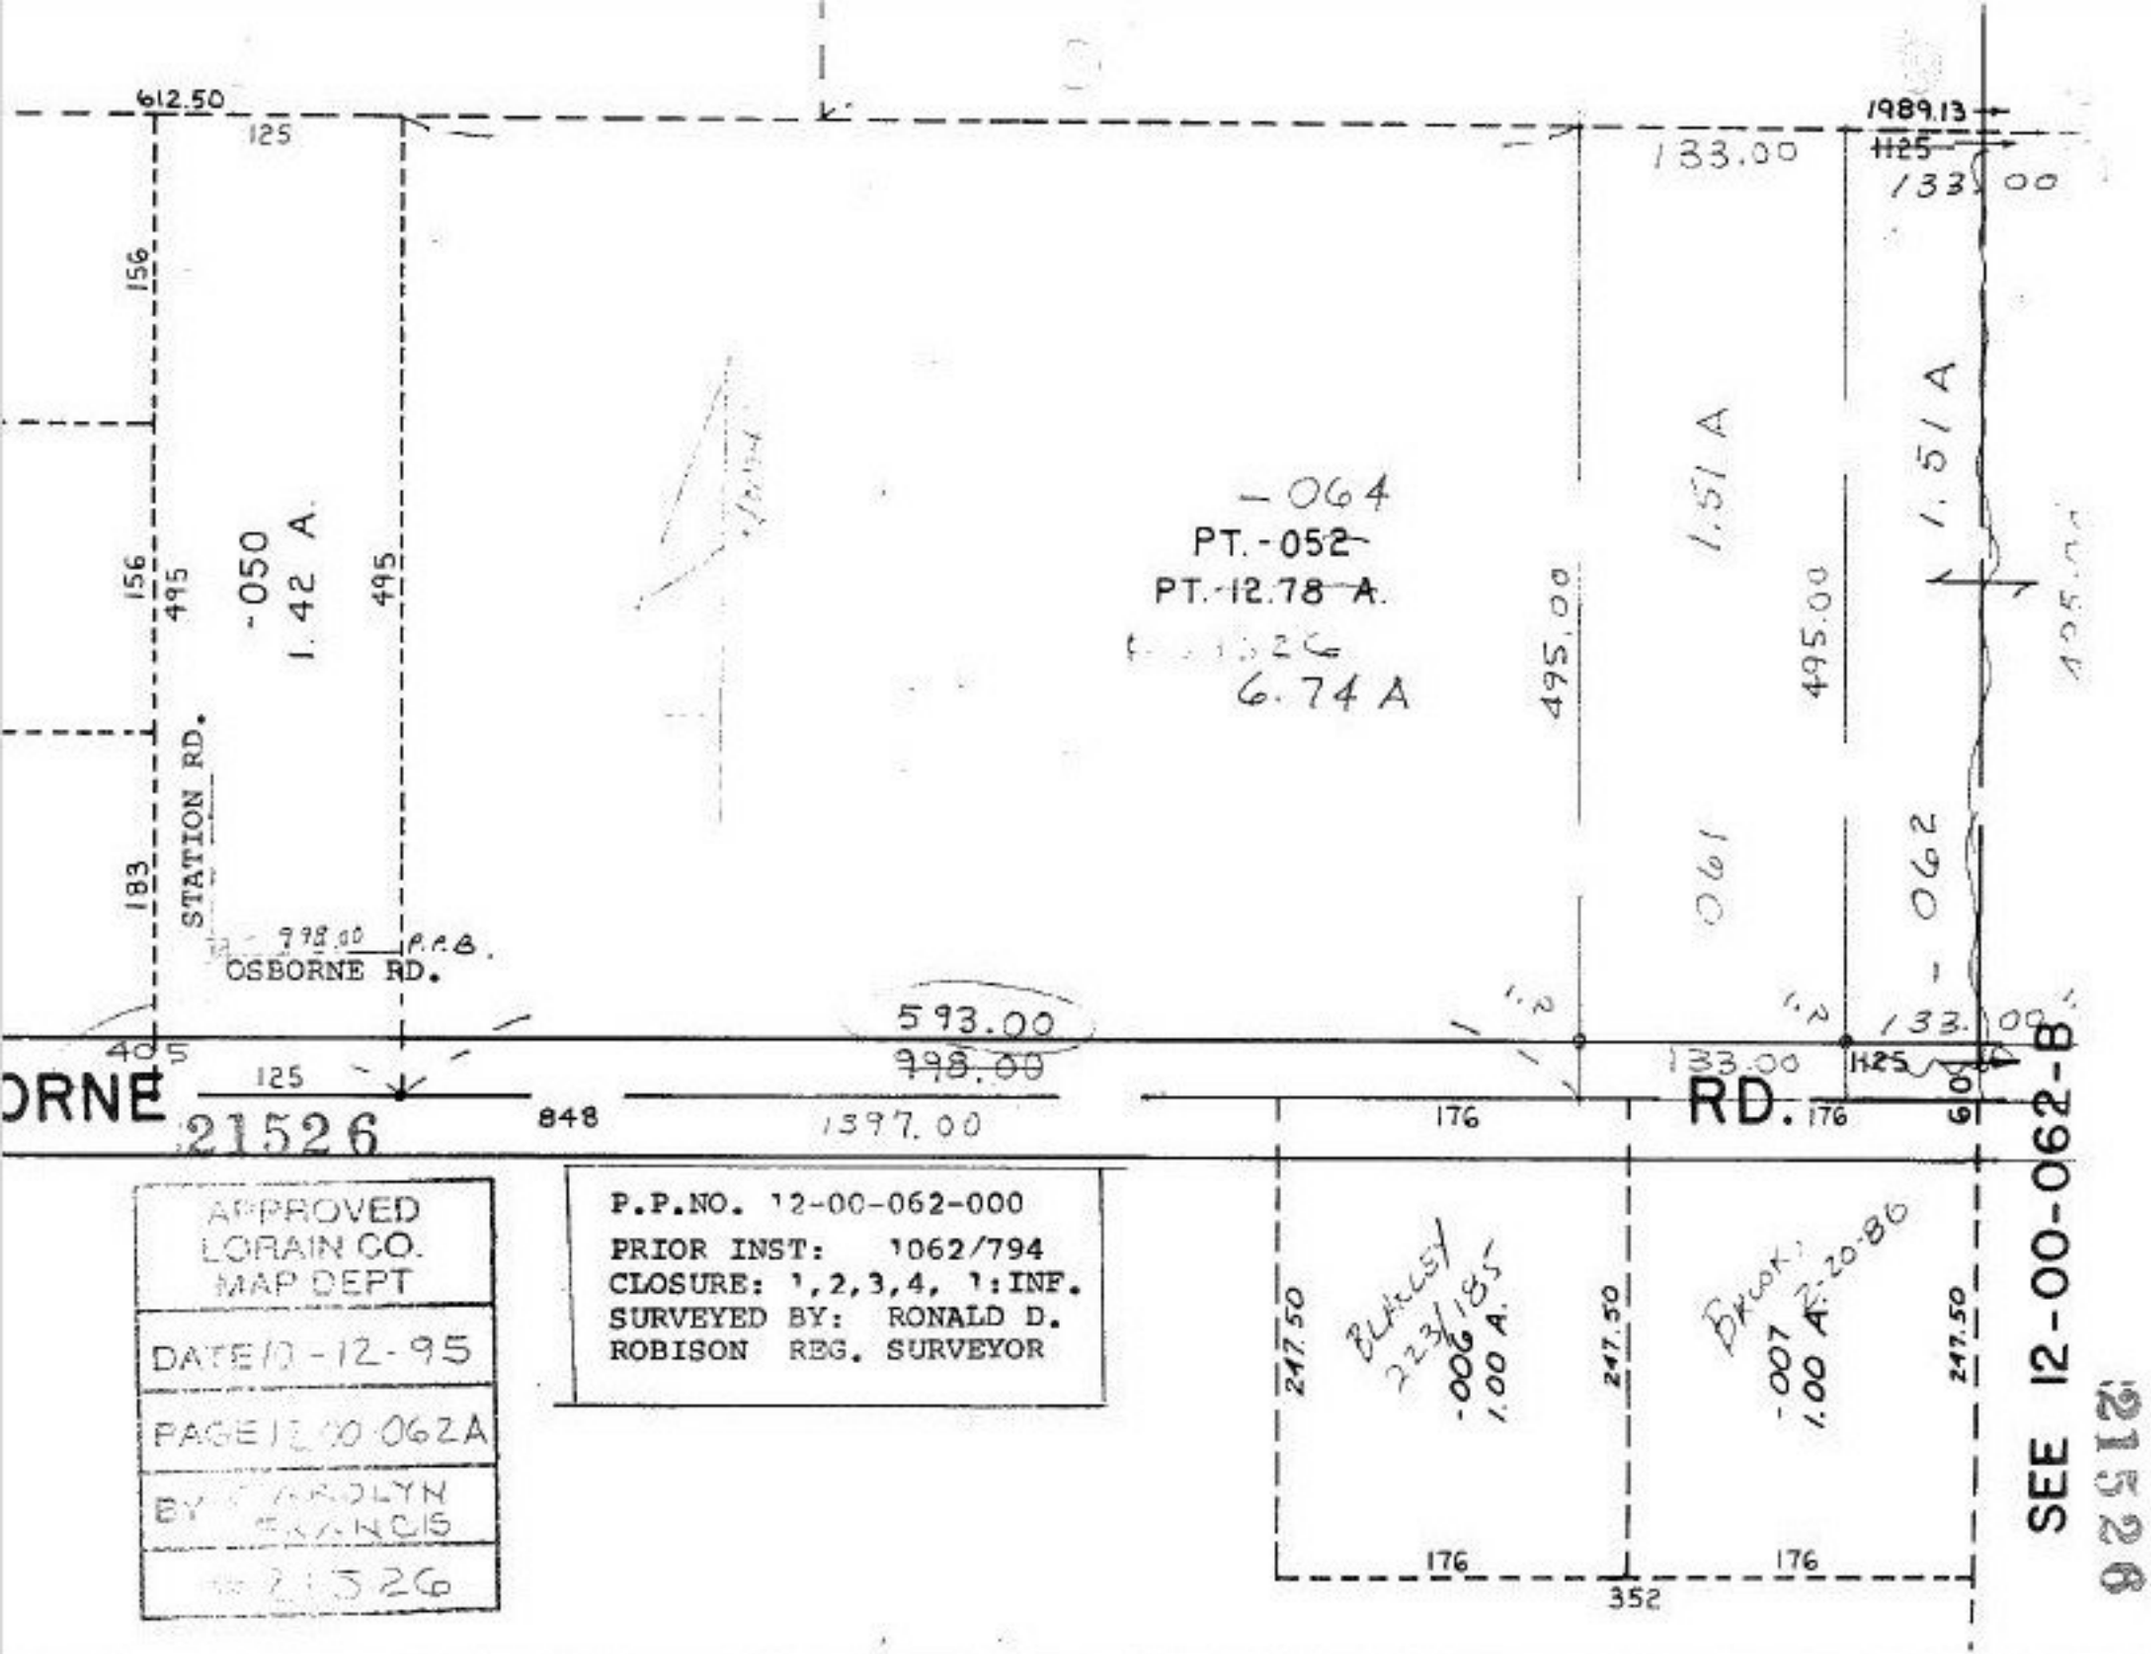

APPROVED
LORAIN CO.
MAP DEPT

DATE 10-12-95

PAGE 12-00-062A

BY CAROLYN FRANCIS

21526

P.P.NO. 12-00-062-000
PRIOR INST: 1062/794
CLOSURE: 1,2,3,4, 1:INF.
SURVEYED BY: RONALD D. ROBISON REG. SURVEYOR