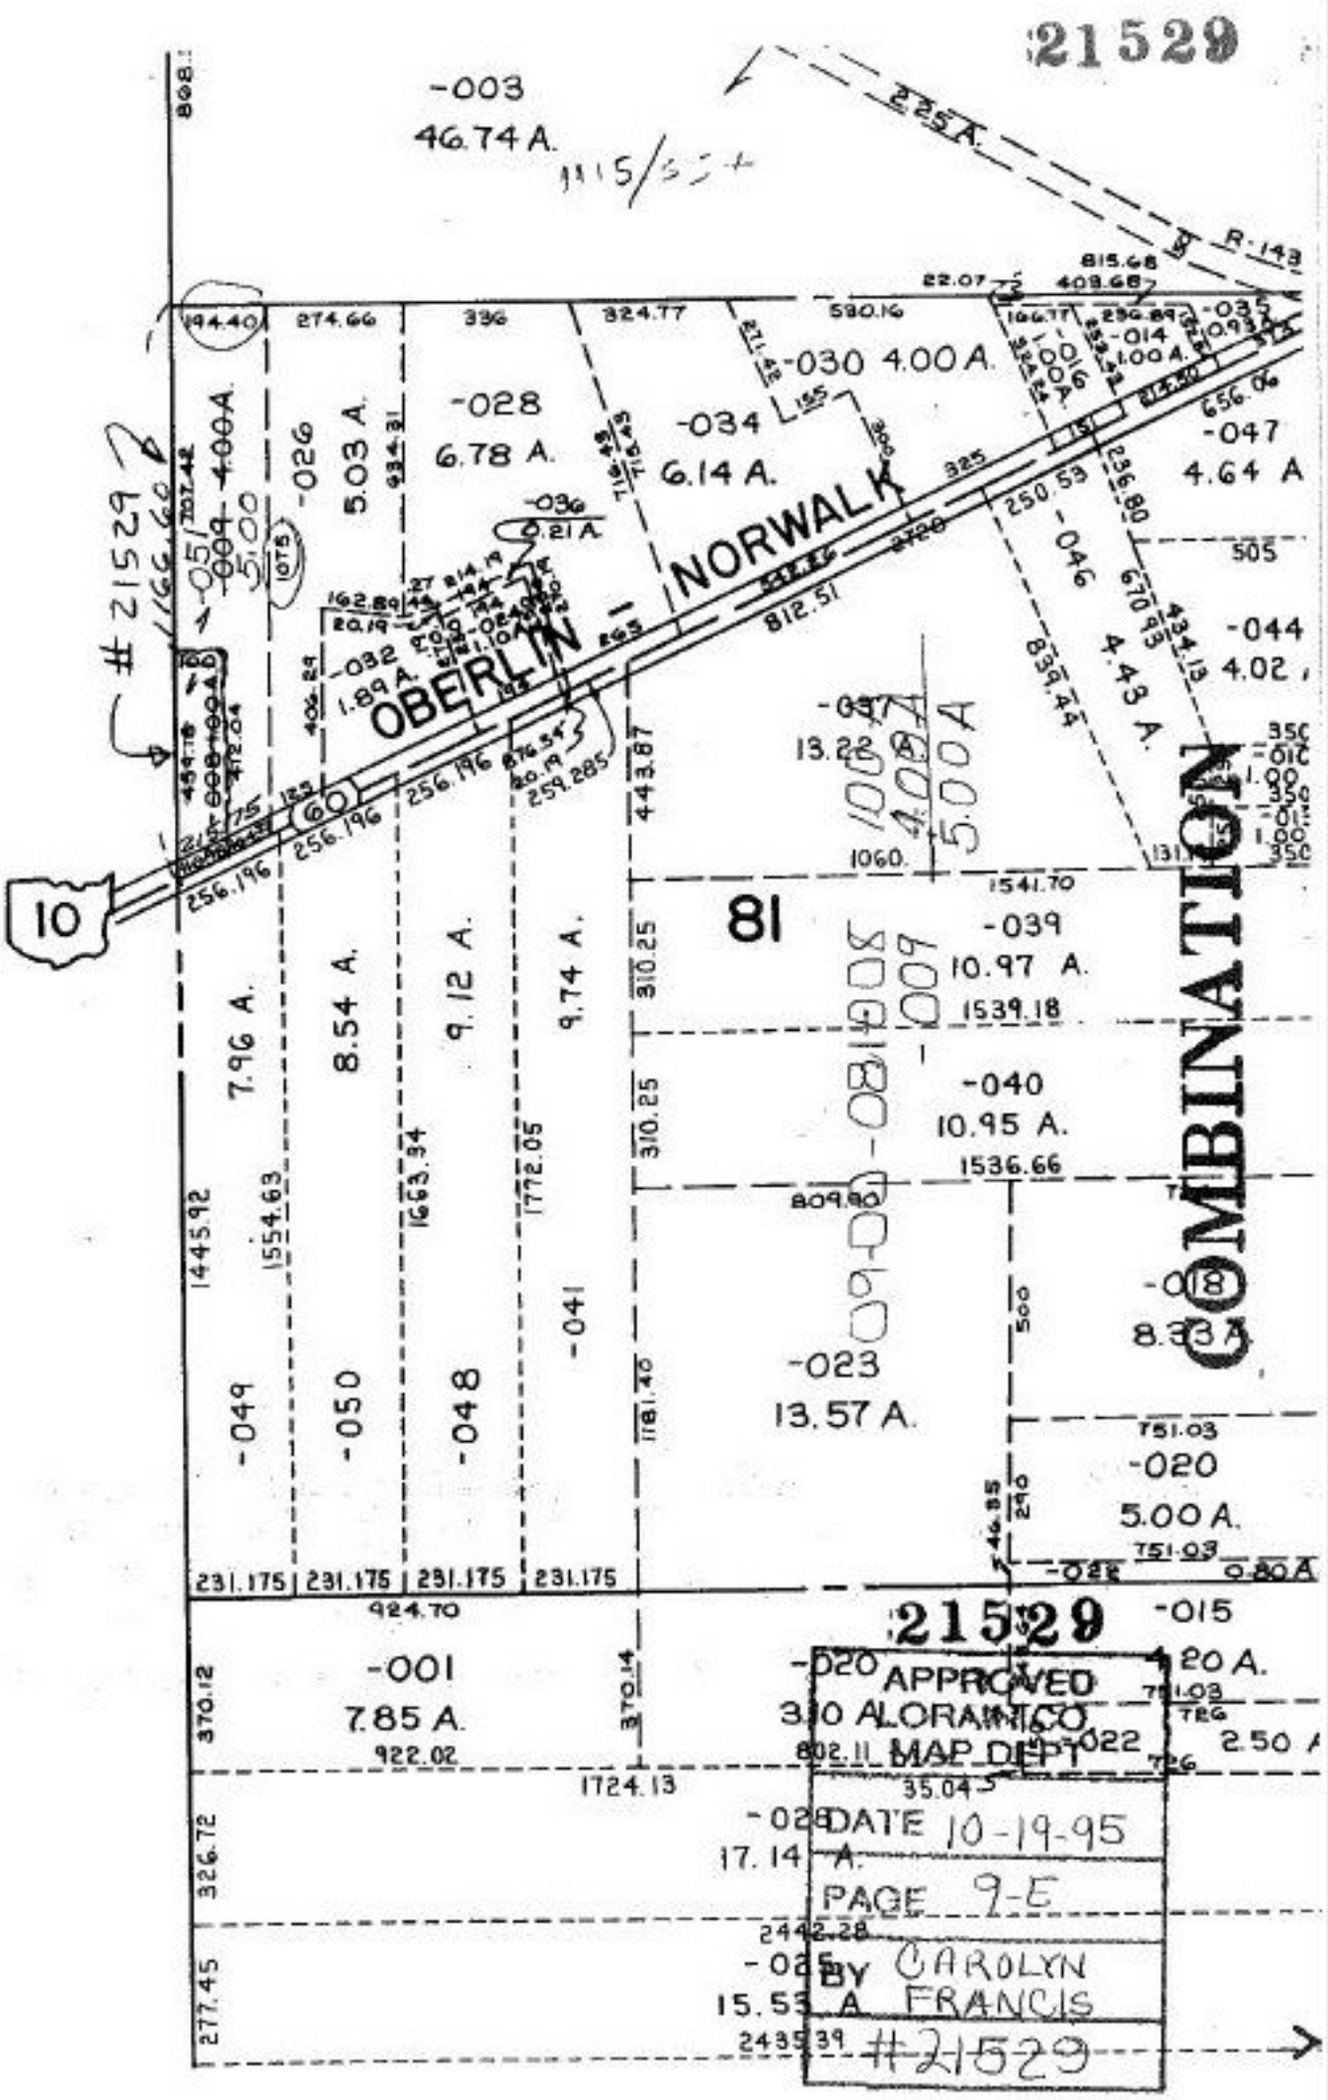
21529
-003
46.74 A.
225 A.
R-148
815.68
408.68
22.07
-030 4.00 A.
-028
6.78 A.
-034
6.14 A.
-035
0.93 A.
-014
1.00 A.
-016
1.00 A.
-047
4.64 A
-046
4.43 A.
-044
4.02
-026
5.03 A.
-027
13.22 A.
-039
10.97 A.
-040
10.95 A.
-023
13.57 A.
-049
7.96 A.
-050
8.54 A.
-048
9.12 A.
-041
9.74 A.
-001
7.85 A.
-020
5.00 A.
-015
20 A.
-022
2.50 A
-025
15.53 A
-018
8.83 A
-032
1.89 A
-036
0.21 A
#21529
OBERLIN
NORWALK
COMBINATION
81
10
APPROVED
330 ALORAM CO
MAP DEPT
DATE 10-19-95
PAGE 9-E
BY CAROLYN A FRANCIS
#21529