21530

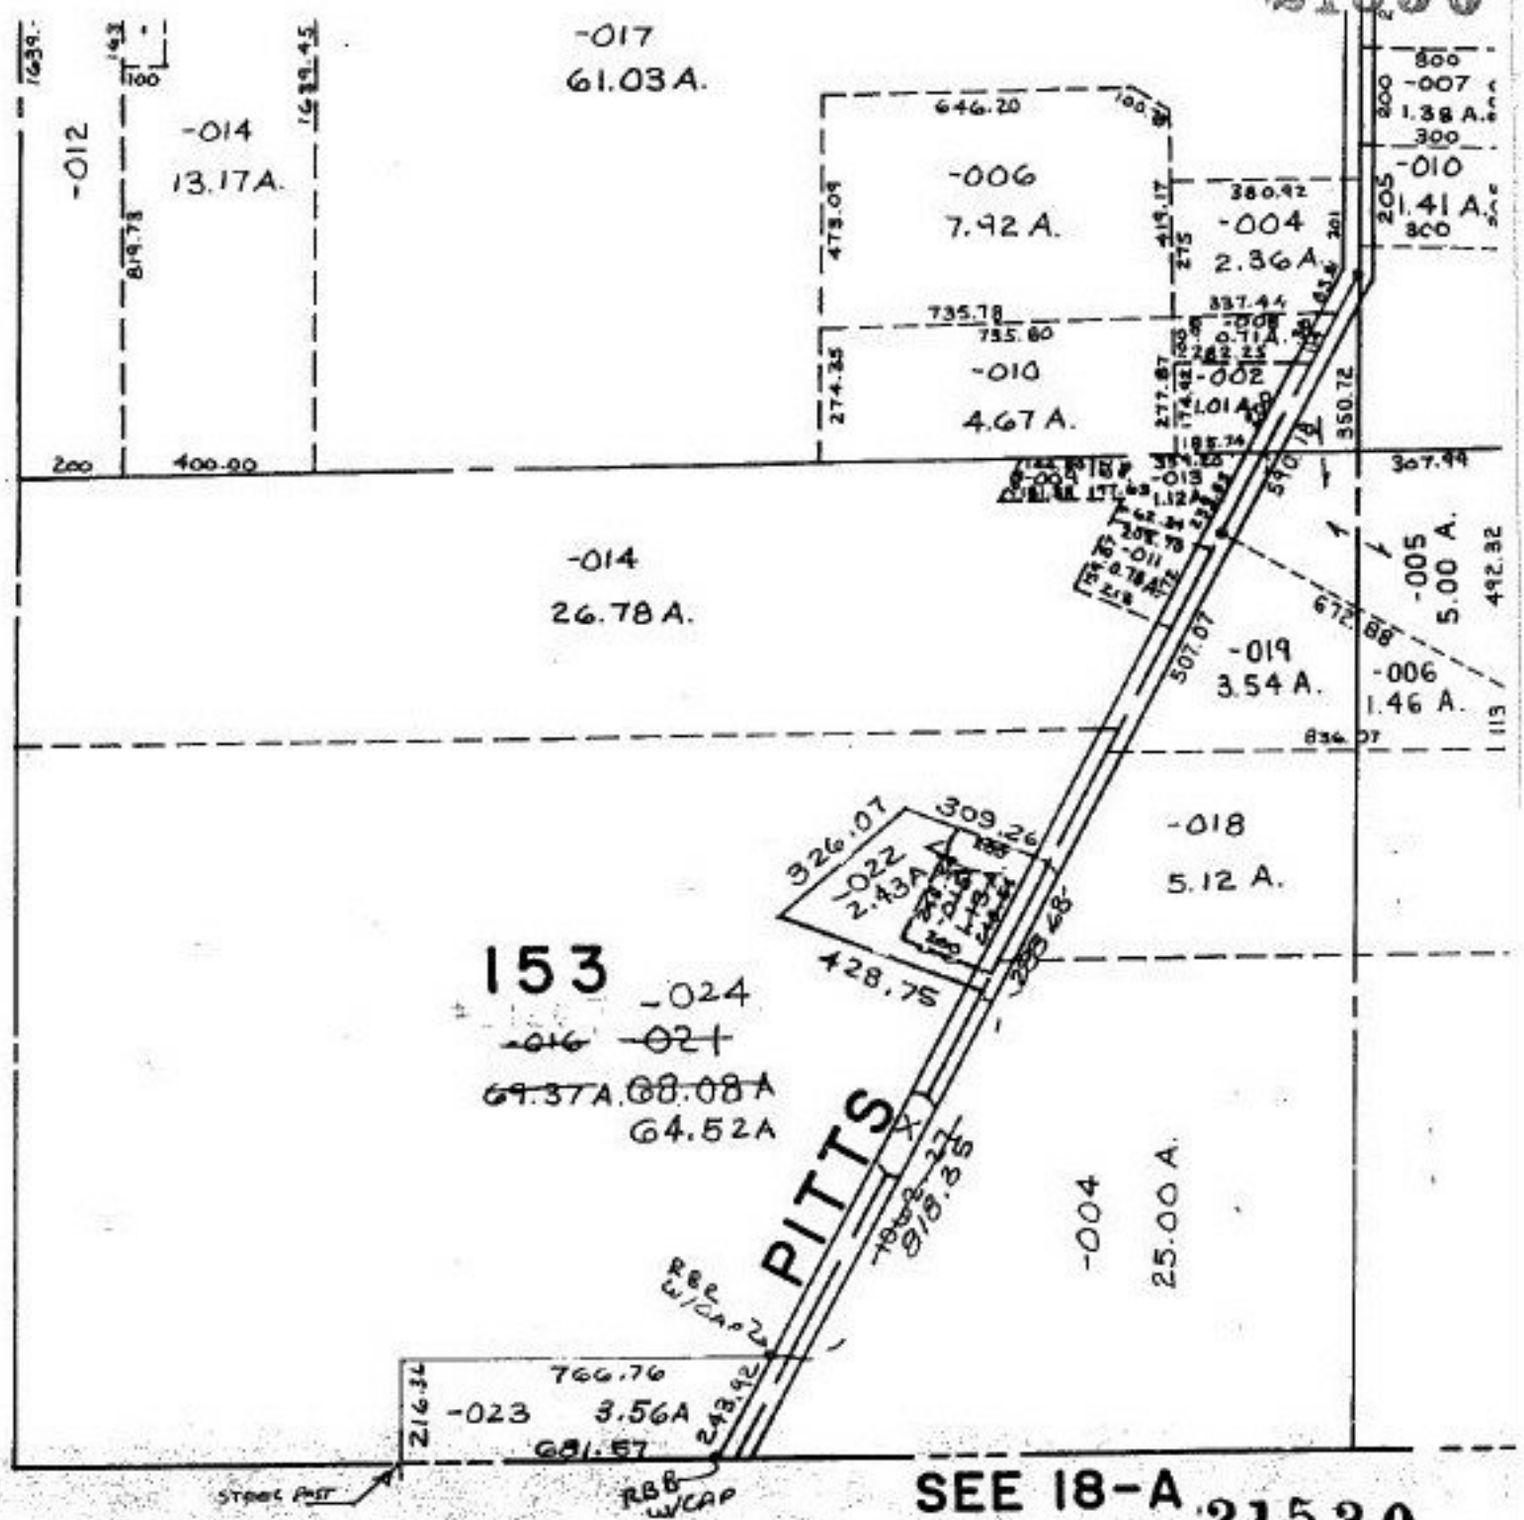

21530

PITTSFIELD

0 400 800 1000

SCALE: 1" = 400'

P.P.NO. 14-00-153-000

PRIOR INST: O.R.671/635 pcl.2
CLOSURE: 0.02:10,000
SURVEYED BY: MICHAEL A. STRAUB P.S.
KS ASSOC.

APPROVED
LORAIN CO.
MAP DEPT
DATE 10-20-95
PAGE 14-F
BY CAROLYN FRANCIS
21530