21531

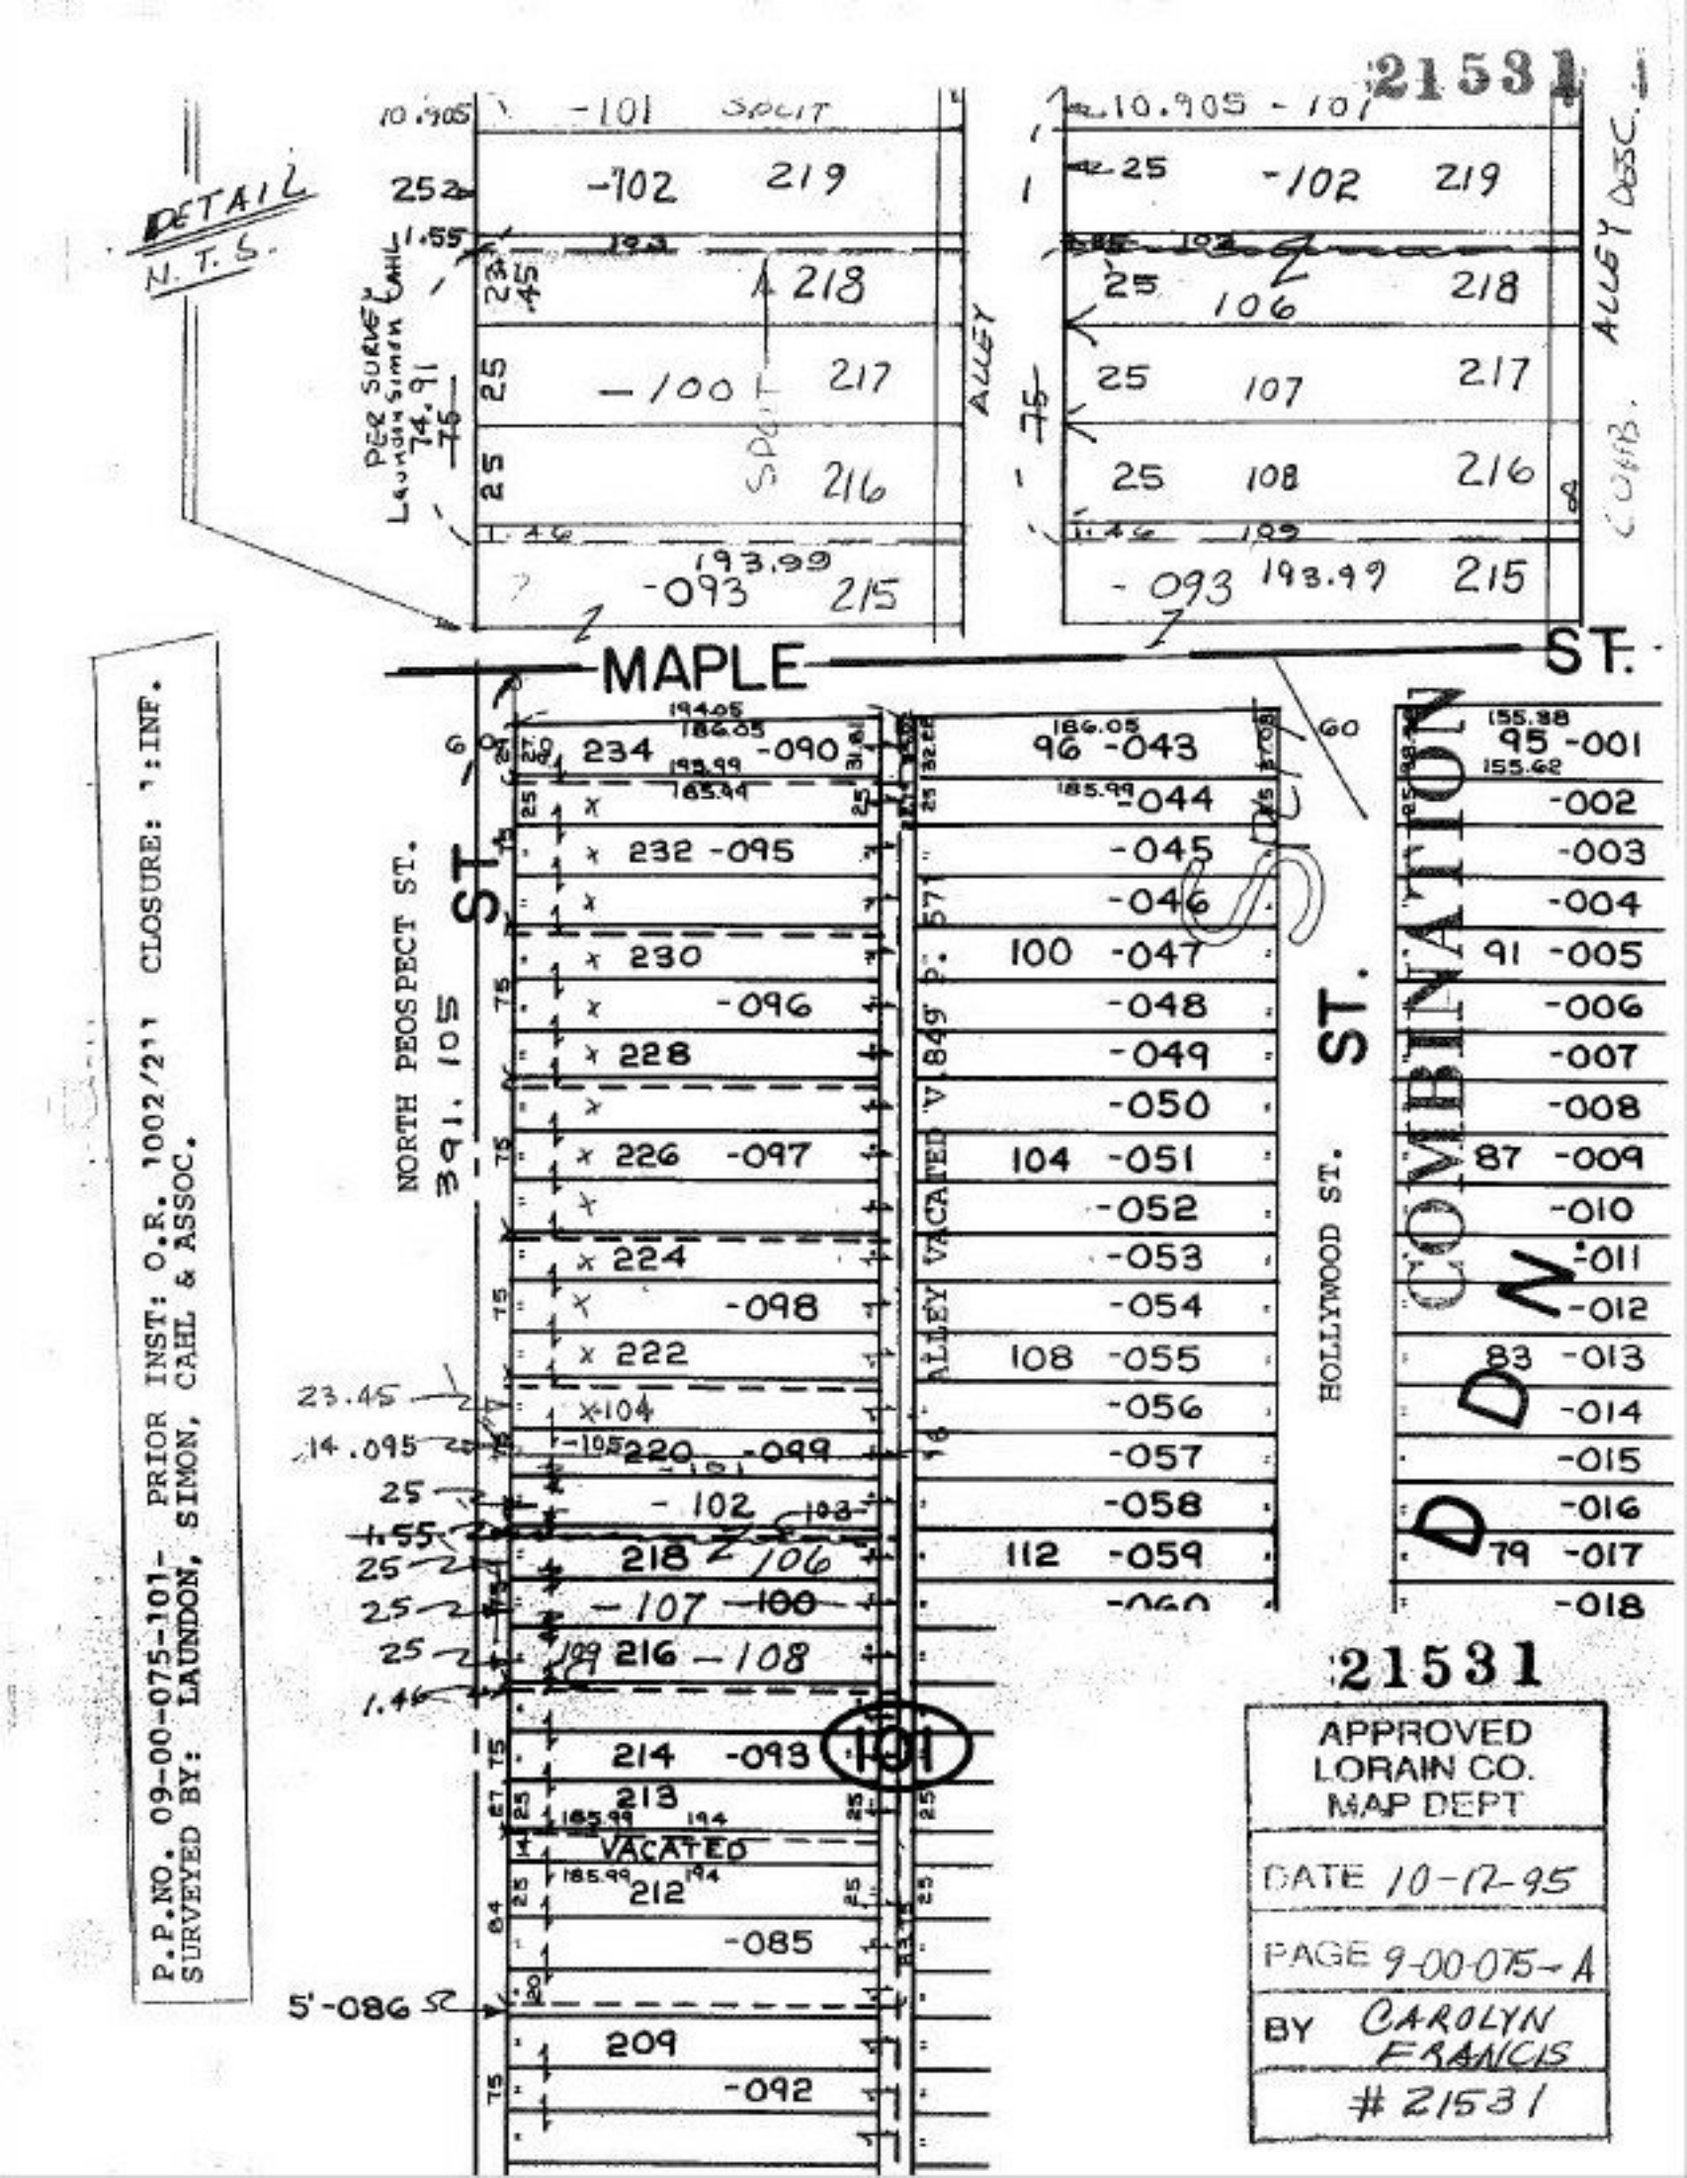

P.P.NO. 09-00-075-101- PRIOR INST: O.R. 1002/211 CLOSURE: 1:INF.
SURVEYED BY: LAUNDON, SIMON, CAHL & ASSOC.

21531

APPROVED
LORAIN CO.
MAP DEPT

DATE 10-12-95

PAGE 9-00-075-A

BY CAROLYN FRANCIS

21531